

19.11.86.


S.S. "Mogul" Glasgow Report No 8194.

S.S. No 134-

Section thro' W. B. Compartment
in After Holds.

8 Frames abaft Engine B.H.

— Scale $\frac{1}{2}$ " = 1 Foot —

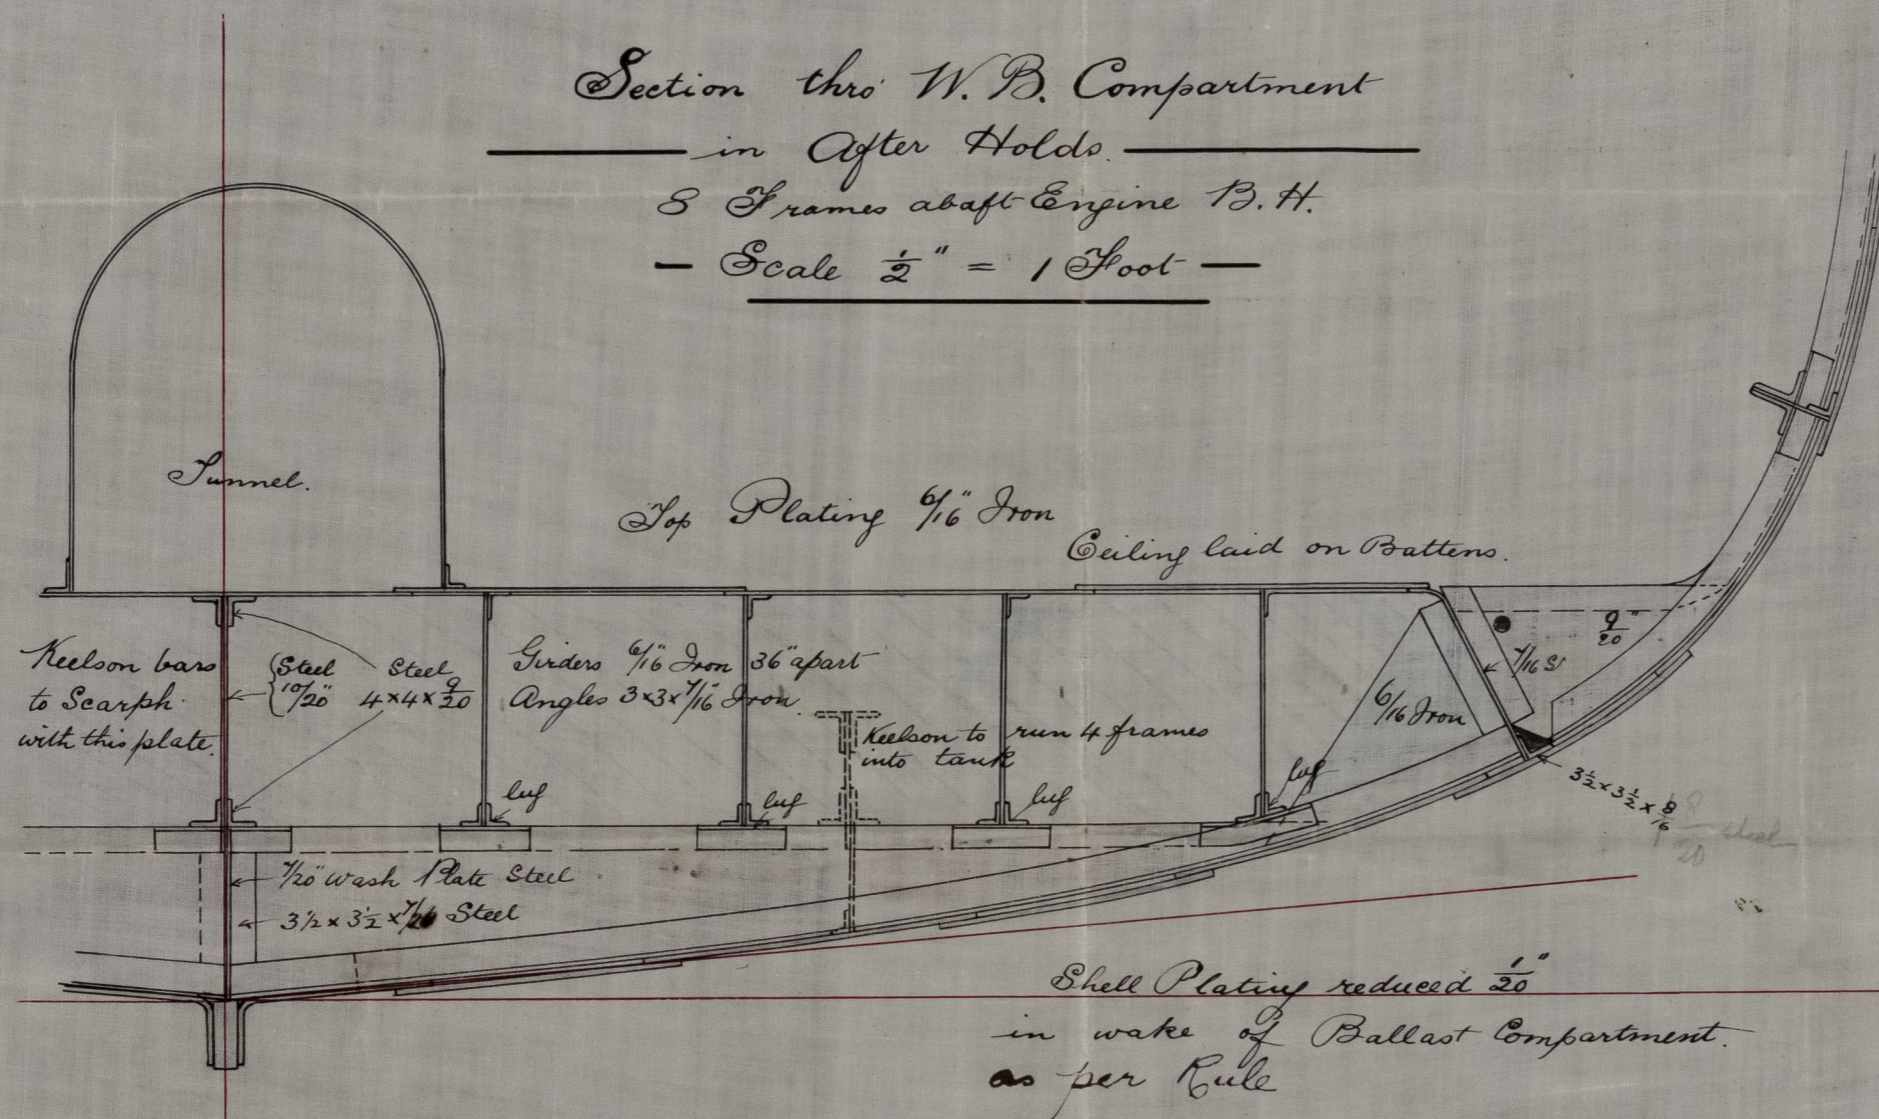


J.H.L.
18/11/86



© 2021



Lloyd's Register
Foundation

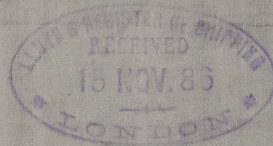

28.11.85


2.2.134

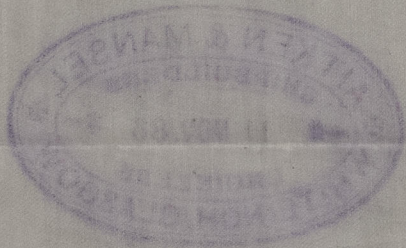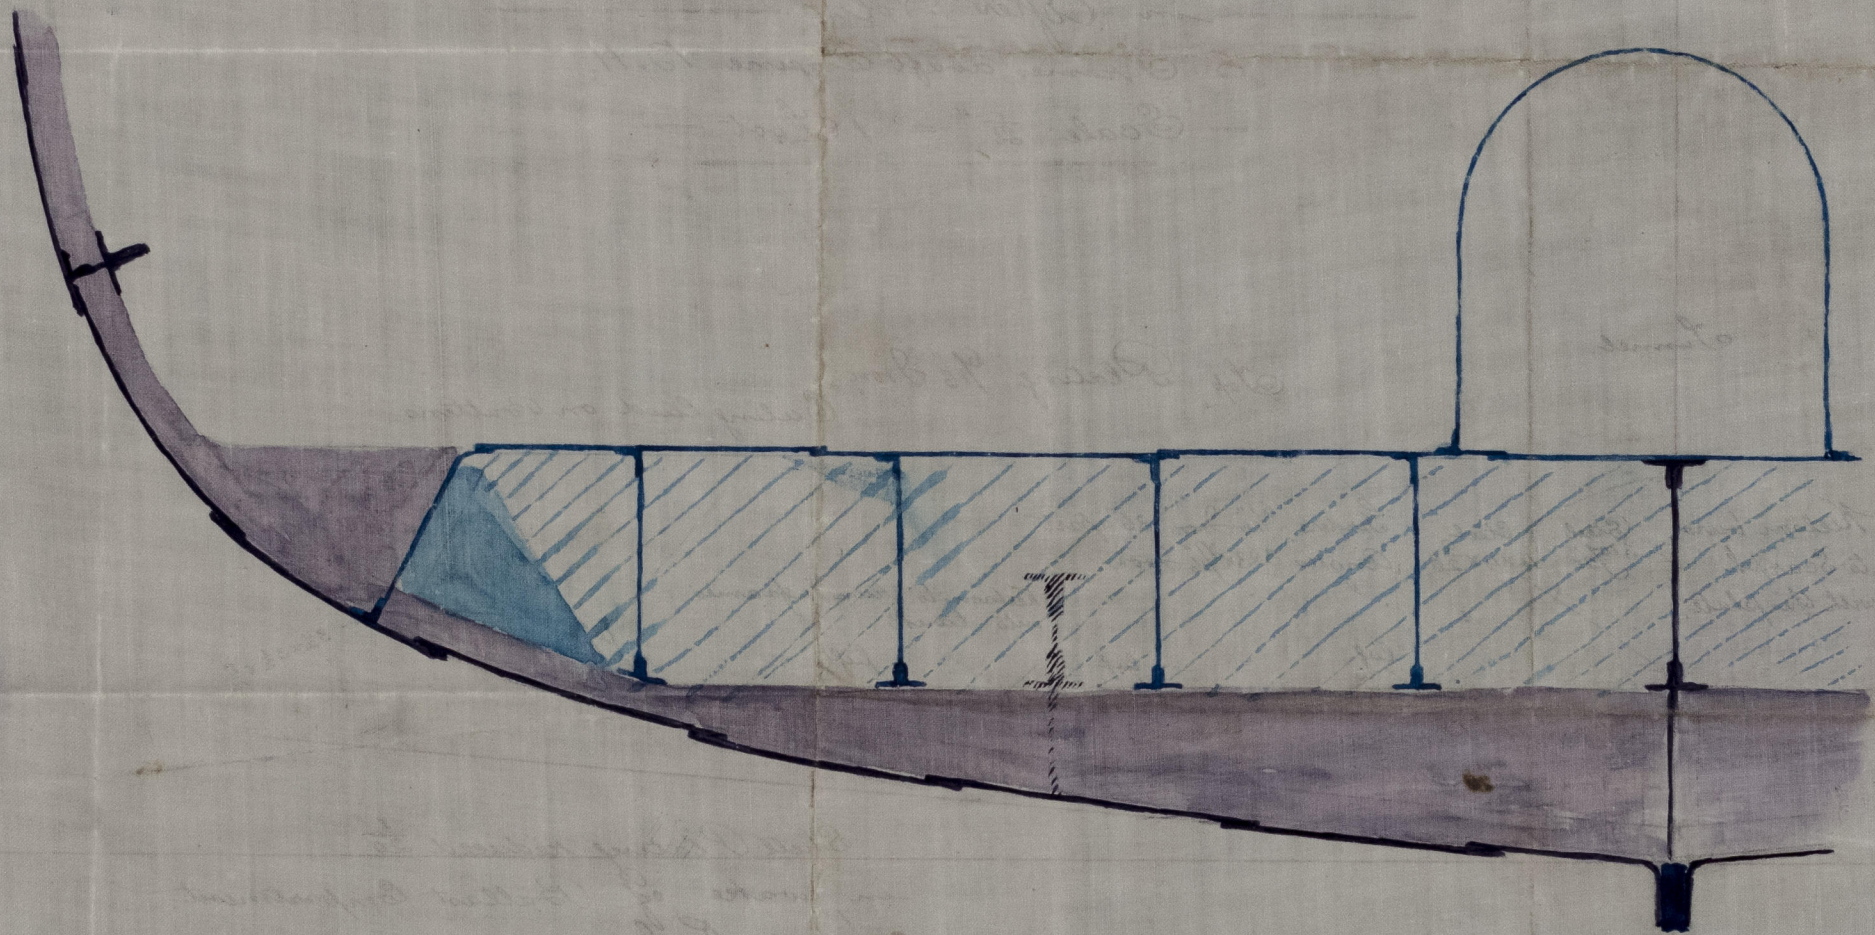

28/11/85



© 2021

Lloyd's Register Foundation