

Lloyd's Register of British and Foreign Shipping.

(Report on Vessel No. 8194 Port Glasgow)

"Mogul"

No. 1362

SHIP FORGINGS OR CASTINGS.

I have to report that the undermentioned Iron ~~or Steel~~ Forgings ~~or Castings~~, manufactured by The Lancefield Forge Co. of Glasgow, for the Vessel No. 134, being built by Messrs Aitkin & Mansel of Glasgow, have been inspected by me as set forth below, and found to be, so far as can be seen, sound and efficient.

The words FORGINGS or CASTINGS, IRON or STEEL, should be struck out as may be required.

Mark on Forgings.


Lloyd's
No. 1362
G. N.

George Newcomb.
Glasgow

10/8/87.

	STERN FRAME.	RUDDER FRAME.	STEM.
Material*	/	Scrap iron.	/
How made	/	Forged.	/
Dimensions	/	8 1/2 & 3 1/4 dia	/
Progress on Inspection	/	Forging & smithing	/
Dates when Inspected	/	2.4.11.17.21.28/5/87. 13.17.22.25.28.30/6/87. 4.5/7/87.	/

SKETCHES OF FRAMES SHEWING POSITION AND DESCRIPTION OF WELDS OF FORGINGS, OR PARTICULARS OF TESTS APPLIED TO CASTINGS.

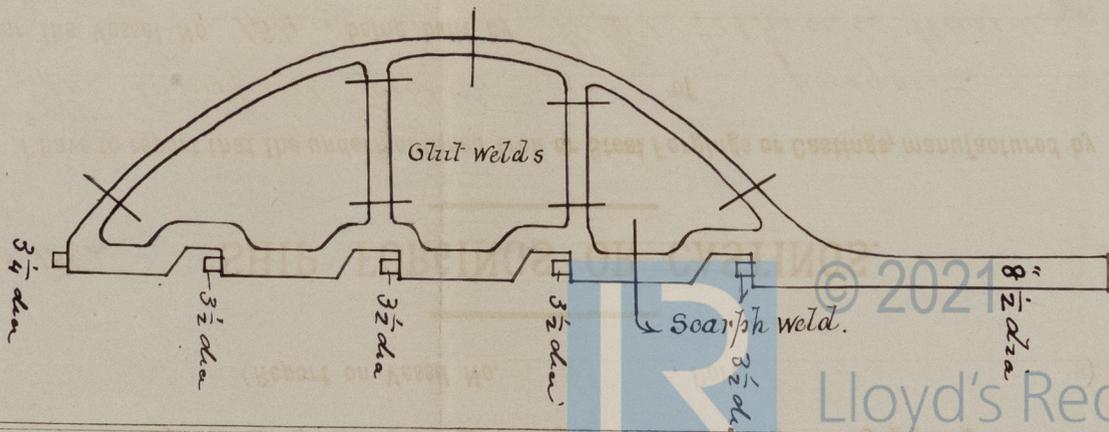

* If of Iron, state whether scrap or puddled iron.