


18/1/87.

S. S. "Mogul" Glasgow Report No. 8194. —

— S.S. No. 134. —

— SCALE $\frac{1}{8}$ " = ONE FOOT. —

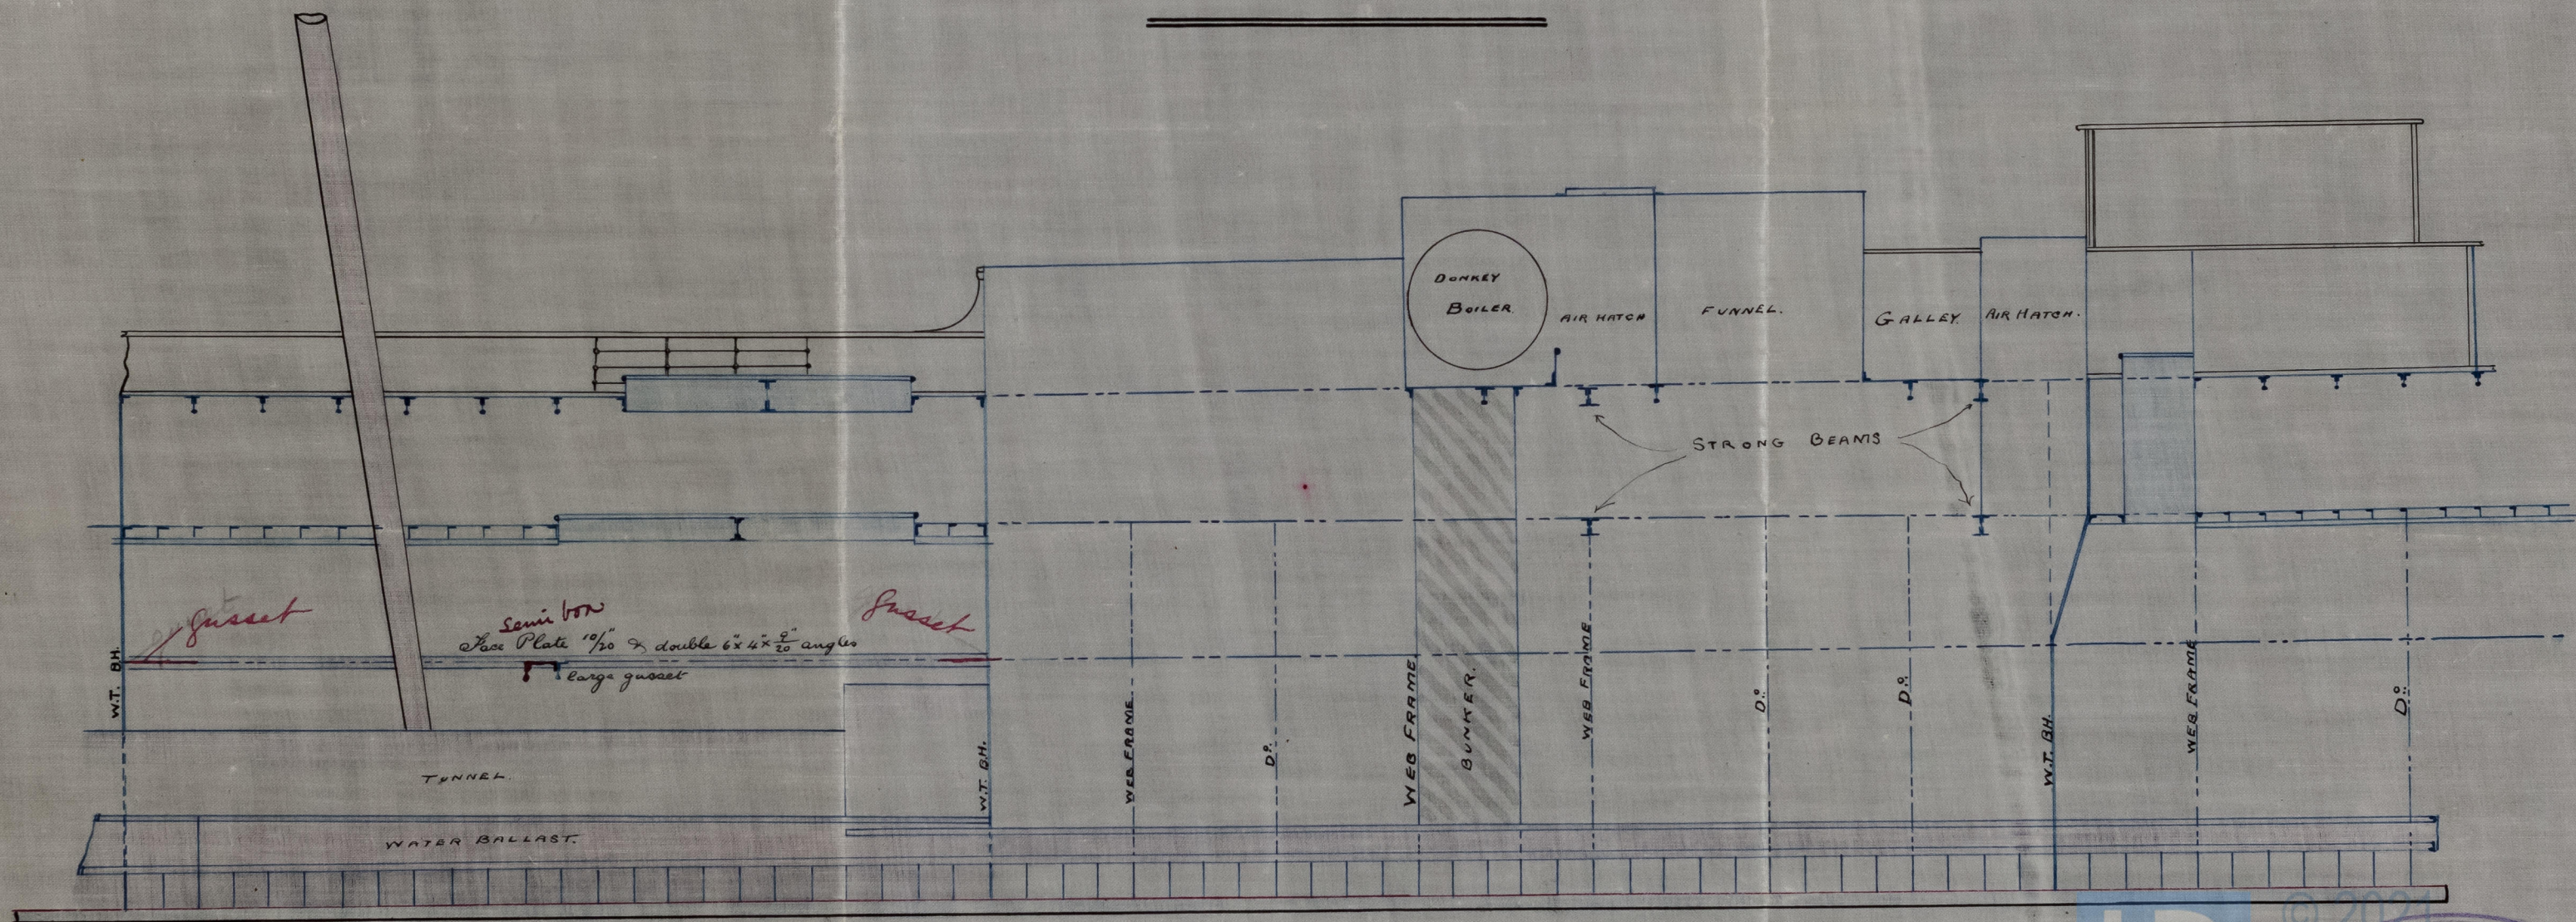

GLS 207-0176