

dk. 19/5/87

— N<sup>o</sup> 134 —

— S.S. "MOGUL" —

— PLAN OF ARRANGEMENT —


— OF PUMPS —

SCALE  $\frac{1}{16}$ " = 1 FOOT

S.S. "Mogul" Glasgow Report N<sup>o</sup> 8194. —



M  
19.5.87

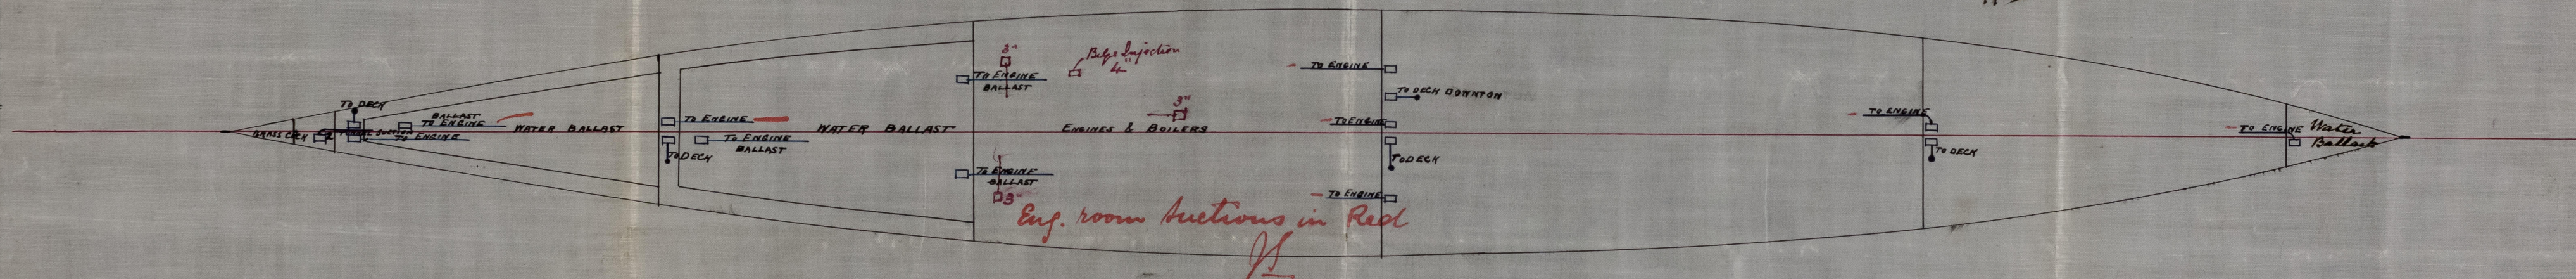

NOTE. Brass Sluices on all Bulkheads





Lloyd's Register  
Foundation

GLS 207-010



new Report No 8194.

18/2/11. J.L.

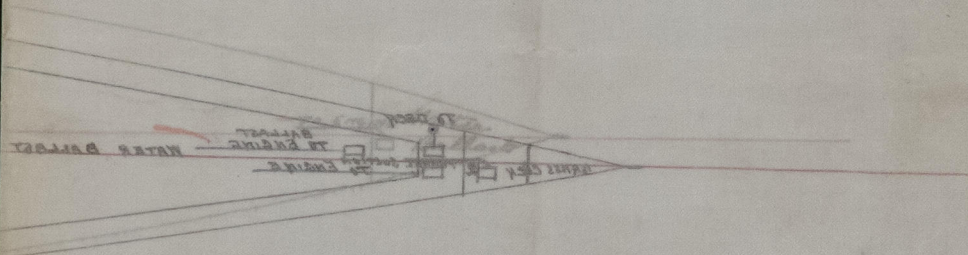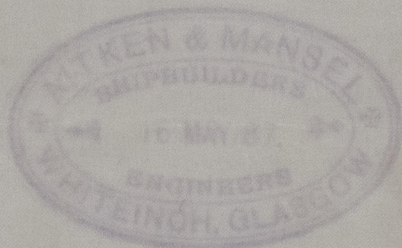

LE10-102574

NOTE. Brass Sluces on all bulkheads



© 2021

Lloyd's Register  
Foundation

