



09  
J. L. 16/11/87

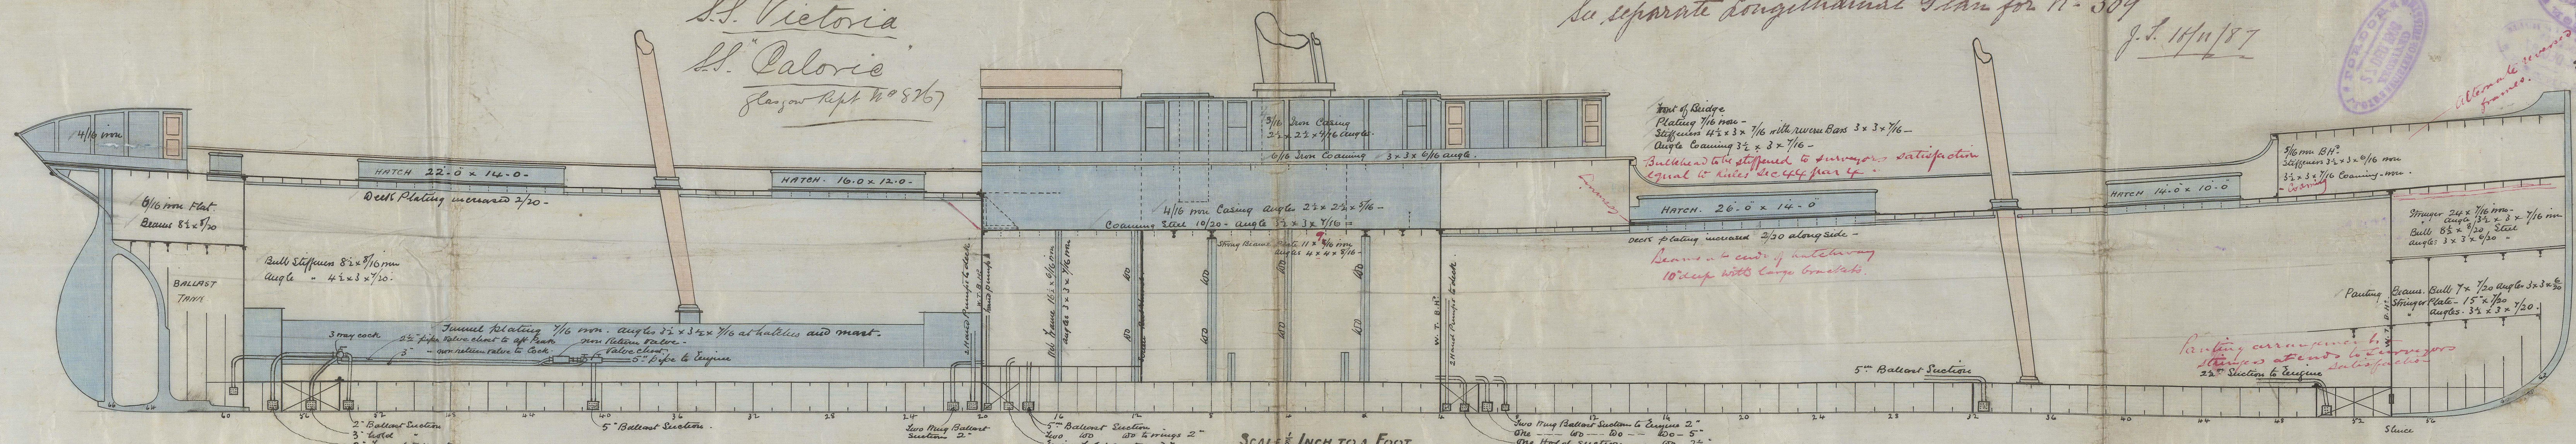

— STEEL SCREW STEAMER No 307 *309*  
*To Class. 100 A.1 at Lloyd's.*

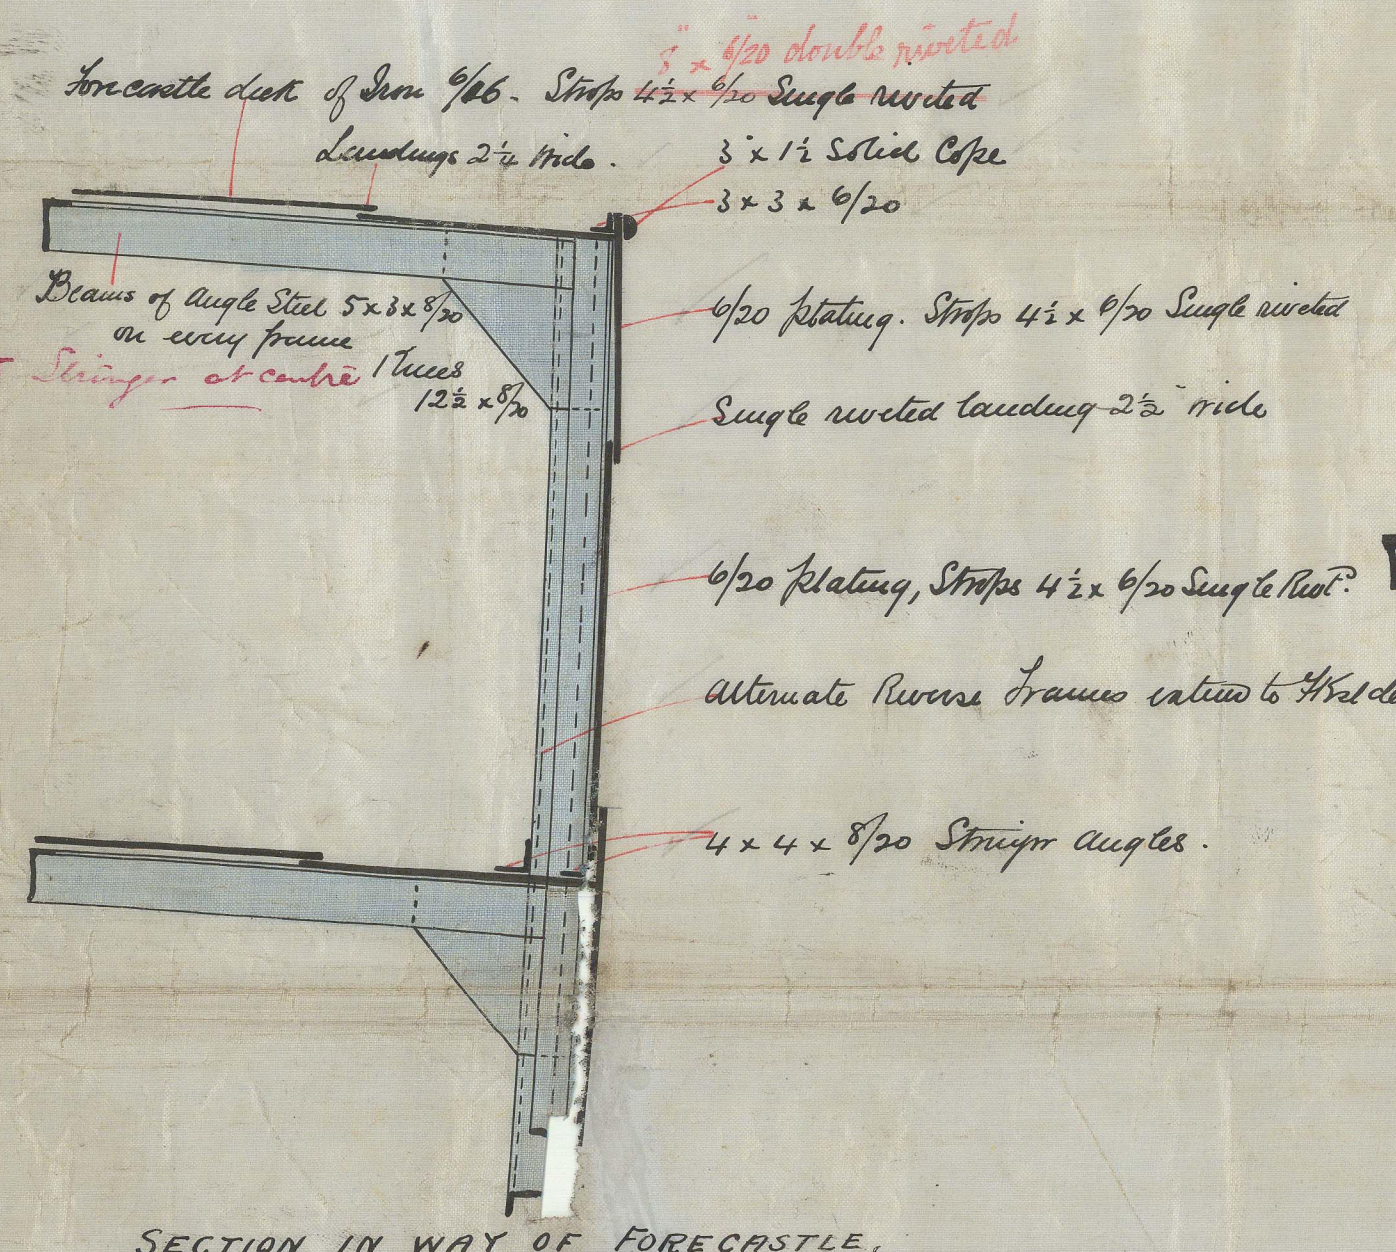

<u>Dimensions.</u>	<u>FEET.</u>
Half Moulded Breadth .....	16.29
Depth from Top of Keel .....	19.87
Half Midship Girth .....	33.84
Length on for Rule .....	258.58


Numerals.


Proportions 20642 do

$258.58 \div 19.87 = 13.01$  Depth to Main chert.

$100 \div 36.58 = 2.73$  moulded Breadth.

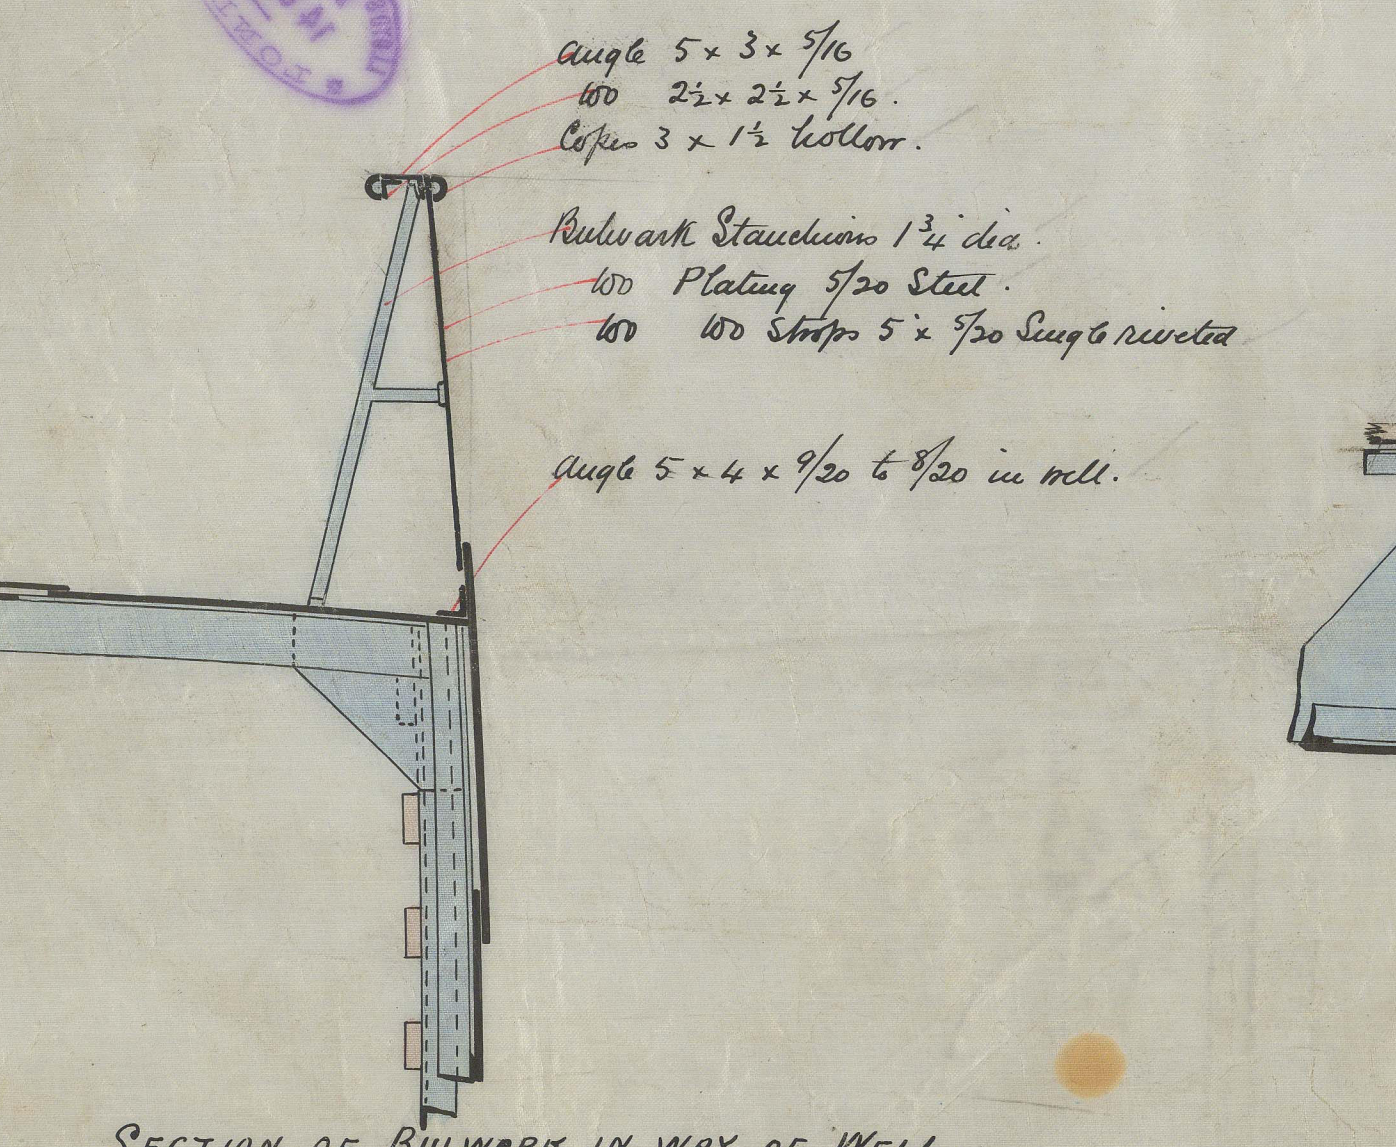


SECTION IN WAY OF RAISED QUARTER DECK.  
SHOWING INTERMEDIATE FRAMES ON WHICH NO BRACKETS OCCUR.

SCALE  $\frac{1}{2}$  INCH TO A FOOT

Rail of Elm & Oak 8 x 3  
 100 Augs. 5. 22 x 9/20  
 Bulwark of iron 4/6. Strops 5" x 4/6 Single riveted.  
 10/20 in mwy of Breast of Cavalier deck. - see other Section.  
 Bulwark Stanchions 1 1/2 dia.  
 Stringer Plates. 16 1/2 x 10/20 1/2 x 6 30 x 9/20 double riveted  
 100 Butt Strops 1 1/2 x 7 3/4 mwy double riveted 1/2 x rivet. 9/2 x 7/2  
 Side Plating of R.O.D. 10/20 to 1/2 at end. 4/20 in mwy of Breast.  
 100. Strops see other section -  
 Double riveted Landing 5 1/2 wide in mwy of R.O.D  
 Sheerstrake doubled in mwy of Breast, with 10/20 plating, 1/2 at 3/4  
 Breast Plate. 4/20 top to 1/2 at bottom, between angles, 1/2  
 100. Augs. 5 x 4 1/2 1/2 x 1/2 1/2 wide 9/20  
 100. Interstitial Augs 3 1/2 x 3 x 1/20.

Slip iron - and the rivets to be of iron - Other  
Material on these sections includes three other-  
wise specified to be of steel -


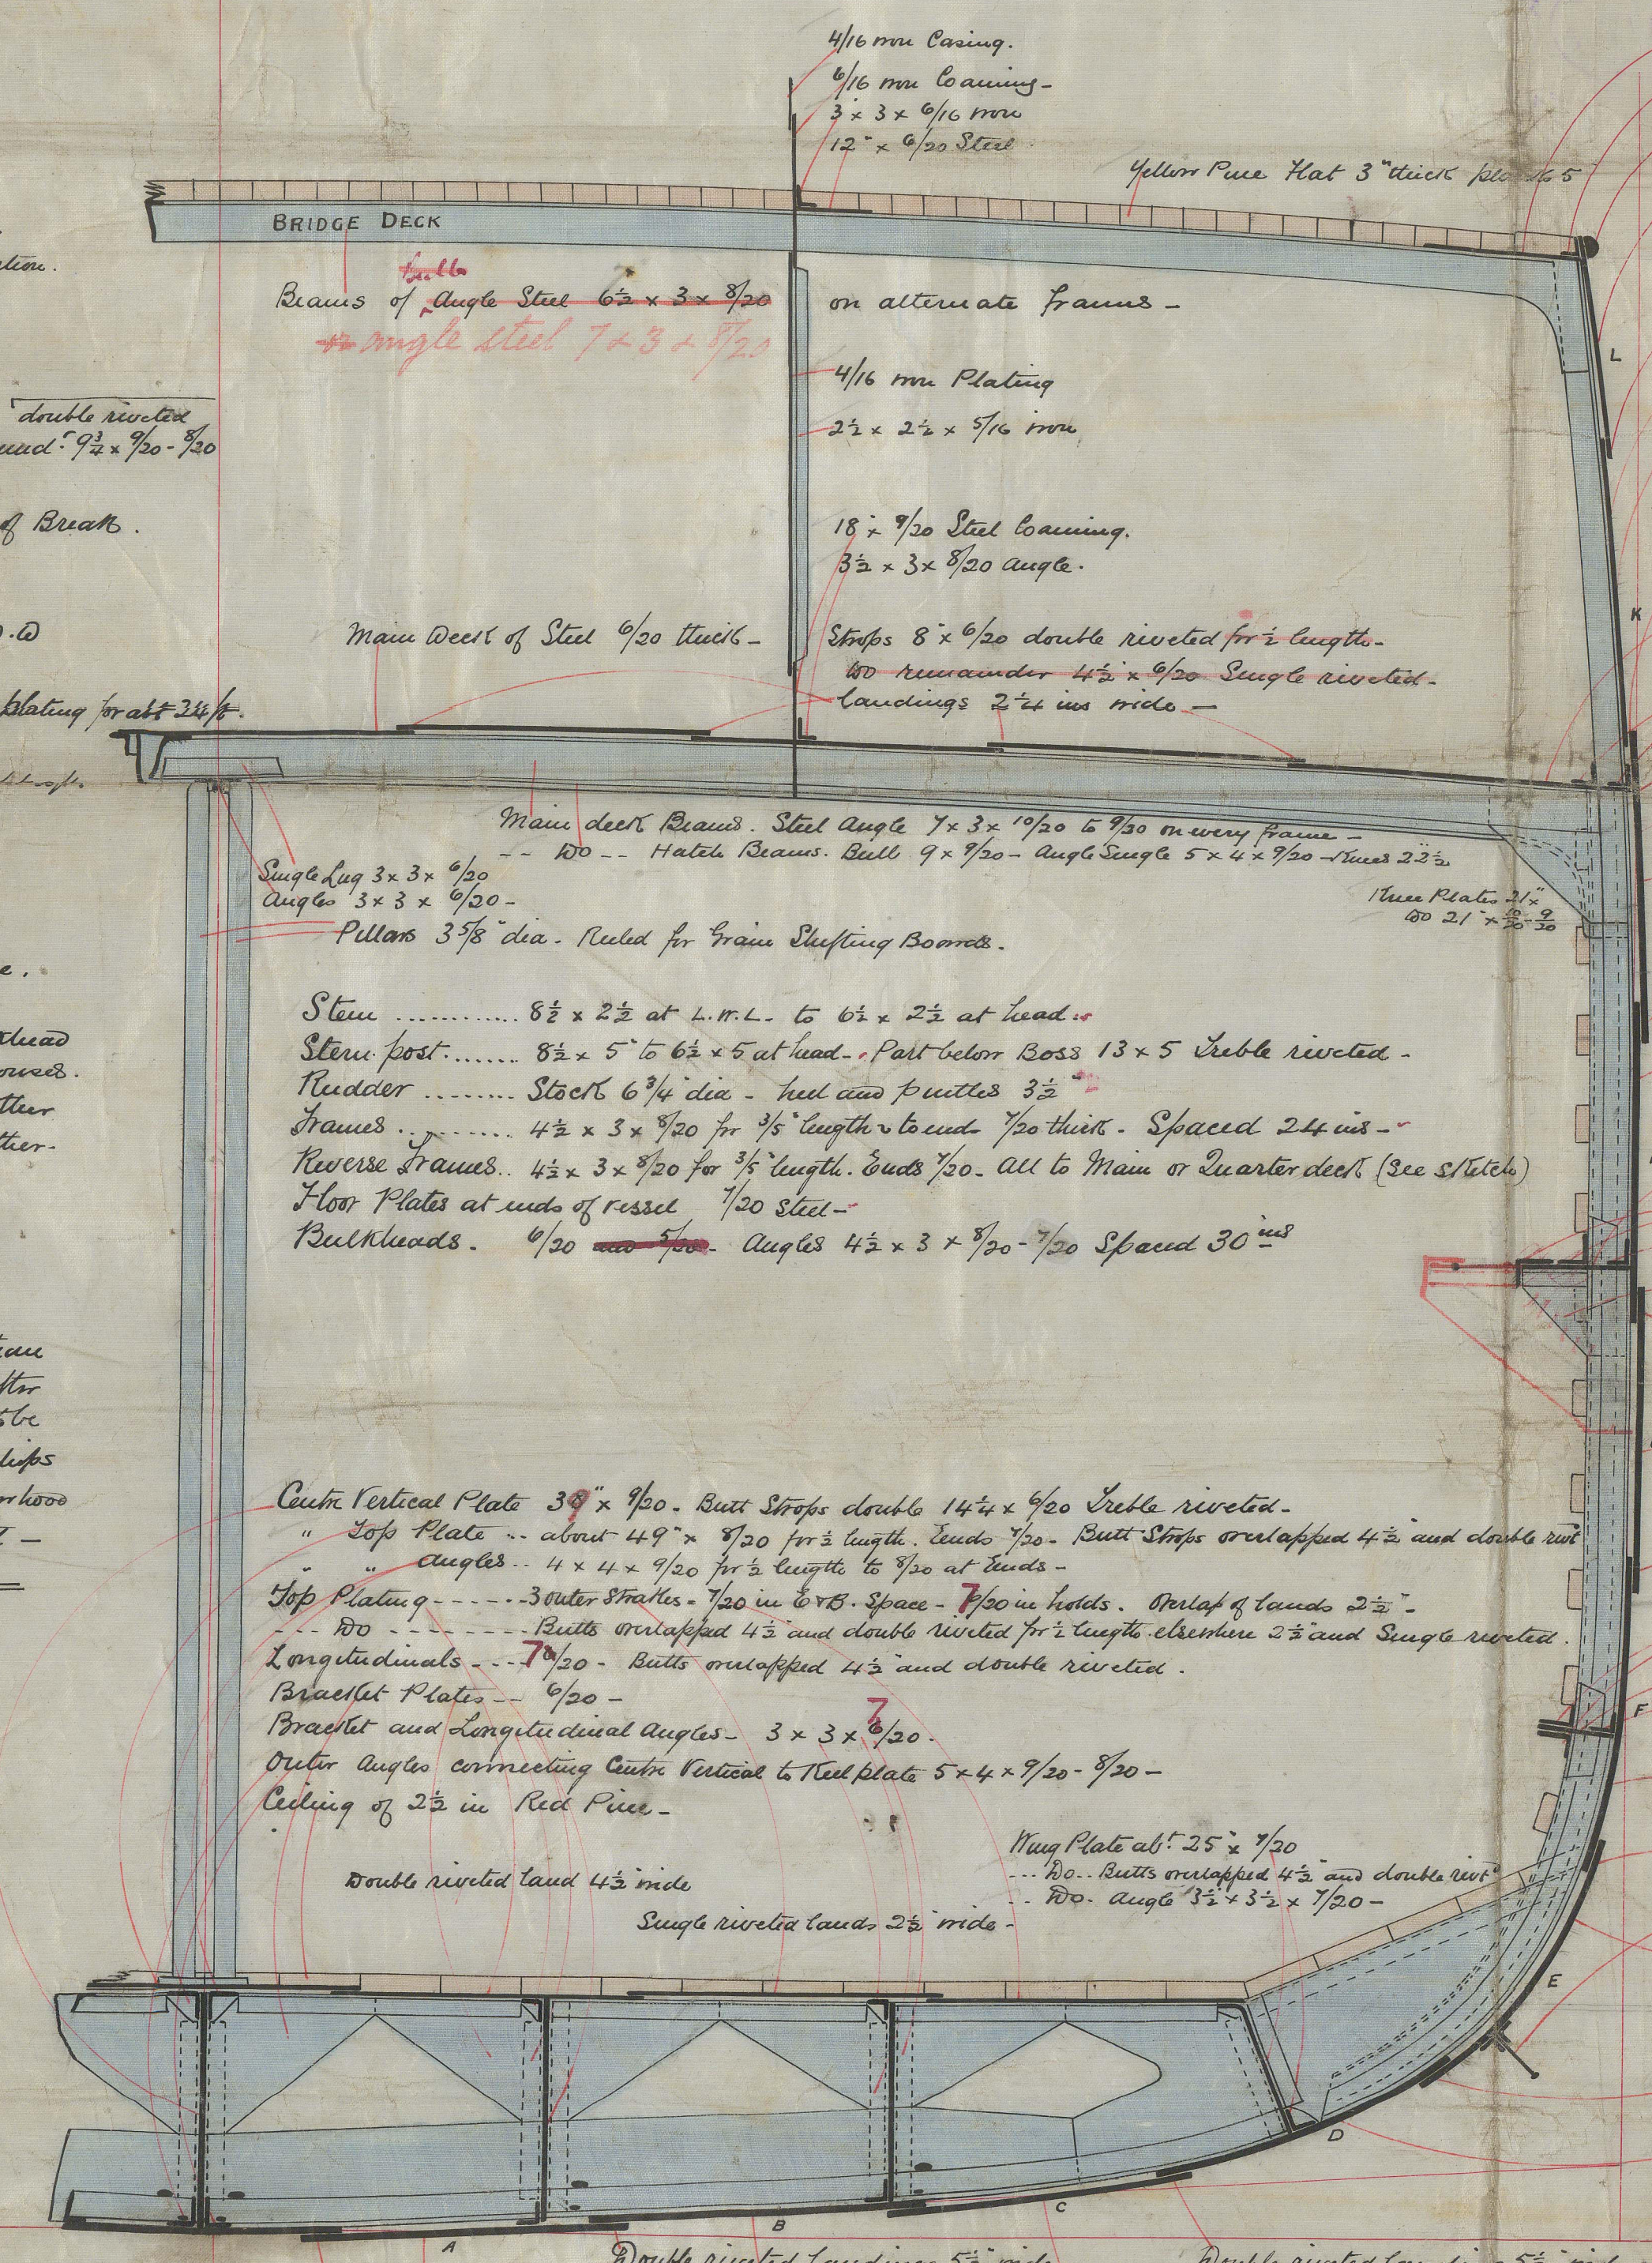

Struger Plate 24" x 70" Bull Strips 7 1/2" x 70" Double riveted.  
 .. No .. angles 3 x 3 x 7/20  
 Soldered Caps .... 3" x 1 1/2"  
  
 Sides of Bridge 7/20 - increased to 1/20 in way of Break of 2 D.  
 .. No .. Bull Strips 14 1/2" x 7/20 - 7/20 Sails riveted -  
  
 Single riveted landing 2 1/2" wide  
  
 7/20 in way of Bridge. 7/20 in way of Wheel. 7/20 in way of rails. Strips 2 1/2" x 7/20 in way of that Single riveted.  
 7/20 in way of R.O. increased to 7/20 at Break, and to 7/20 in way of front of Bridge. 100 5" x 7/20 - " Well 100 100  
 100 9 1/2" x 7/20 - " Bridge double riveted  
 100 5 1/2" x 7/20 - " R.O. 100 - 100 100  
 100 in way of Break, 10 1/2" x 7/20 Sails riveted -  
  
 Single riveted landing in way of Bridge. Wheel Well 2 1/2" wide  
 Double - 100 - 100 - in way of Round Quarter deck 5" wide  
  
 Struger Plate 5 1/2" x 7/20 for 1/2 length to 30 x 7/20 at ends  
 .. No .. Bull Strips 14 1/2" x 7/20 and rails riveted for 1/2 length, remainder 9 1/2" x 7/20 double riveted.  
 .. No .. angles - in way of Bridge 4 x 4 x 7/20 - in well 5 x 4 x 7/20 - 7/20 - Wheel 4 x 4 x 7/20 -  
  
 Short-trail about 50" x 7/20 for 1/2 length, thence 14/20 to 7/20 at ends.  
 .. No .. Double for about 2 1/2 feet at Rear of Quarter deck, with 100 plate  
 .. No .. increased to 7/20 from about 10 ft. ahead of front of Bridge to the half length increased -  
 .. No .. Bull Strips about 2 1/2" x 7/20 and rails riveted for 1/2 length - remainder 11 1/2" x 5 1/2" x 7/20 double  
 .. No .. 100 - in way of the 7/20 plating to be double strips curve - 30 - 3 1/2" x 7/20 double riveted -  
  
 Double riveted landing 6 ins wide.  
  
 about 50 1/2" x 7/20 for 1/2 length to 7/20 at ends.  
 .. No .. Bull Strips 16 1/2" x 7/20 and rails riveted for 1/2 length, remainder 9 1/2" x 7/20 - 7/20 double riveted  
  
 Side Under plate 16 1/2" x 7/20 for 1/2 length to 7/20 at ends.  
 .. No .. angles 5 x 4 x 7/20 for 1/2 length and 7/20 -  
 .. No .. uncostal angle 3 1/2 x 3 x 7/20 -  
 .. No .. 10 rivets in way 4 ft. from plate 7/20 - angle 3 x 3 x 7/20.  
  
 Double riveted landing 5 1/2 ins wide -  
  
 about 48 1/2" x 7/20 for 1/2 length to 7/20 at ends.  
 .. No .. Bull Strips 16 1/2" x 7/20 and rails riveted for 1/2 length, remainder 9 1/2" x 7/20 - 7/20 double riveted.  
  
 Double riveted landing 5 1/2 ins wide -  
  
 Nelson angles 5 x 4 x 7/20 for 1/2 length ends 7/20 -  
 100 Plate - 11 1/2 x 7/20 - 3/4 length - " 7/20 -  
 100 uncostal angles 3 1/2 x 3 x 7/20.  
  
 about 50 1/2" x 7/20 for 1/2 length to 7/20 at ends. Bull Strips 16 1/2" x 7/20 Sails riveted for 1/2 length. Remainder 9 1/2" x 7/20  
  
 Double riveted landing 5 1/2 ins wide.  
  
 Bulge Rails for about 60 ft. amidships. Bull 10" x 7/20 Angles 3 1/2 x 3 x 7/20.  
 about 50 1/2" x 7/20 for 1/2 length to 7/20 at ends. Bull Strips 16 1/2" x 7/20 Sails riveted for 1/2 length. Rem 9 1/2" x 7/20 - 7/20  
  
 Double riveted landing 5 1/2 ins wide -  
  
 about 49 1/2" x 7/20 for 1/2 length to 7/20 at ends. Bull Strips 16 1/2" x 7/20 Sails riveted for 1/2 length. Rem 9 1/2" x 7/20 - 7/20

Alex<sup>r</sup>. Stephen & Sons  
SHIPBUILDERS & ENGINEERS  
GLASGOW

DRAWING No.


SCALE 1/2 INCH TO A FOOT

1806  
24/3/87  
©2021  
Lloyd's Register  
Foundation



24.3.87.

Steel Screw Steamer No 307

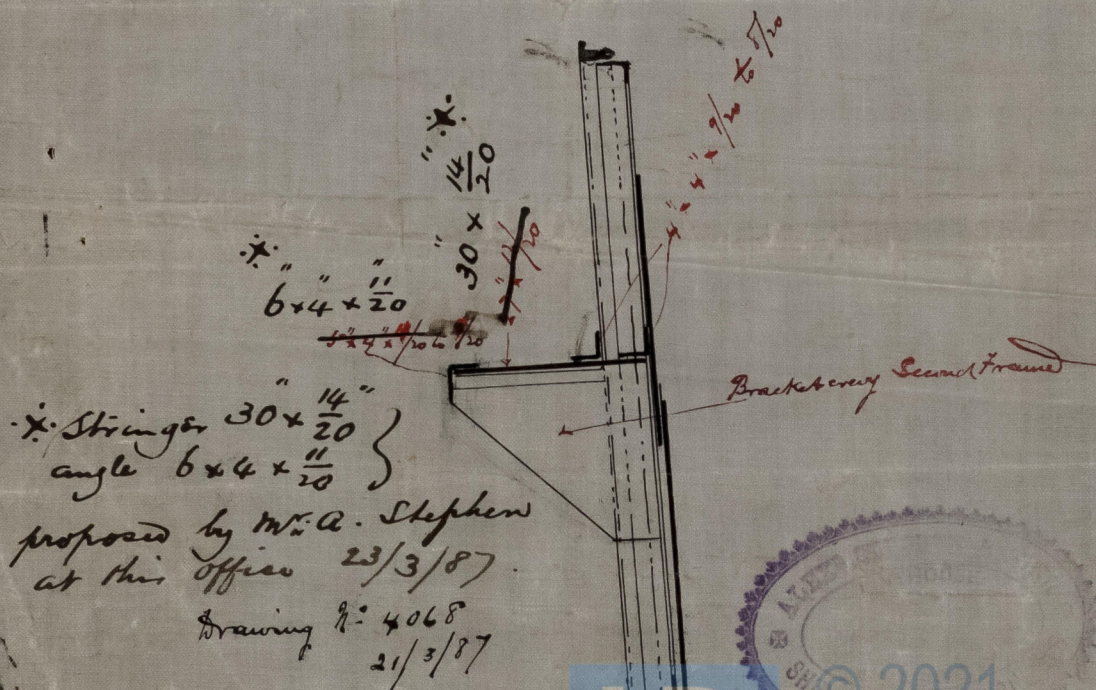

Lloyd's Register  
Foundation

GLS207-0197 2/2







EXTRACT OF THE

Lloyd's Register  
Foundation





© 2021  
Lloyd's Register  
Foundation