
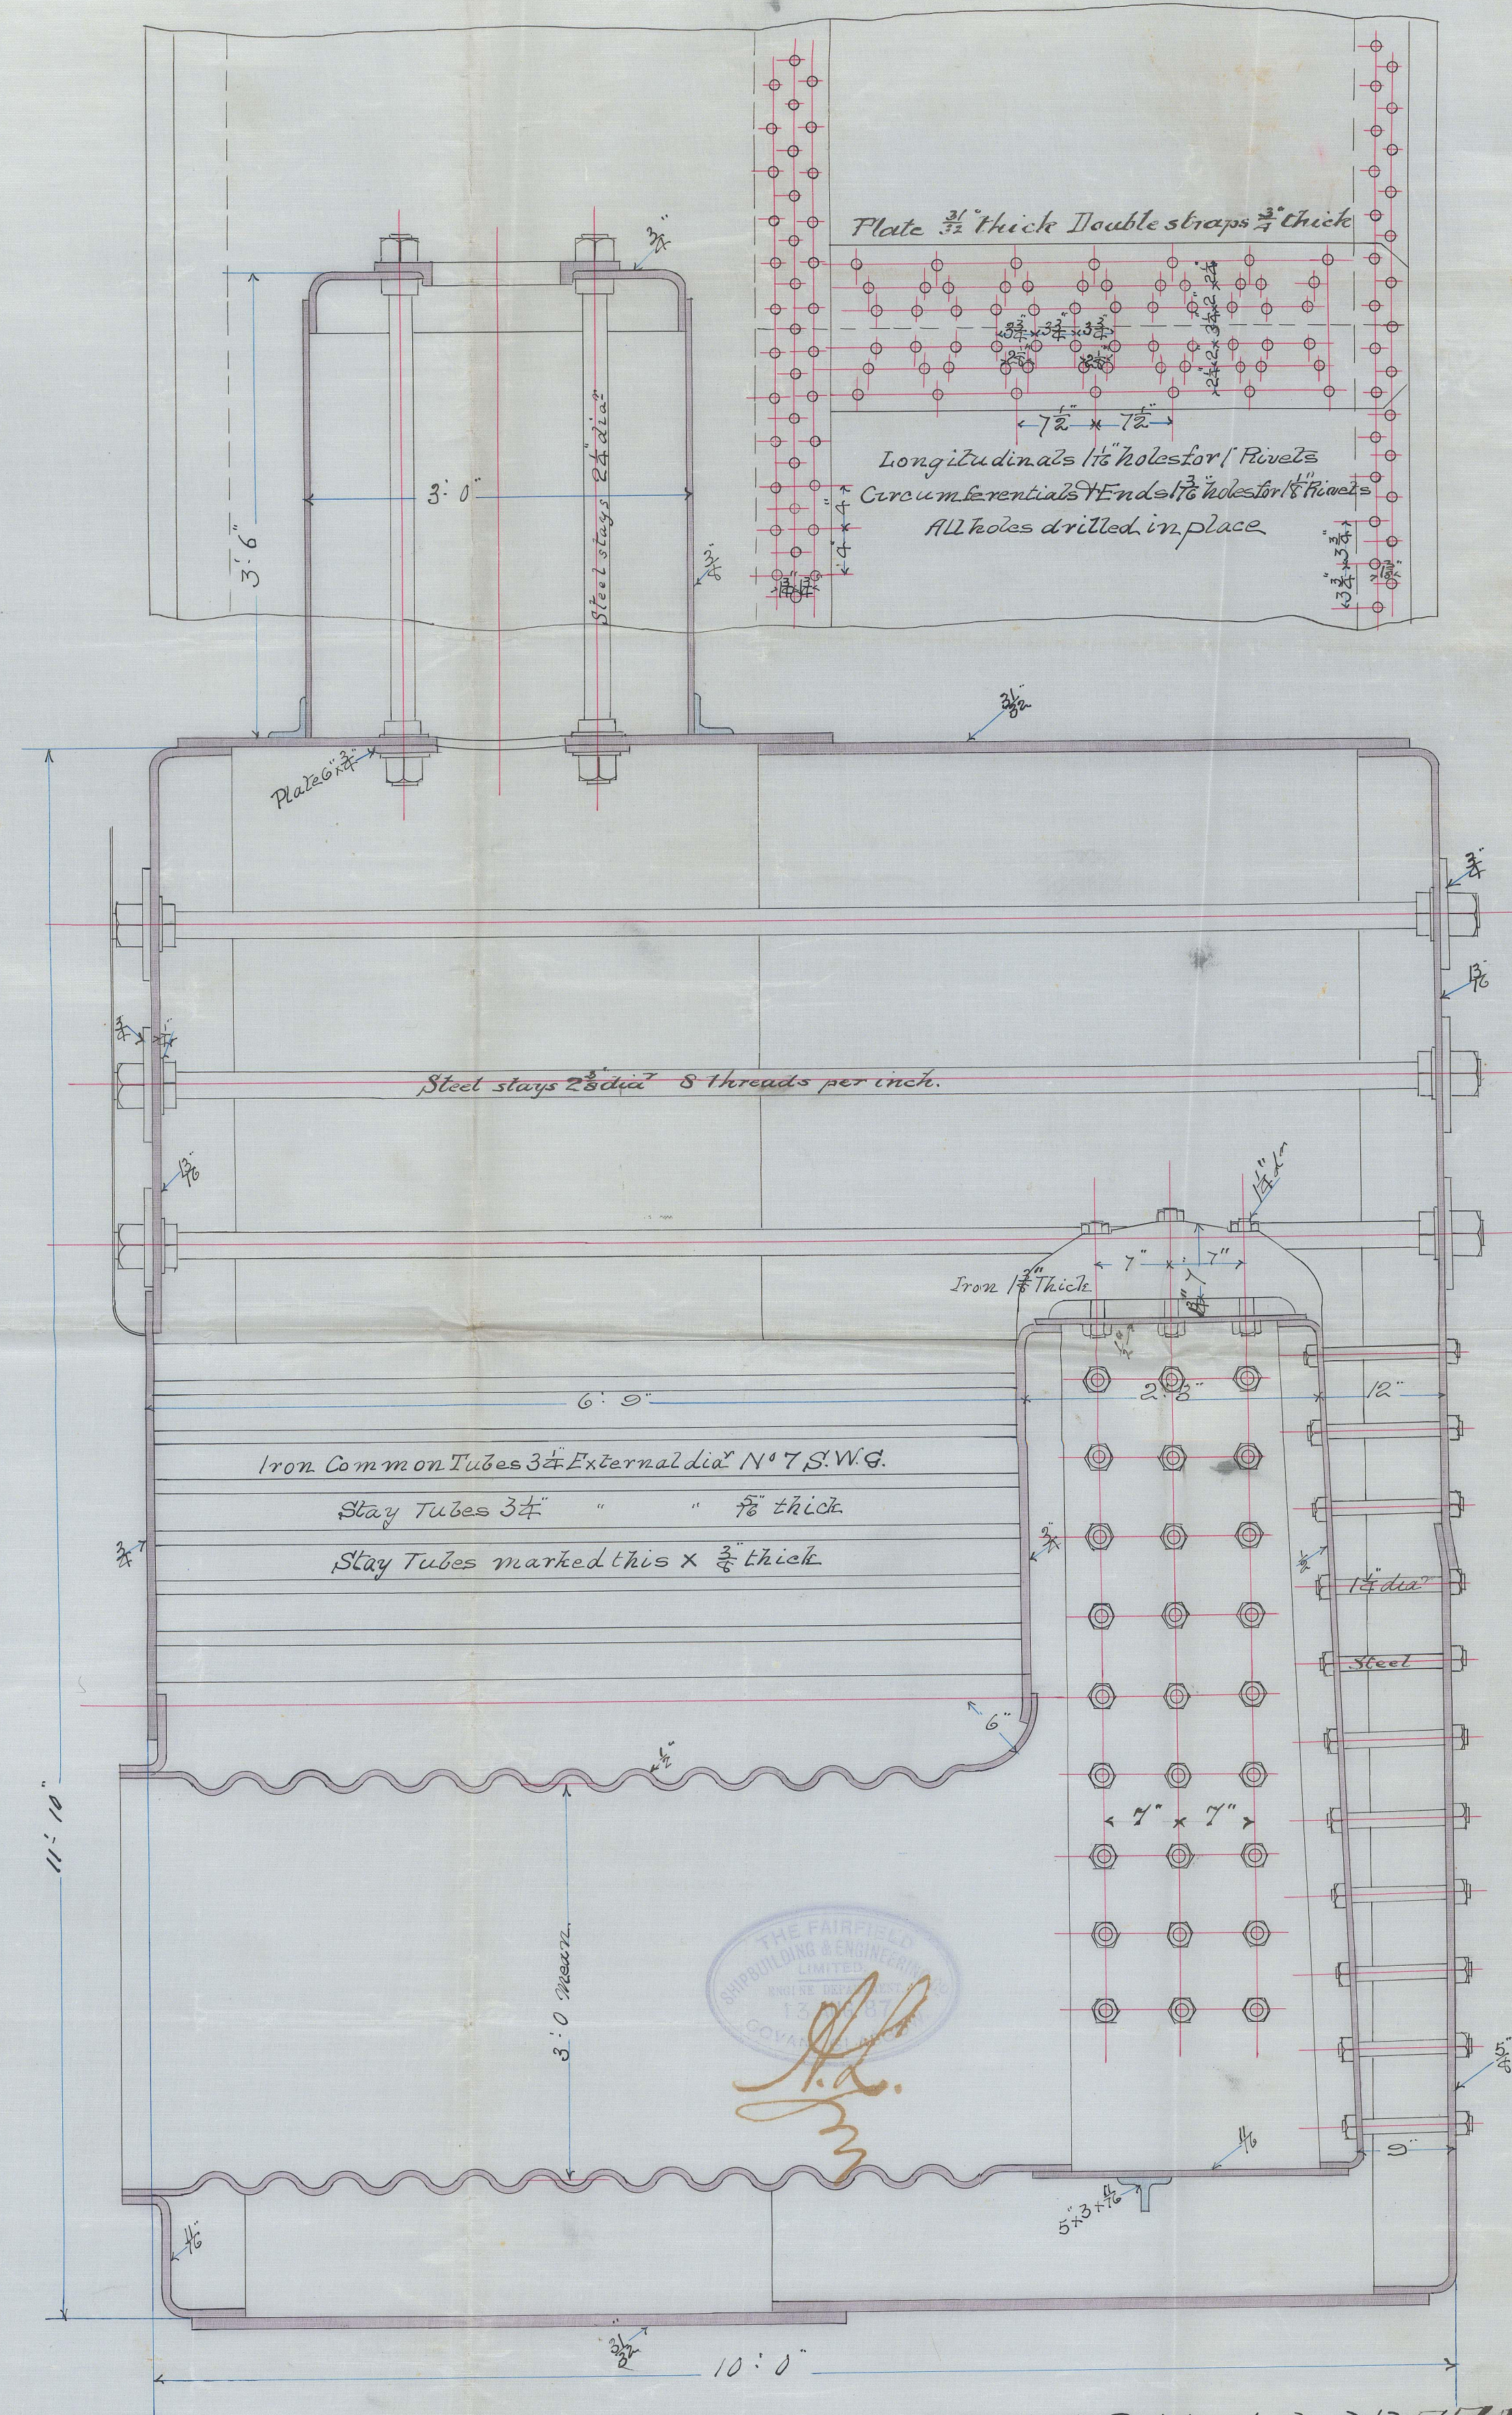


S.S. "Clyde"
Glasgow Report
No 8331.

No dome was
fitted to boiler No. 7488

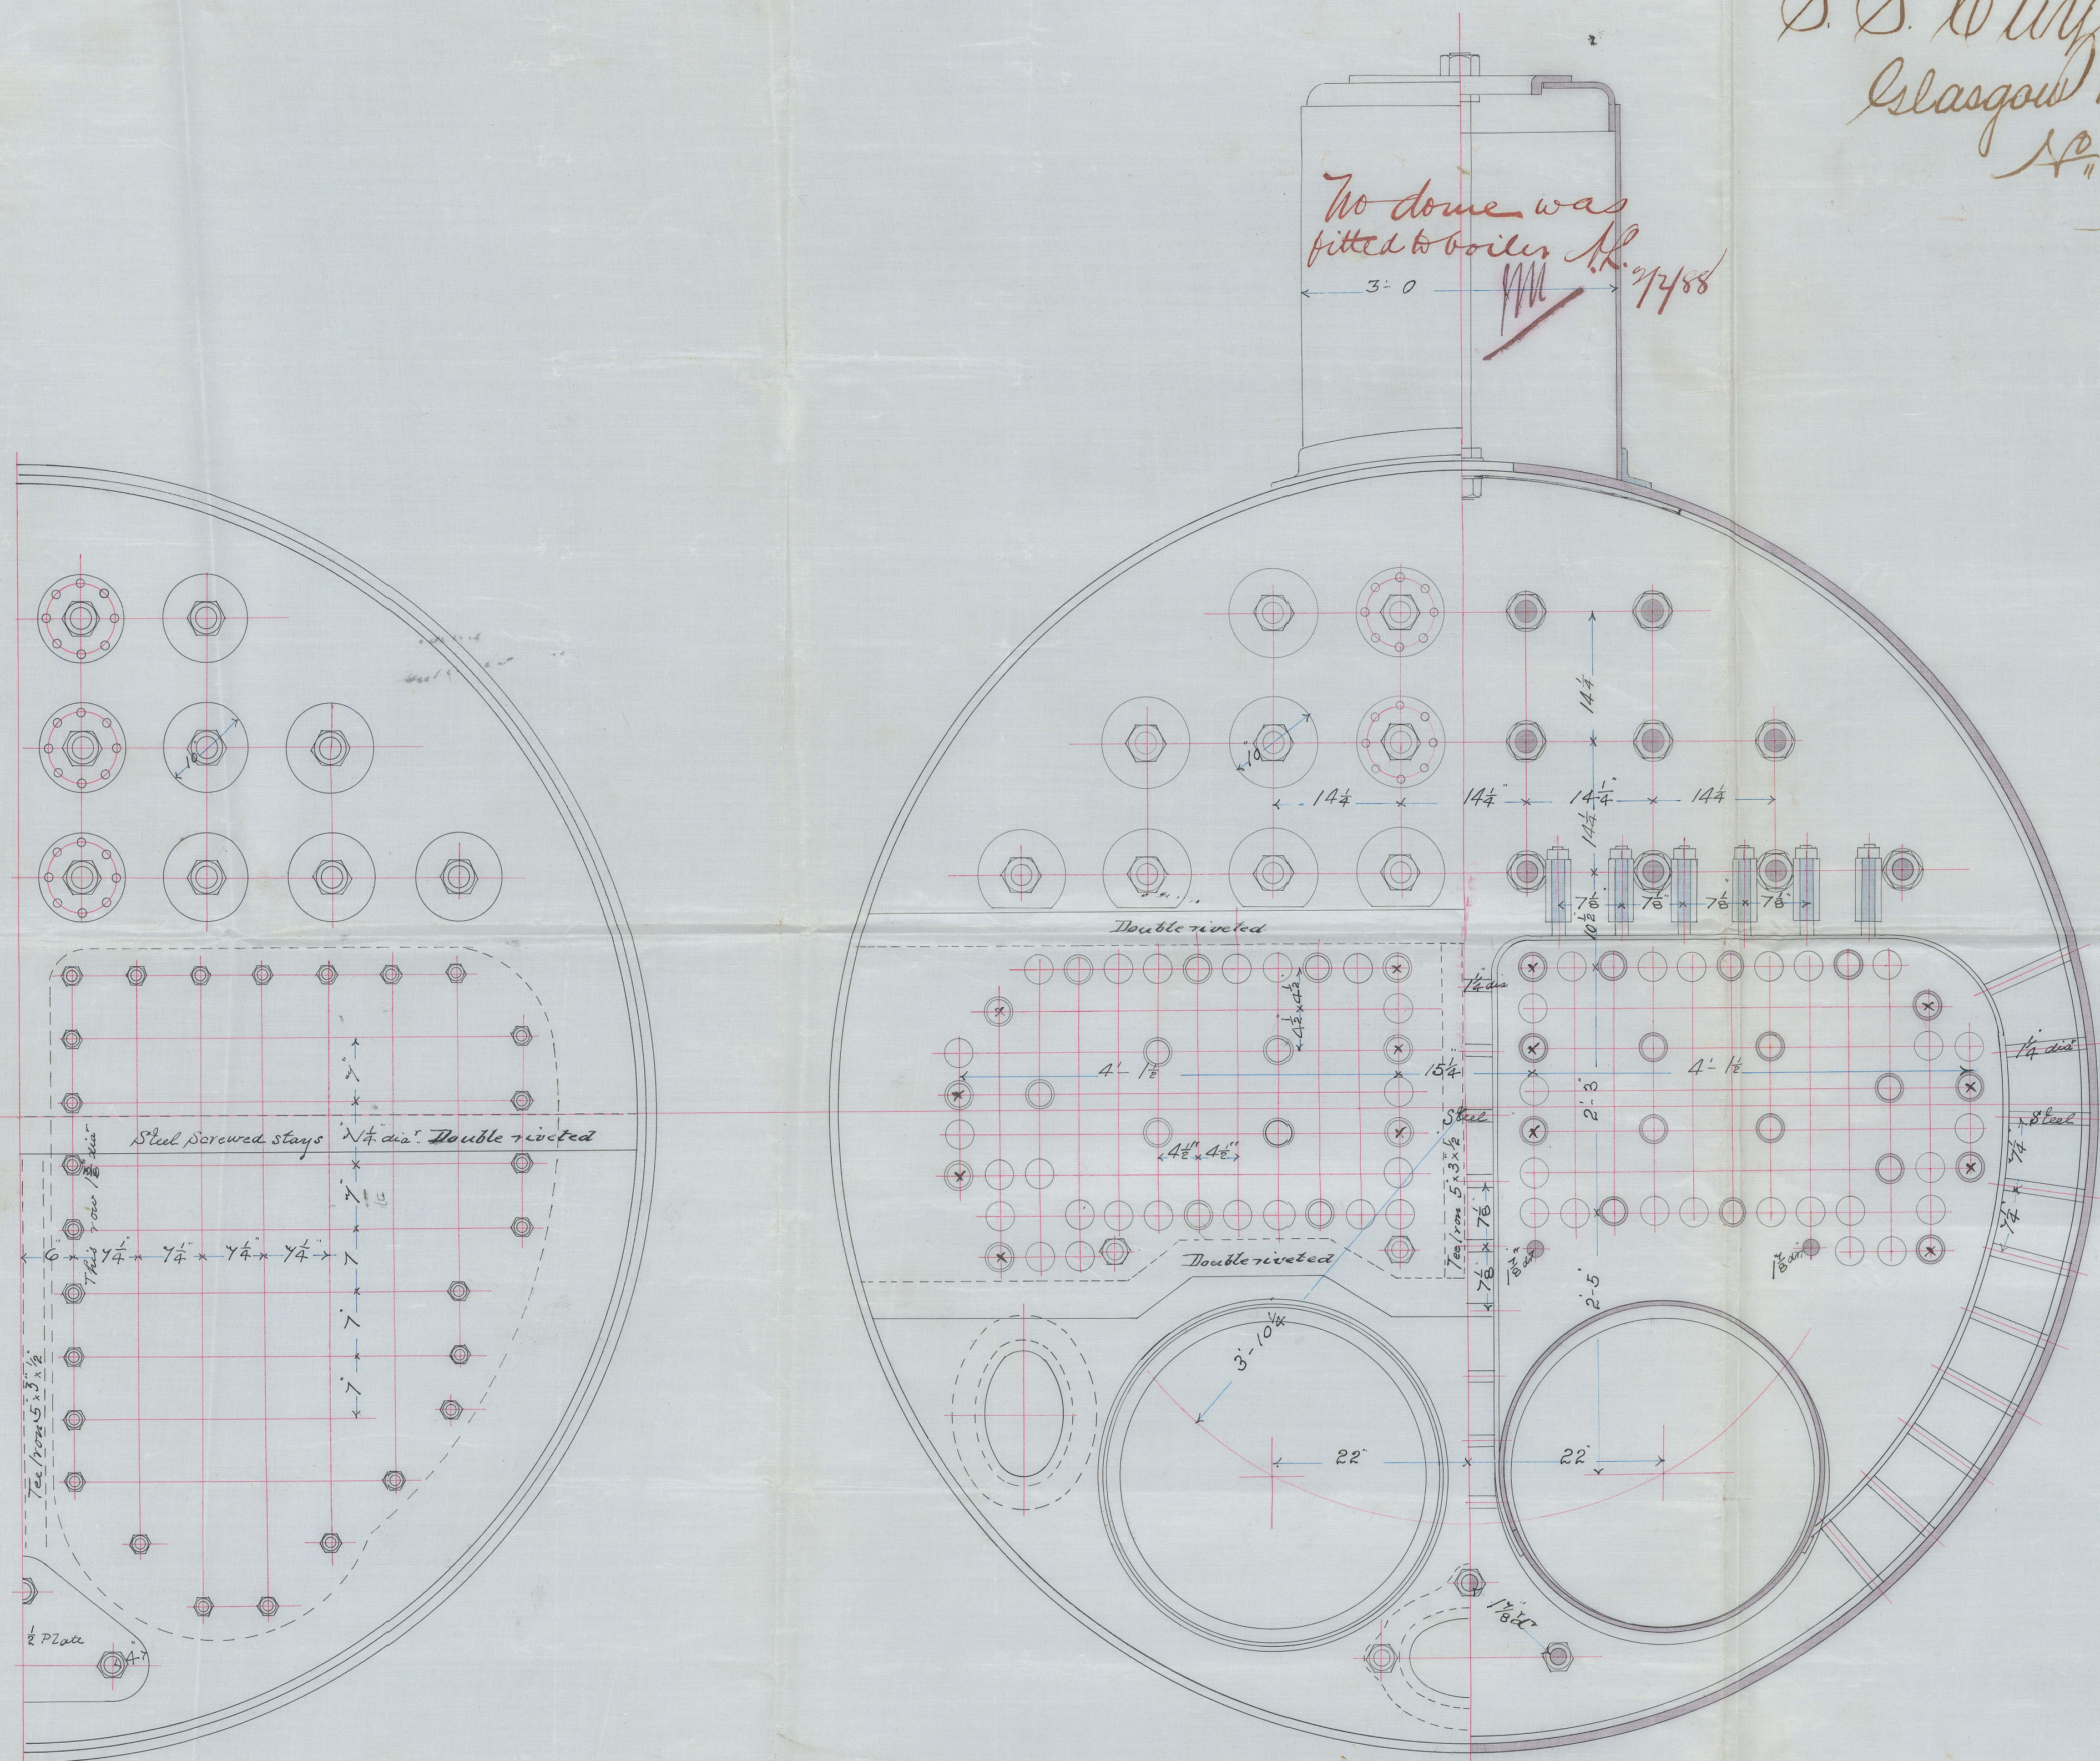

AUXILIARY BOILER No 331

SCALE 1 IN = 1 FOOT
WORKING PRESSURE 150 LBS.