

2826.

*Lt. 25/1/88*

WATER, SHANKS & BELL  
22 DEC. 87  
YOKER.

PUMPING ARRANGEMENT. S.S. N°40.


SCALE  $\frac{1}{8}$  INCH = ONE FOOT.

*S.S. "Algonquin" Glasgow Report N° 84 62.*


*H.P.S.*

*28/12/87.*

WATER, SHANKS & BELL  
22 DEC. 87  
YOKER.

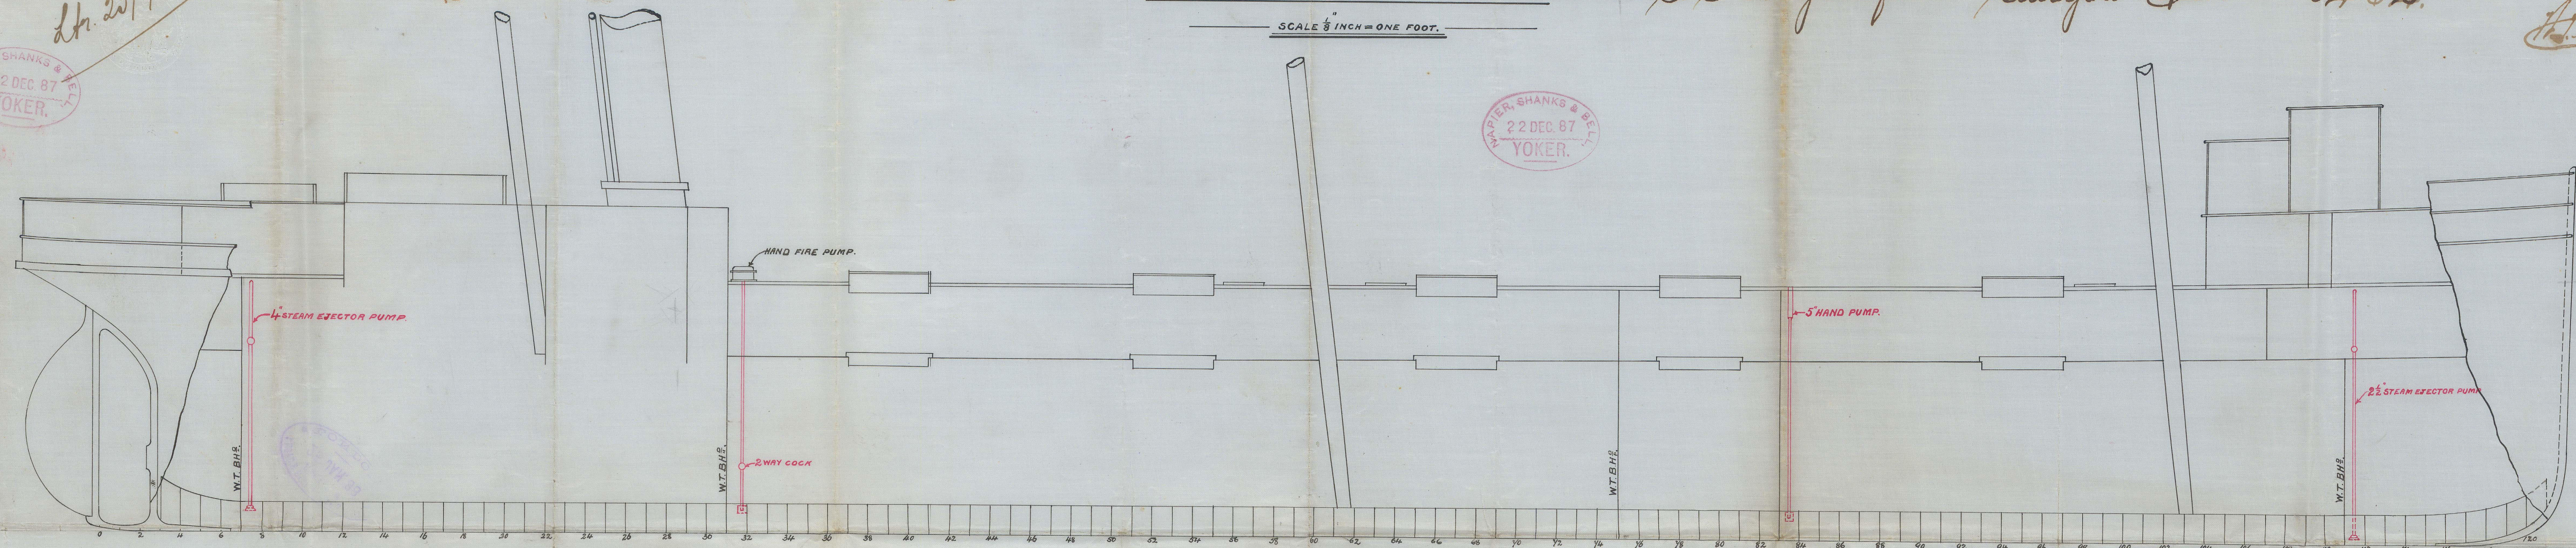

BALLAST TANK PLAN.

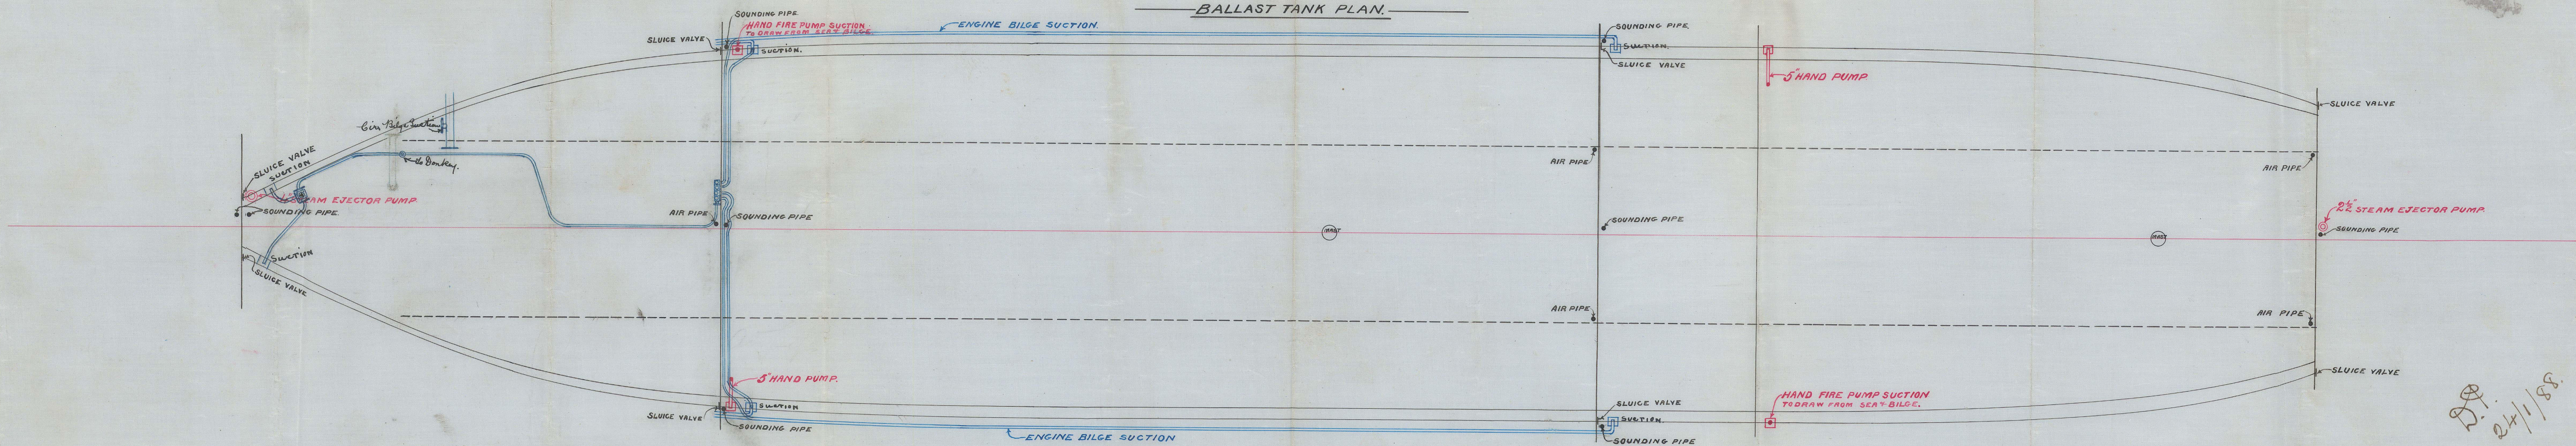

*D.P. 24/1/88.*

