

No 2782

MAST PLAN. S.S. N^o 40.


SCALE $\frac{1}{2}$ INCH = 1 FOOT.

S.S. "Algonquin" Glasgow Report N^o 8462.



2.12.87.

H.I.C.
28/11/87.

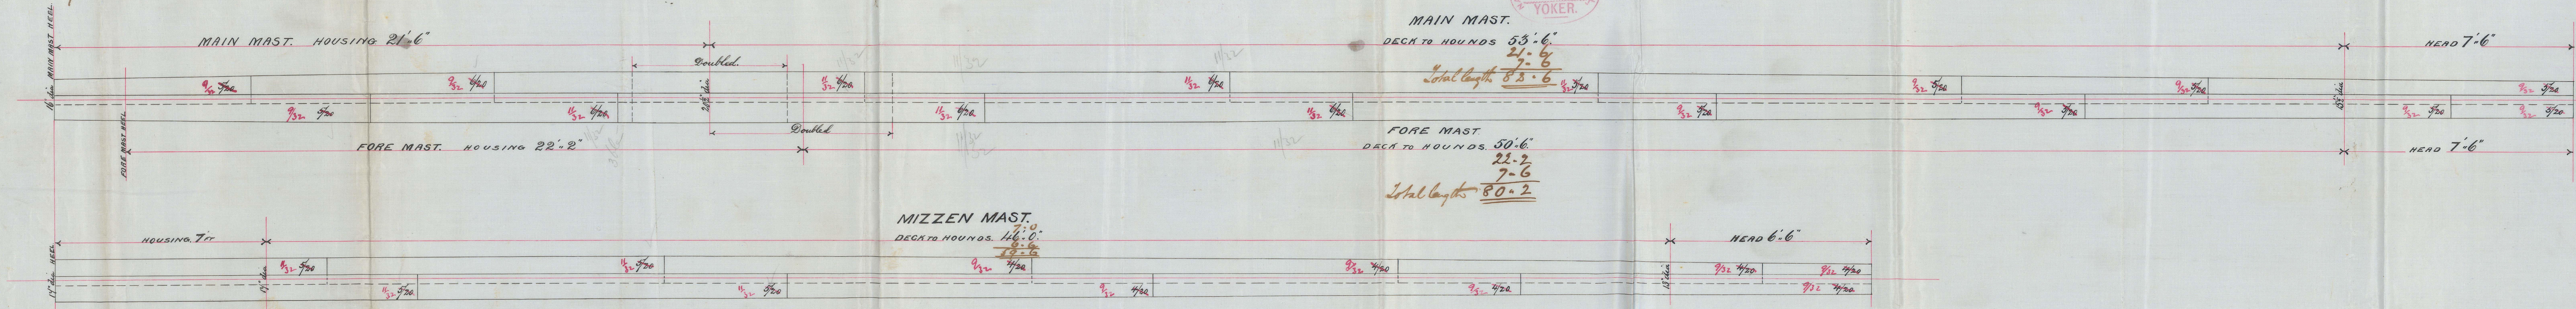

- Fore & Main Masts.
- Diameter of Rivets $\frac{1}{8}$ "
 - Lapped Seams $3\frac{3}{4}$ " double riveted
 - Butts double riveted below Deck & treble riveted above.
 - Treble riveted straps $11\frac{3}{4}$ " broad & double riveted 8" broad
- Butt Straps $\frac{1}{20}$ " thicker than the plates they connect.

- Mizzen Mast.
- Diameter of Rivets $\frac{7}{8}$ "
 - Lapped Seams $2\frac{1}{4}$ " single riveted
 - Butts treble riveted.
 - Straps $11\frac{3}{4}$ " broad & $\frac{1}{20}$ " thicker than plates they connect.

J.H.B.
2/12/87