

17115
No 4-08

Plan showing dimensions of Masts & Spars


Scale $\frac{1}{16}$ " = 1 Foot

H.L.D.

31/10/87.

Pro Mr. Rysier
Good
 31/10/87

4/11/87.

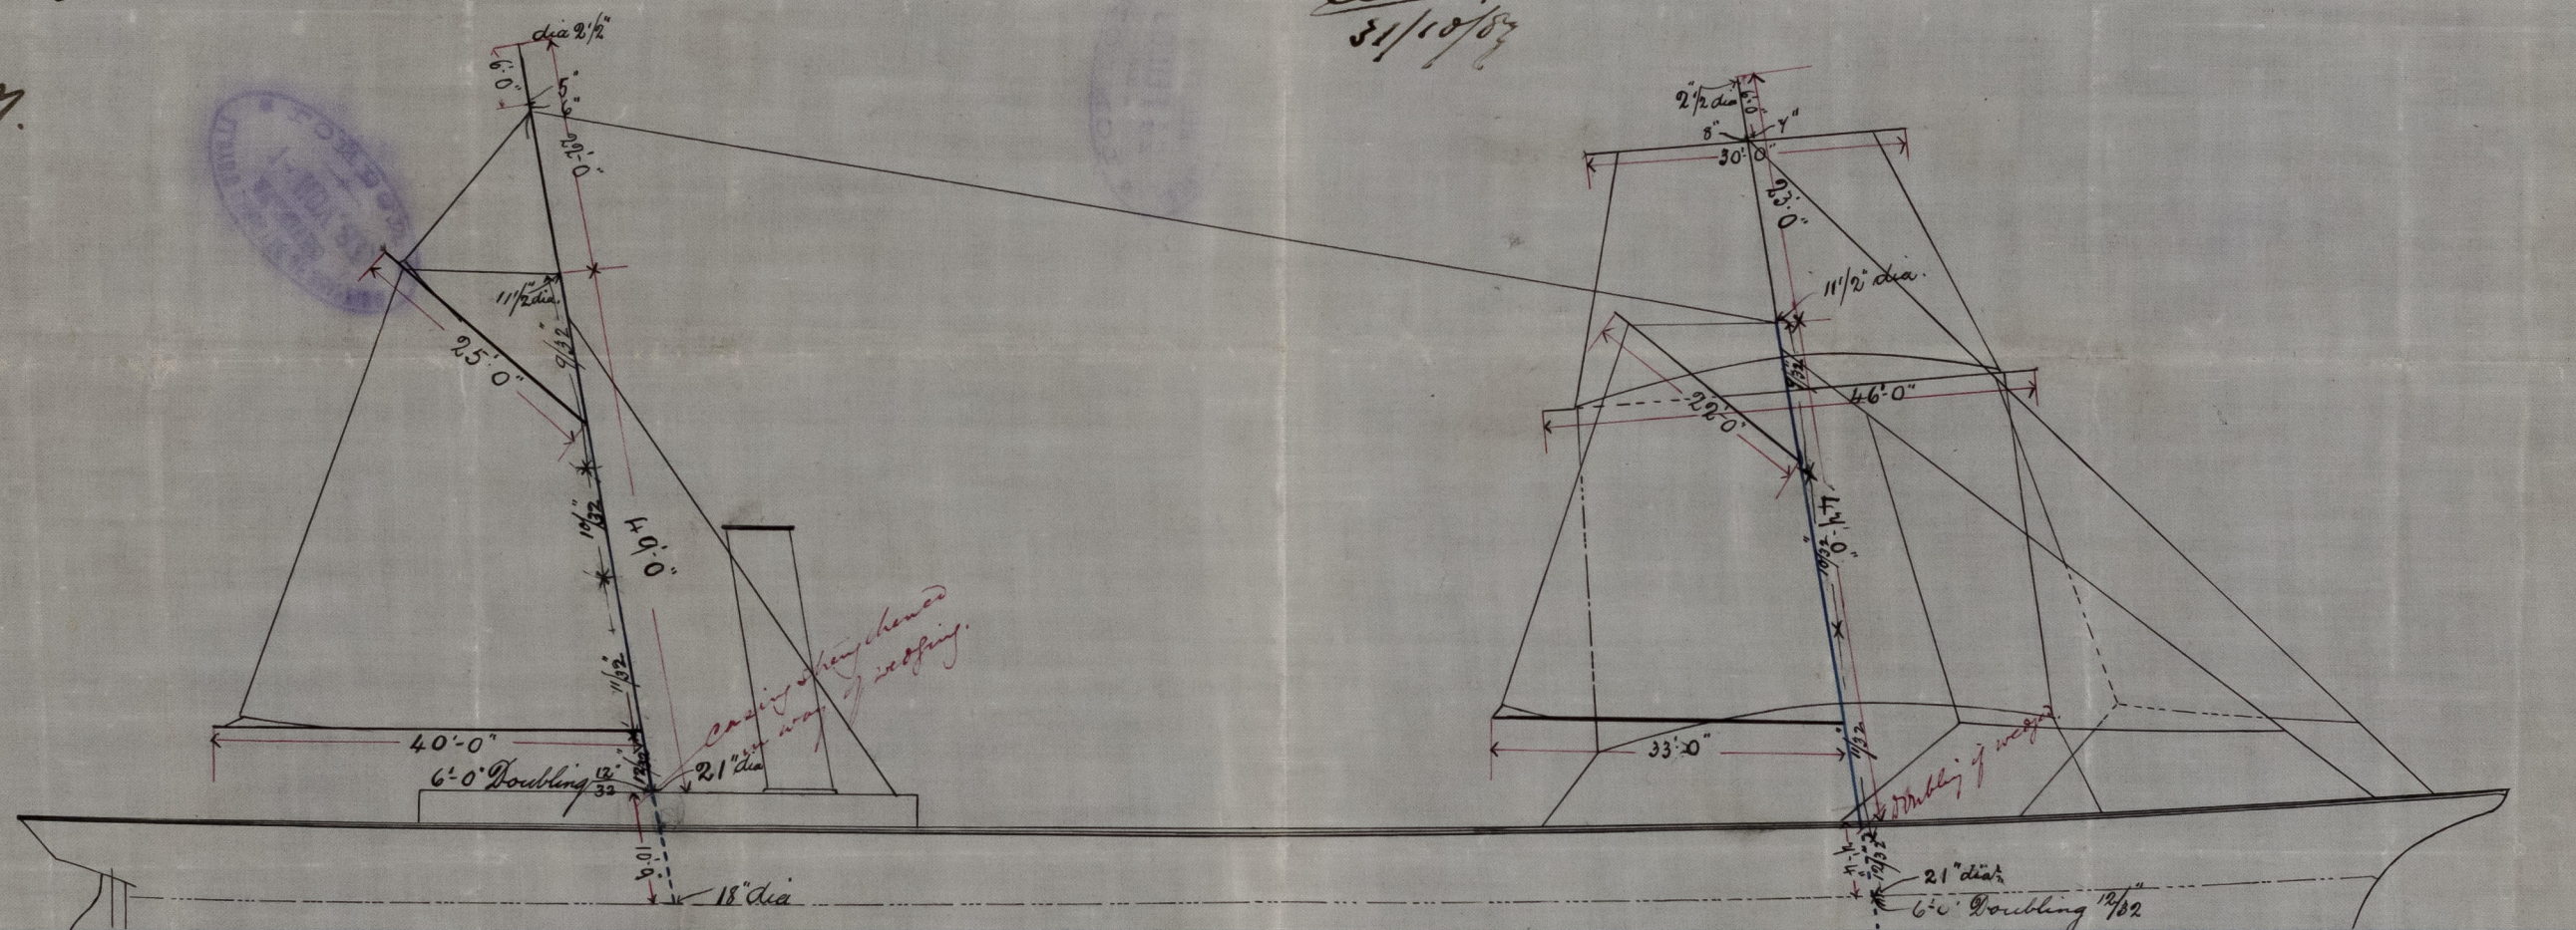

Main Mast steel 2 plates in the round.

Extreme Length 59'-9"

Heel $\frac{11}{32}$ "

Steel shown in blue

Wood shown in black

Heel of masts efficiently strengthened

Fore Mast steel 2 plates in the round.

Extreme length 40'-3"

Heel $\frac{10}{32}$ " Dia 15"

See letter
H.L.D.
 4/11/87

© 2021

Lloyd's Register
 Foundation

415208-0230

17115
 No 1-08

Plan showing dimensions of Masted & Mast

1/20/87



RECEIVED
 24 FEB. 88
 LONDON



RECEIVED
 1 NOV. 87
 LONDON

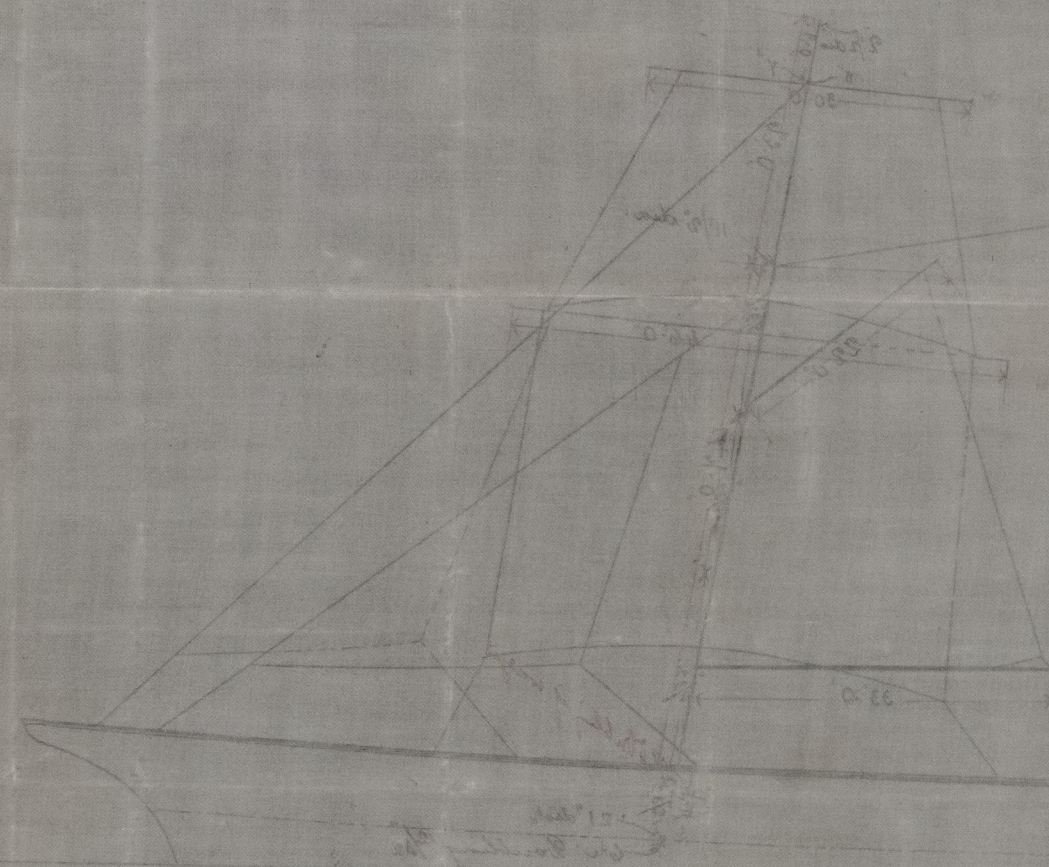

Plan of Mast & Mast








© 2021

Lloyd's Register
 Foundation

0130-0208-0130