

2783


2.12.87.

S. S. "Algonquin" Glasgow Report A 8462.-


A.S.L.
28/11/87.

Rigging Plan. S. S. No 40.
Scale $\frac{1}{4}$ " = 1 foot.

W. & A. SHANKS & CO.
26 NOV. 87
YOKER.

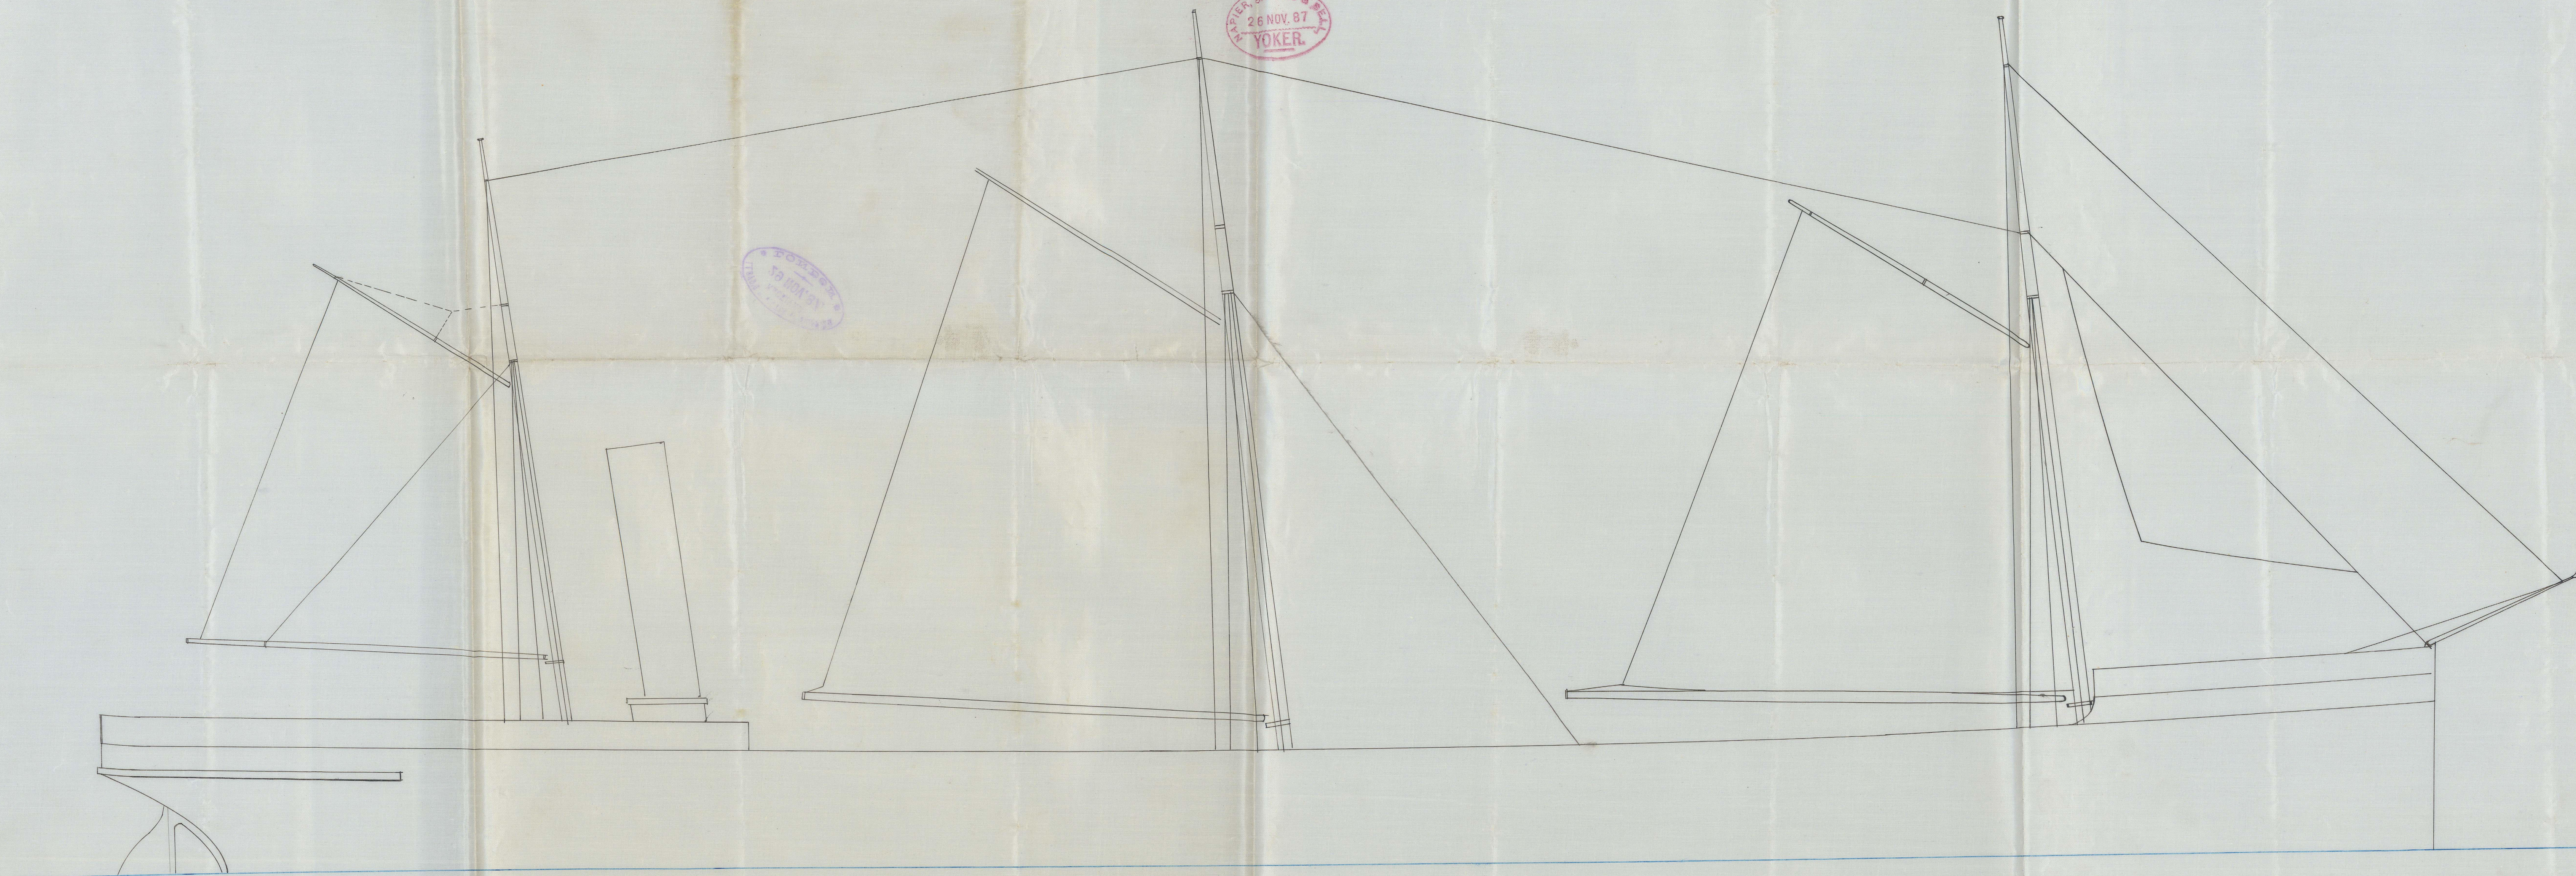

J.H.
2/12/87

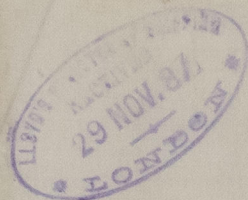



GLS708-0232



© 2021

Lloyd's Register
Foundation