


3.11.87.

N^o 2758.


B

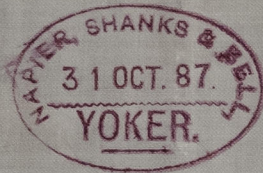


Profile & Deck Plans. S.S. N^o 40.

Scale 1/16" = 1 Foot.


S.S. Algonquin Glasgow Report N^o 8462.

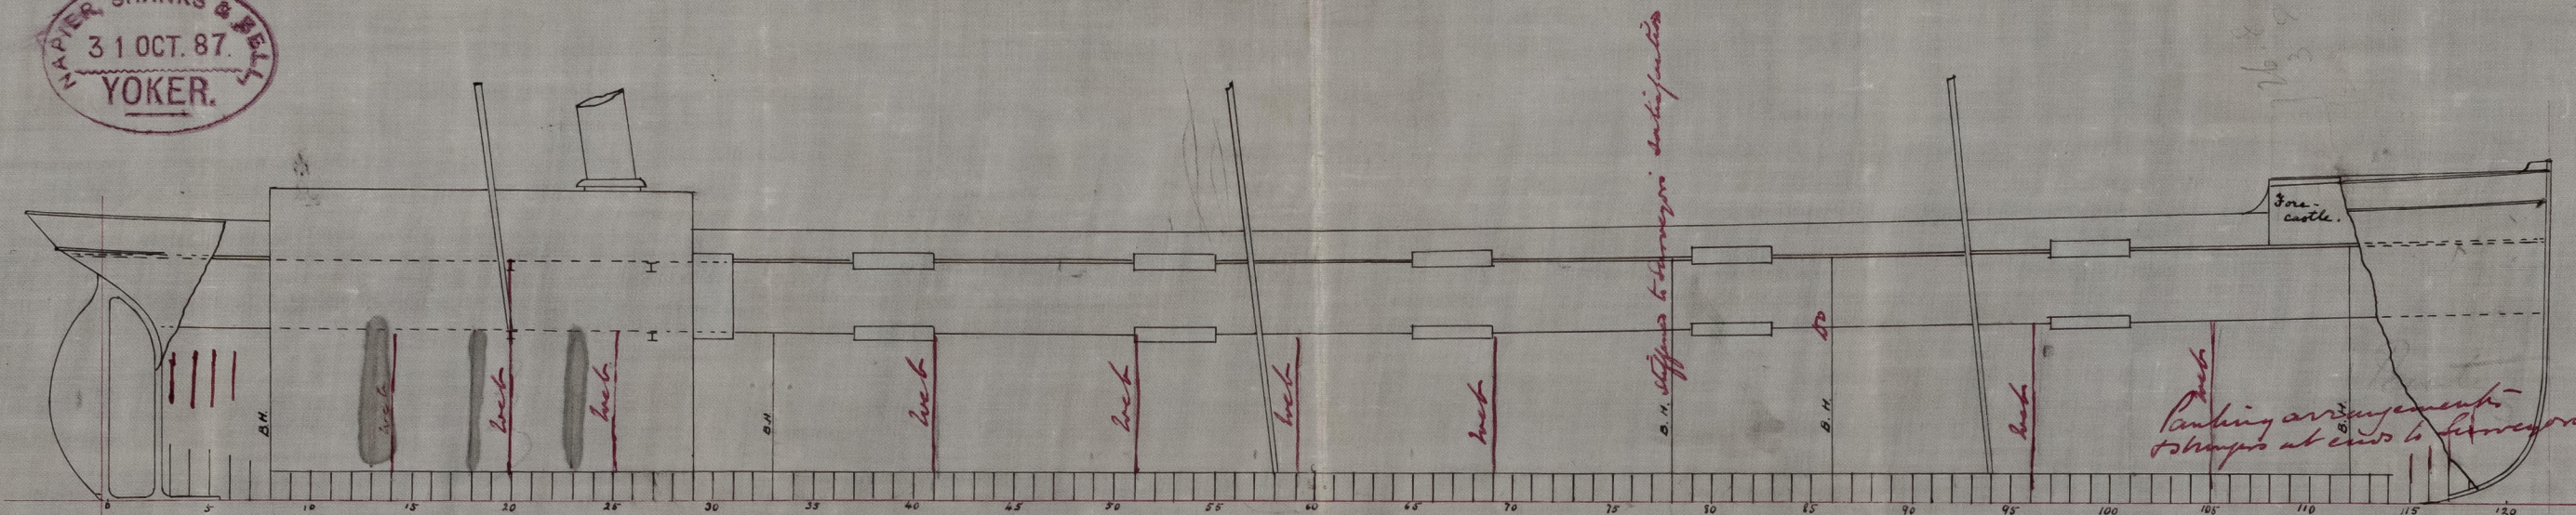

— Spar Deck. — (See revised Spar Deck Plan)
No. 2889.

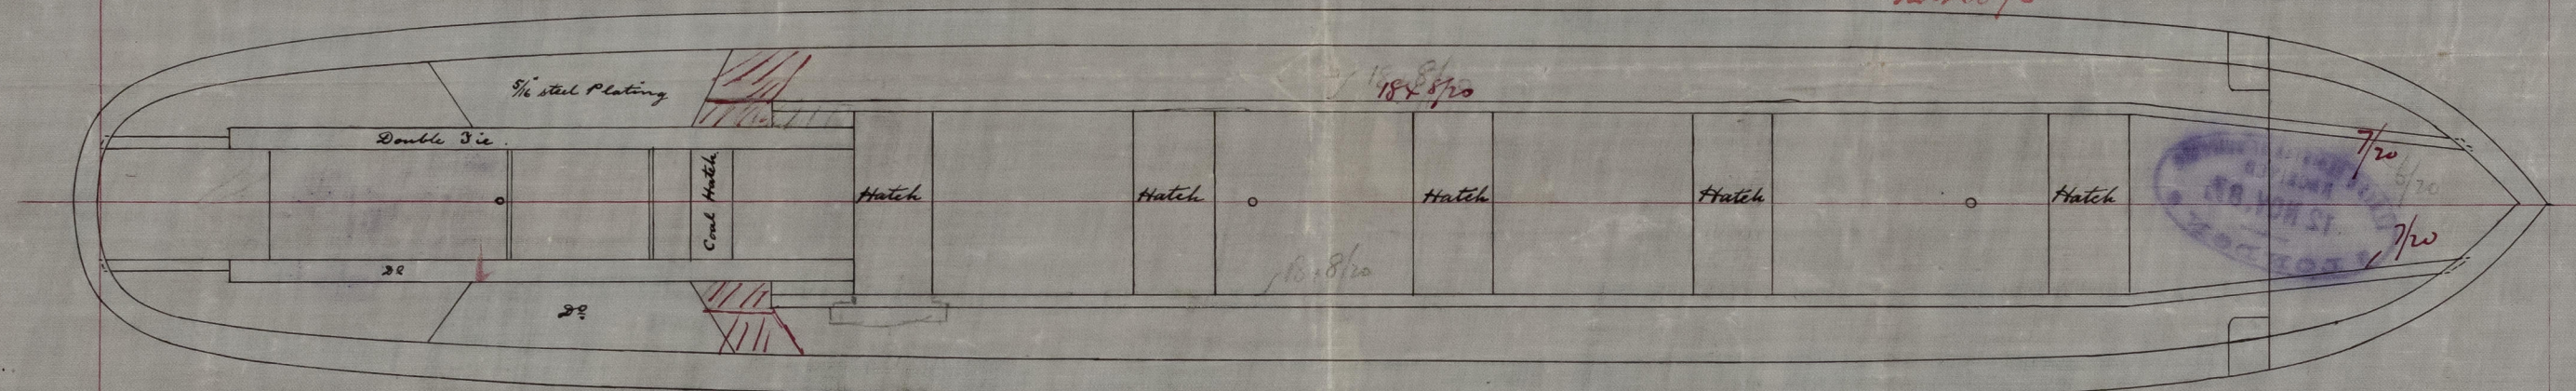

— Main Deck. —

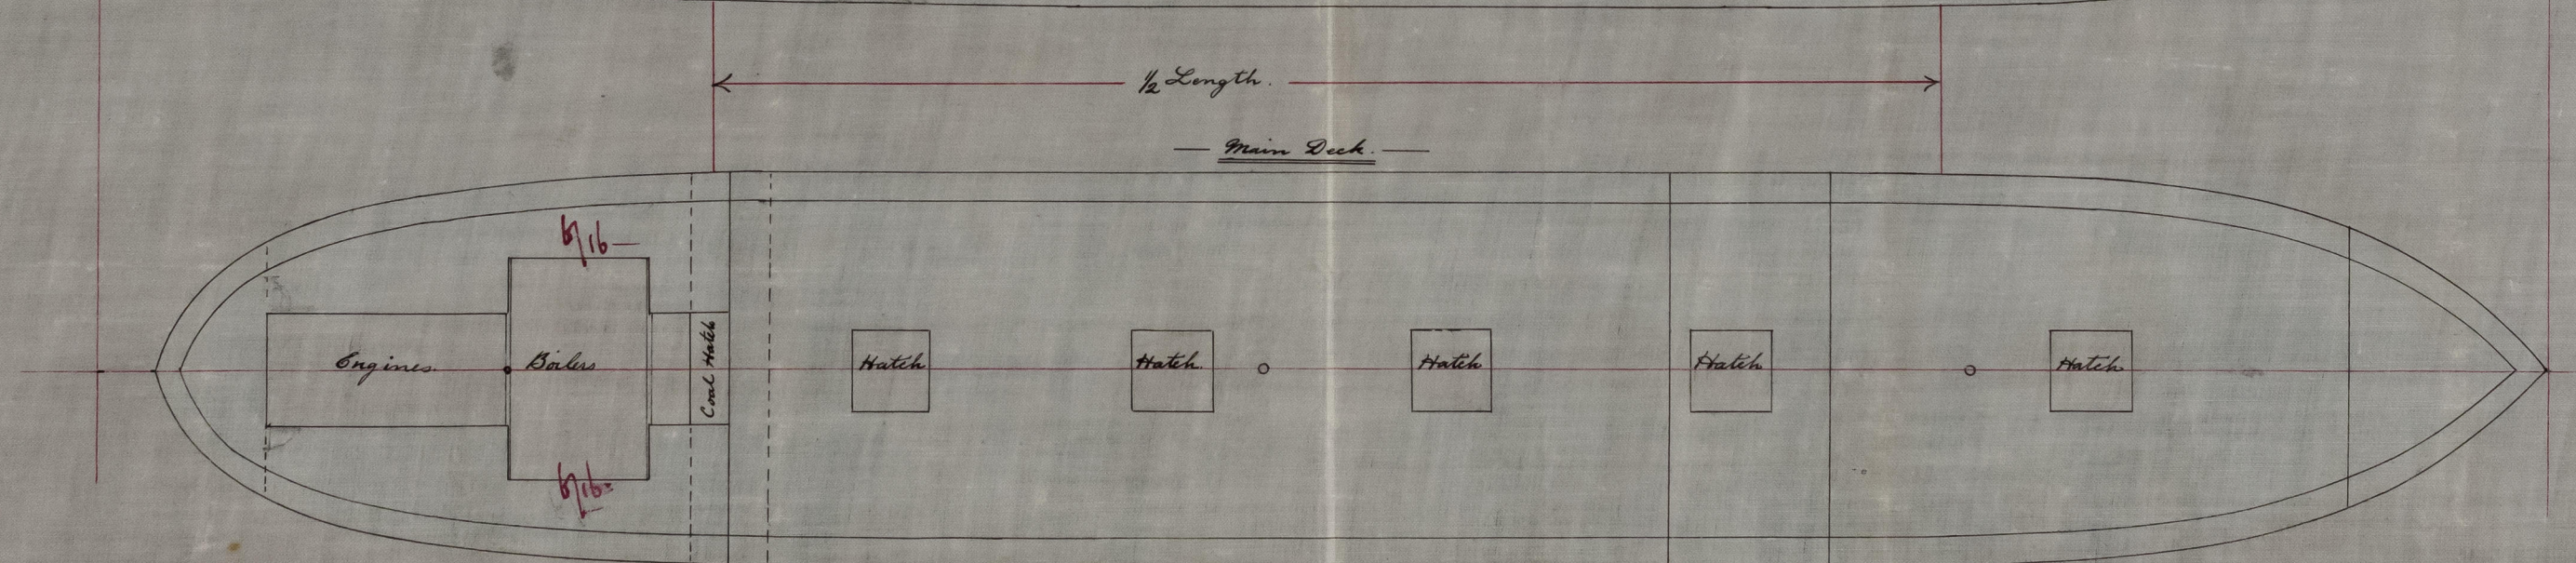


J.H.L.
2/11/87



Lloyd's Register
Foundation

GLS208-0234


Wm. D. Thompson
London Report No 84 63

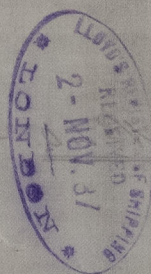

B No 258



211.87

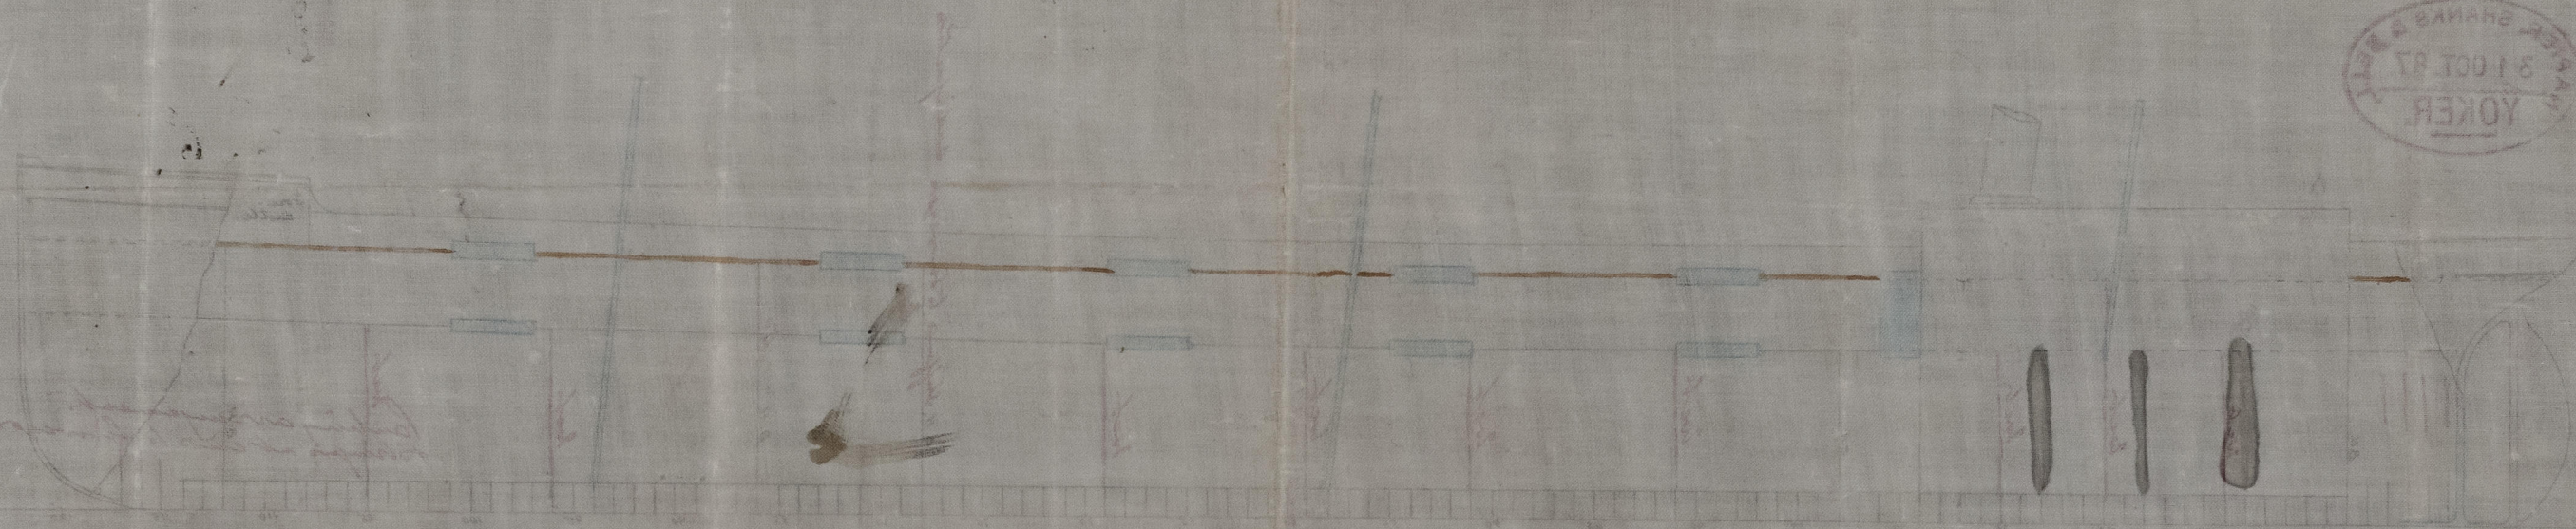

(See reverse for details)

