

# Lloyd's Register of British and Foreign Shipping.

(Report on Vessel No. 8462 Port Glasgow)

S. S. Algonquin

No. 1548

## SHIP FORGINGS OR CASTINGS.

I have to report that the undermentioned Iron or Steel Forgings or Castings, manufactured by The Portland Forge Co. of Kilmarnock for the Vessel No. 40, being built by Messrs Napier Shanks & Bell. of Yoker. have been inspected by me as set forth below, and found to be, so far as can be seen, sound and efficient.

Mark on Forgings.

Lloyd's  
No. 1548  
G.N.


George Newcomb

Glasgow.

31/12/84.

	STERN FRAME.	RUDDER FRAME.	STEM.
Material*	<u>Scrap iron</u>	/	<u>Scrap iron</u>
How made	<u>Forged.</u>		<u>Forged.</u>
Dimensions	<u>8 1/2 x 5</u>		<u>8 1/2 x 2 1/2.</u>
Progress on Inspection	<u>Forging &amp; smithing</u>		<u>Forging &amp; smithing</u>
Dates when Inspected	<u>18.25/11/84. 8.13.16/12/84.</u>		<u>8.22.30/12/84.</u>

SKETCHES OF FRAMES SHEWING POSITION AND DESCRIPTION OF WELDS OF FORGINGS, OR PARTICULARS OF TESTS APPLIED TO CASTINGS.

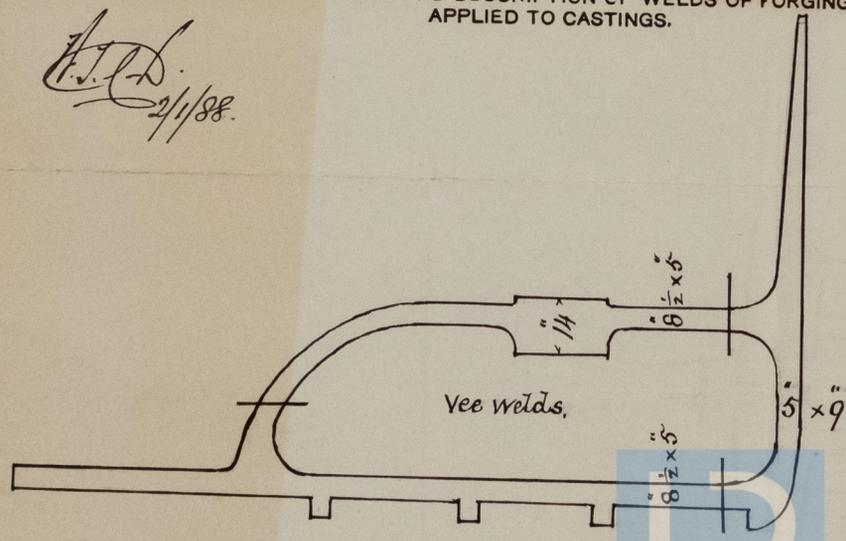

\* If of Iron, state whether scrap or puddled iron.