

# Lloyd's Register of British and Foreign Shipping.

(Report on Vessel No. 8462 Port Glasgow)  
S. S. "Algonquin"

No. 1548

## SHIP FORGINGS OR CASTINGS.

I have to report that the undermentioned Iron ~~or Steel~~ Forgings ~~or Castings~~, manufactured by The Portland Forge Co. of Hilmarnock. for the Vessel No. 40, being built by Messrs Napier, Shanks & Bell. of Glasgow. have been inspected by me as set forth below, and found to be, so far as can be seen, sound and efficient.

Mark on Forgings.

Lloyd's

No. 1548

G.N.

George Newcomb.


Glasgow.

14/3/88.

	STERN FRAME.	RUDDER FRAME.	STEM.
Material* - - - -	/	Scrap iron.	/
How made - - - -		Forged.	
Dimensions - - - -		6 1/2 x 3 1/4	
Progress on Inspection -		Forging & smithing	
Dates when Inspected		16.18.24.28/2/88. 2.7/3/88.	

SKETCHES OF FRAMES SHEWING POSITION AND DESCRIPTION OF WELDS OF FORGINGS, OR PARTICULARS OF TESTS APPLIED TO CASTINGS.

16/3/88  
J.H.L.

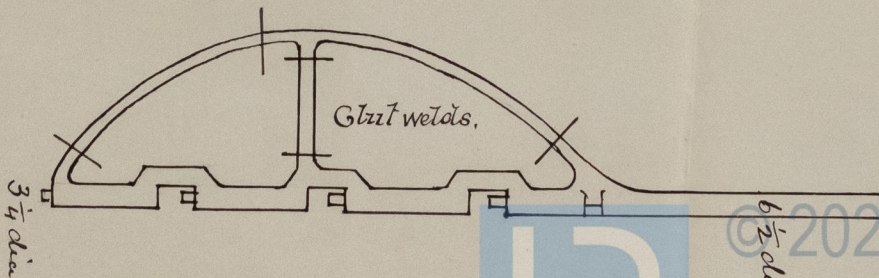







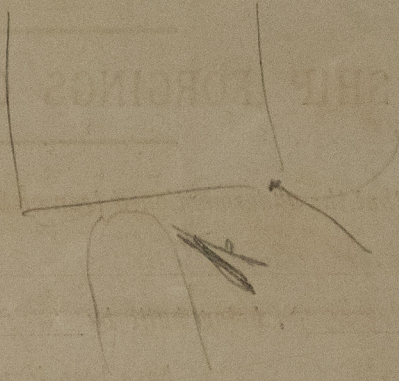

© 2021

Lloyd's Register  
Foundation