

Nº 2775

CARGO PORTS Nº 40


SCALE $1\frac{1}{2}" = 1\text{FOOT}$

S.S. "Algonquin"
Glasgow Report Nº 8462.-



H.T.D.
23/11/87

24.11.87

SECTION

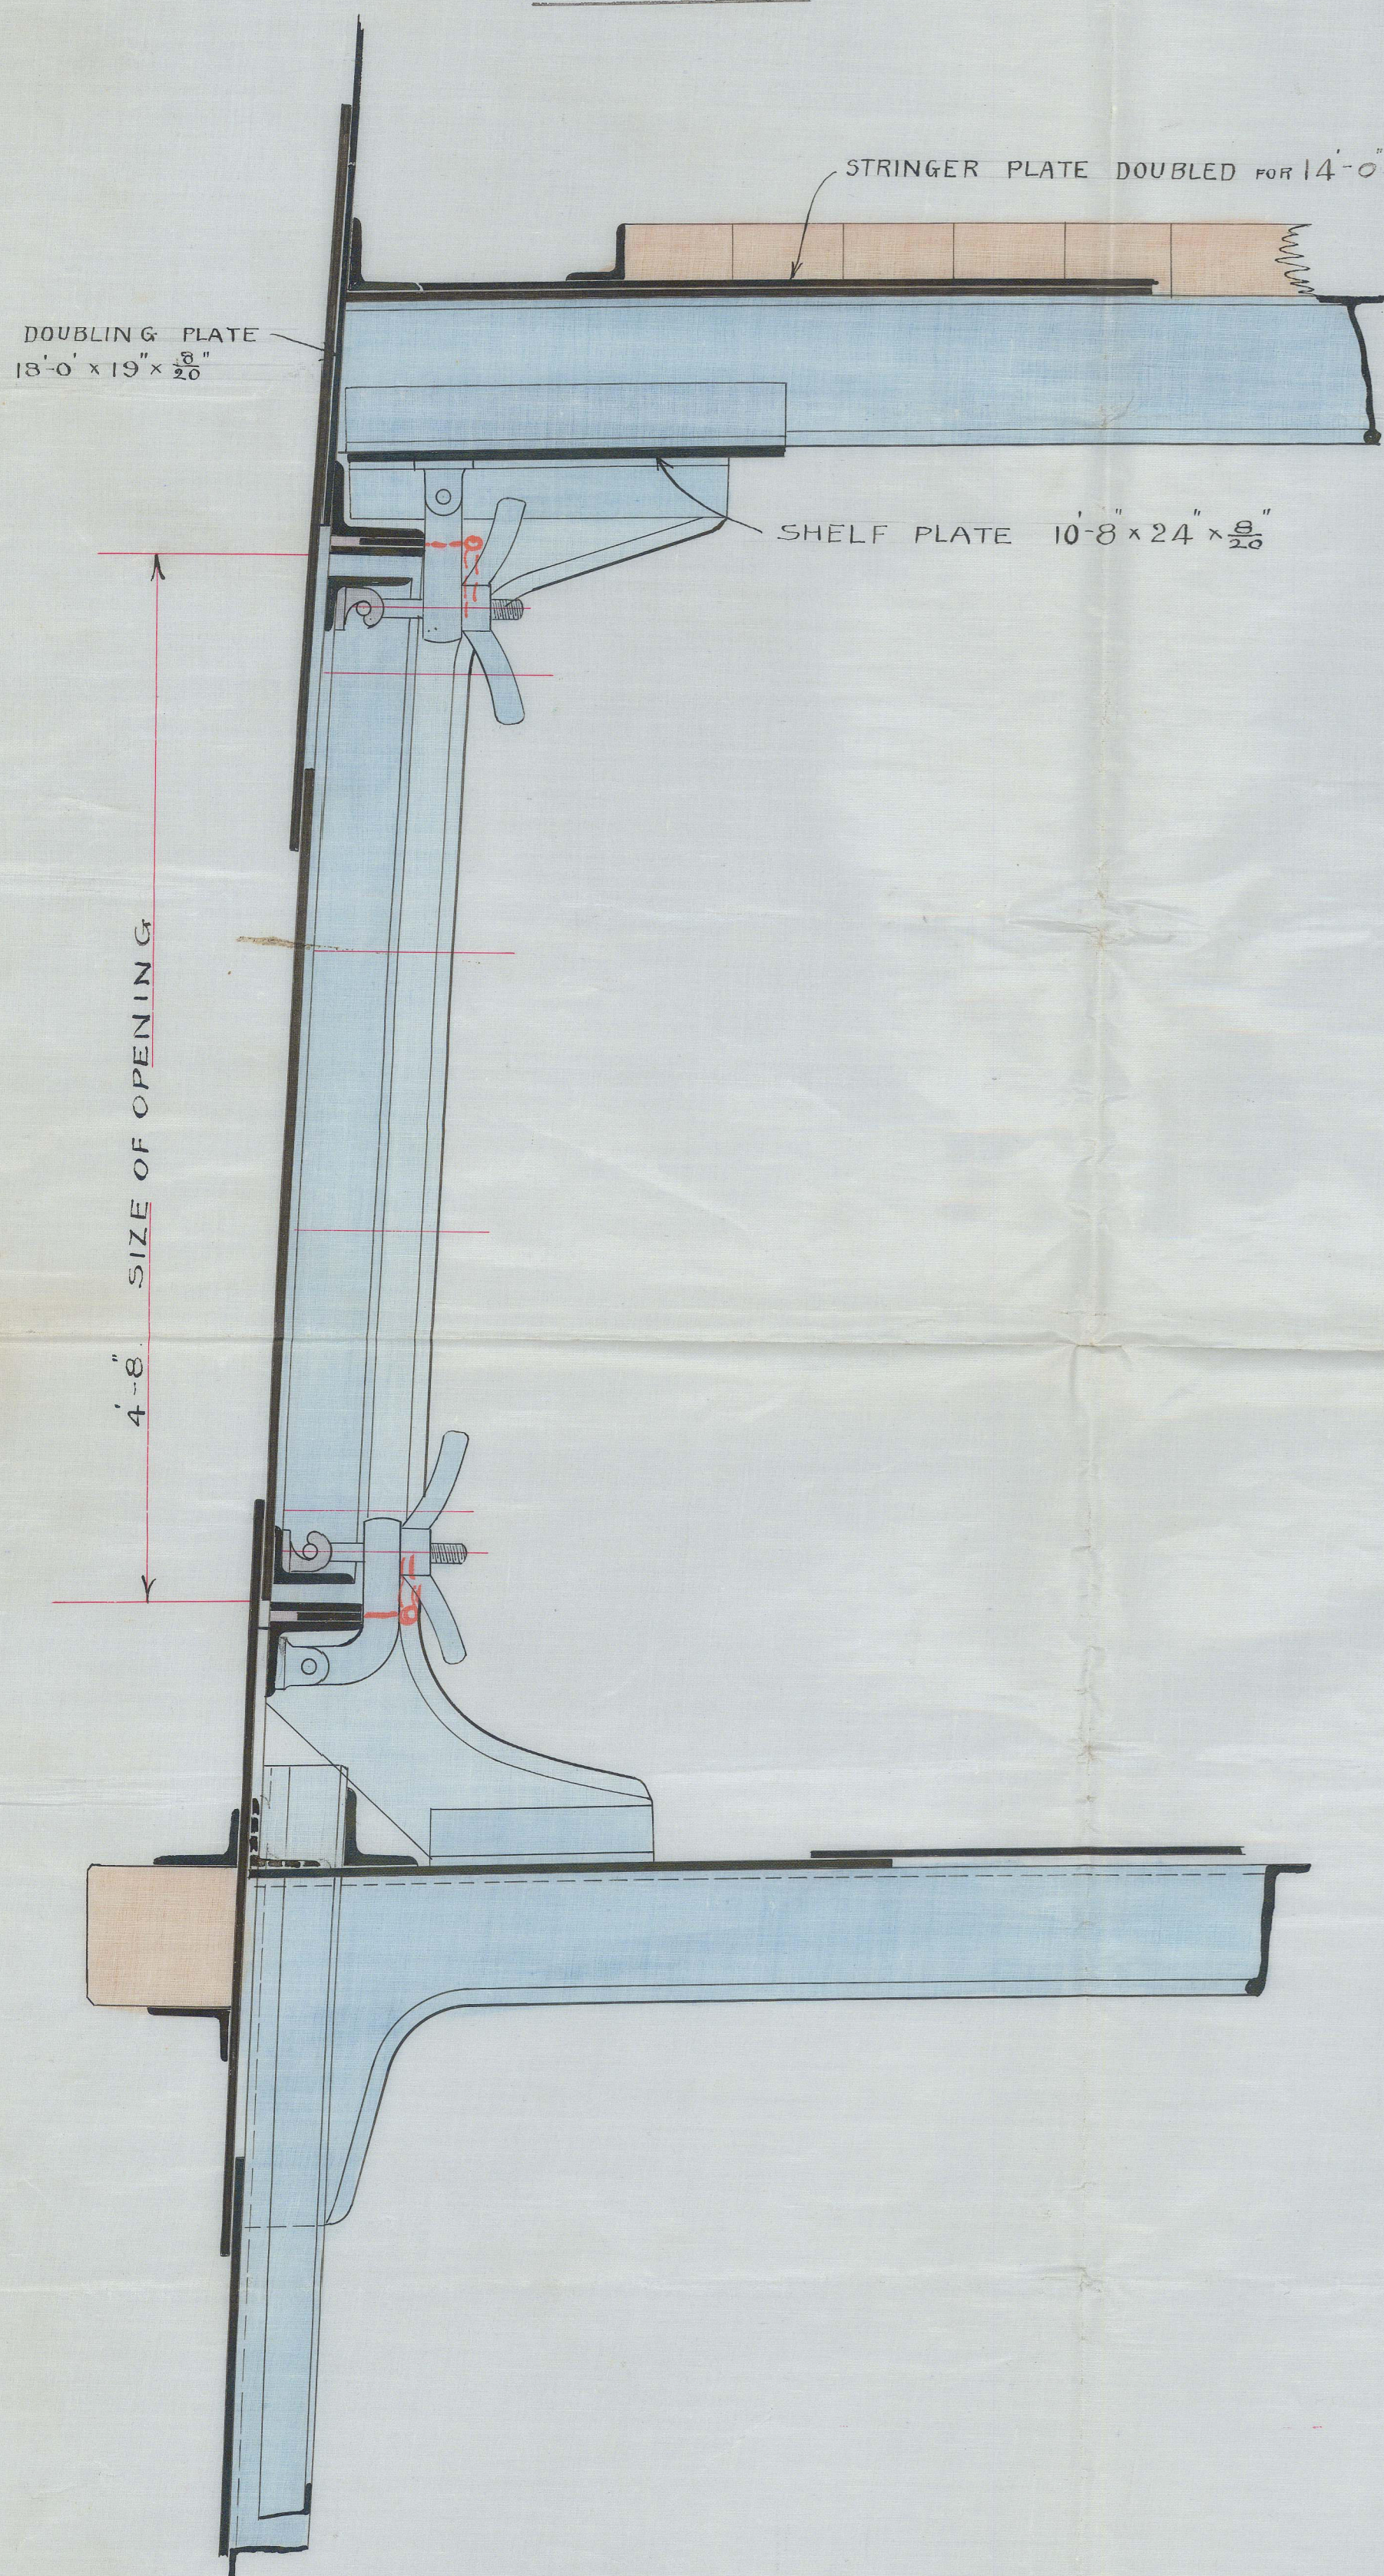

INSIDE ELEVATION

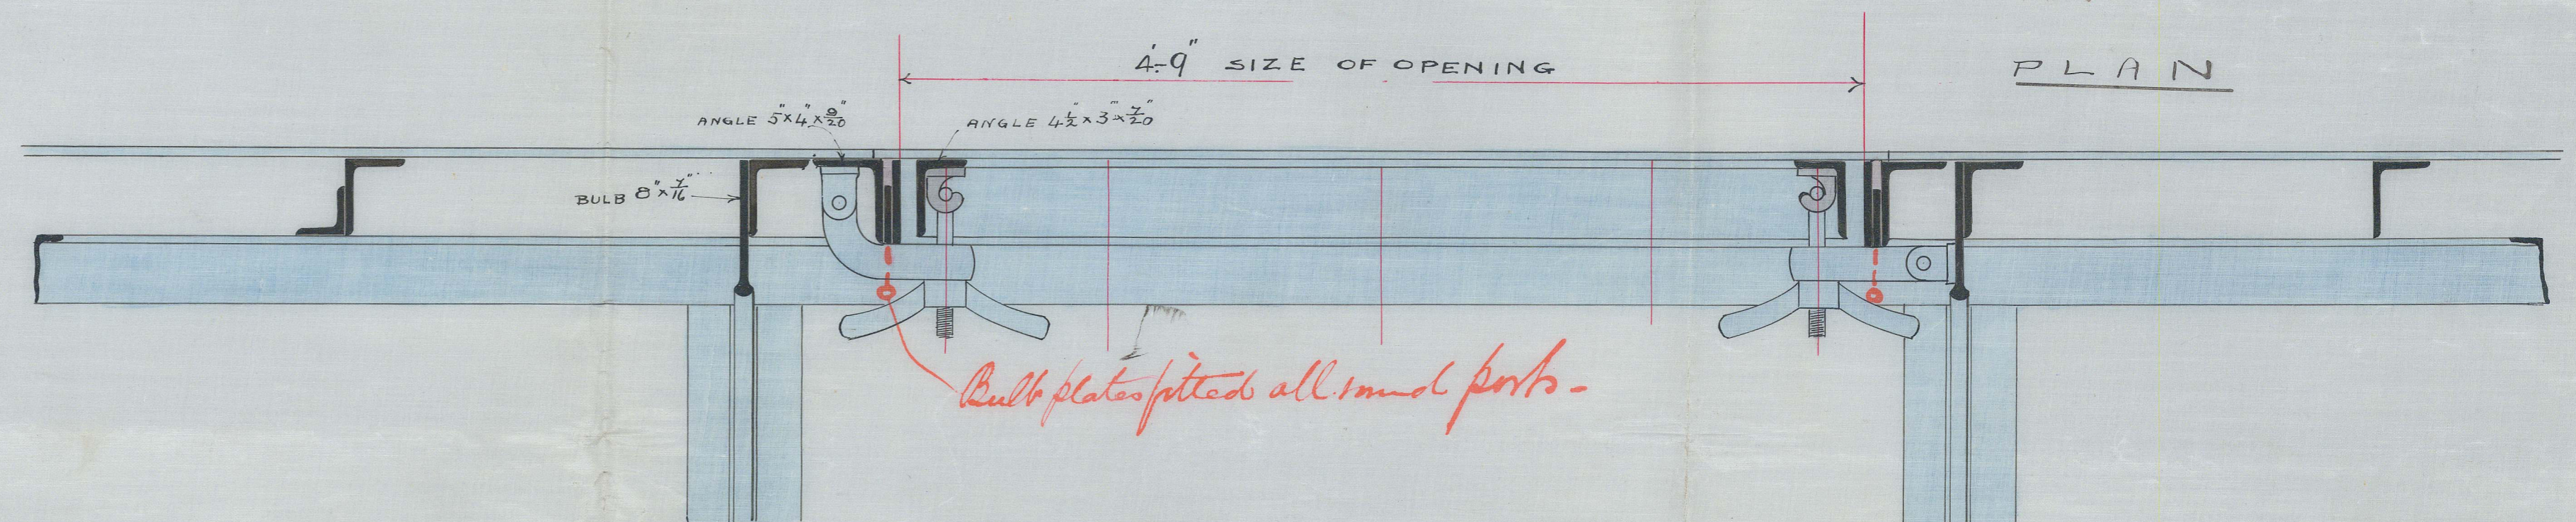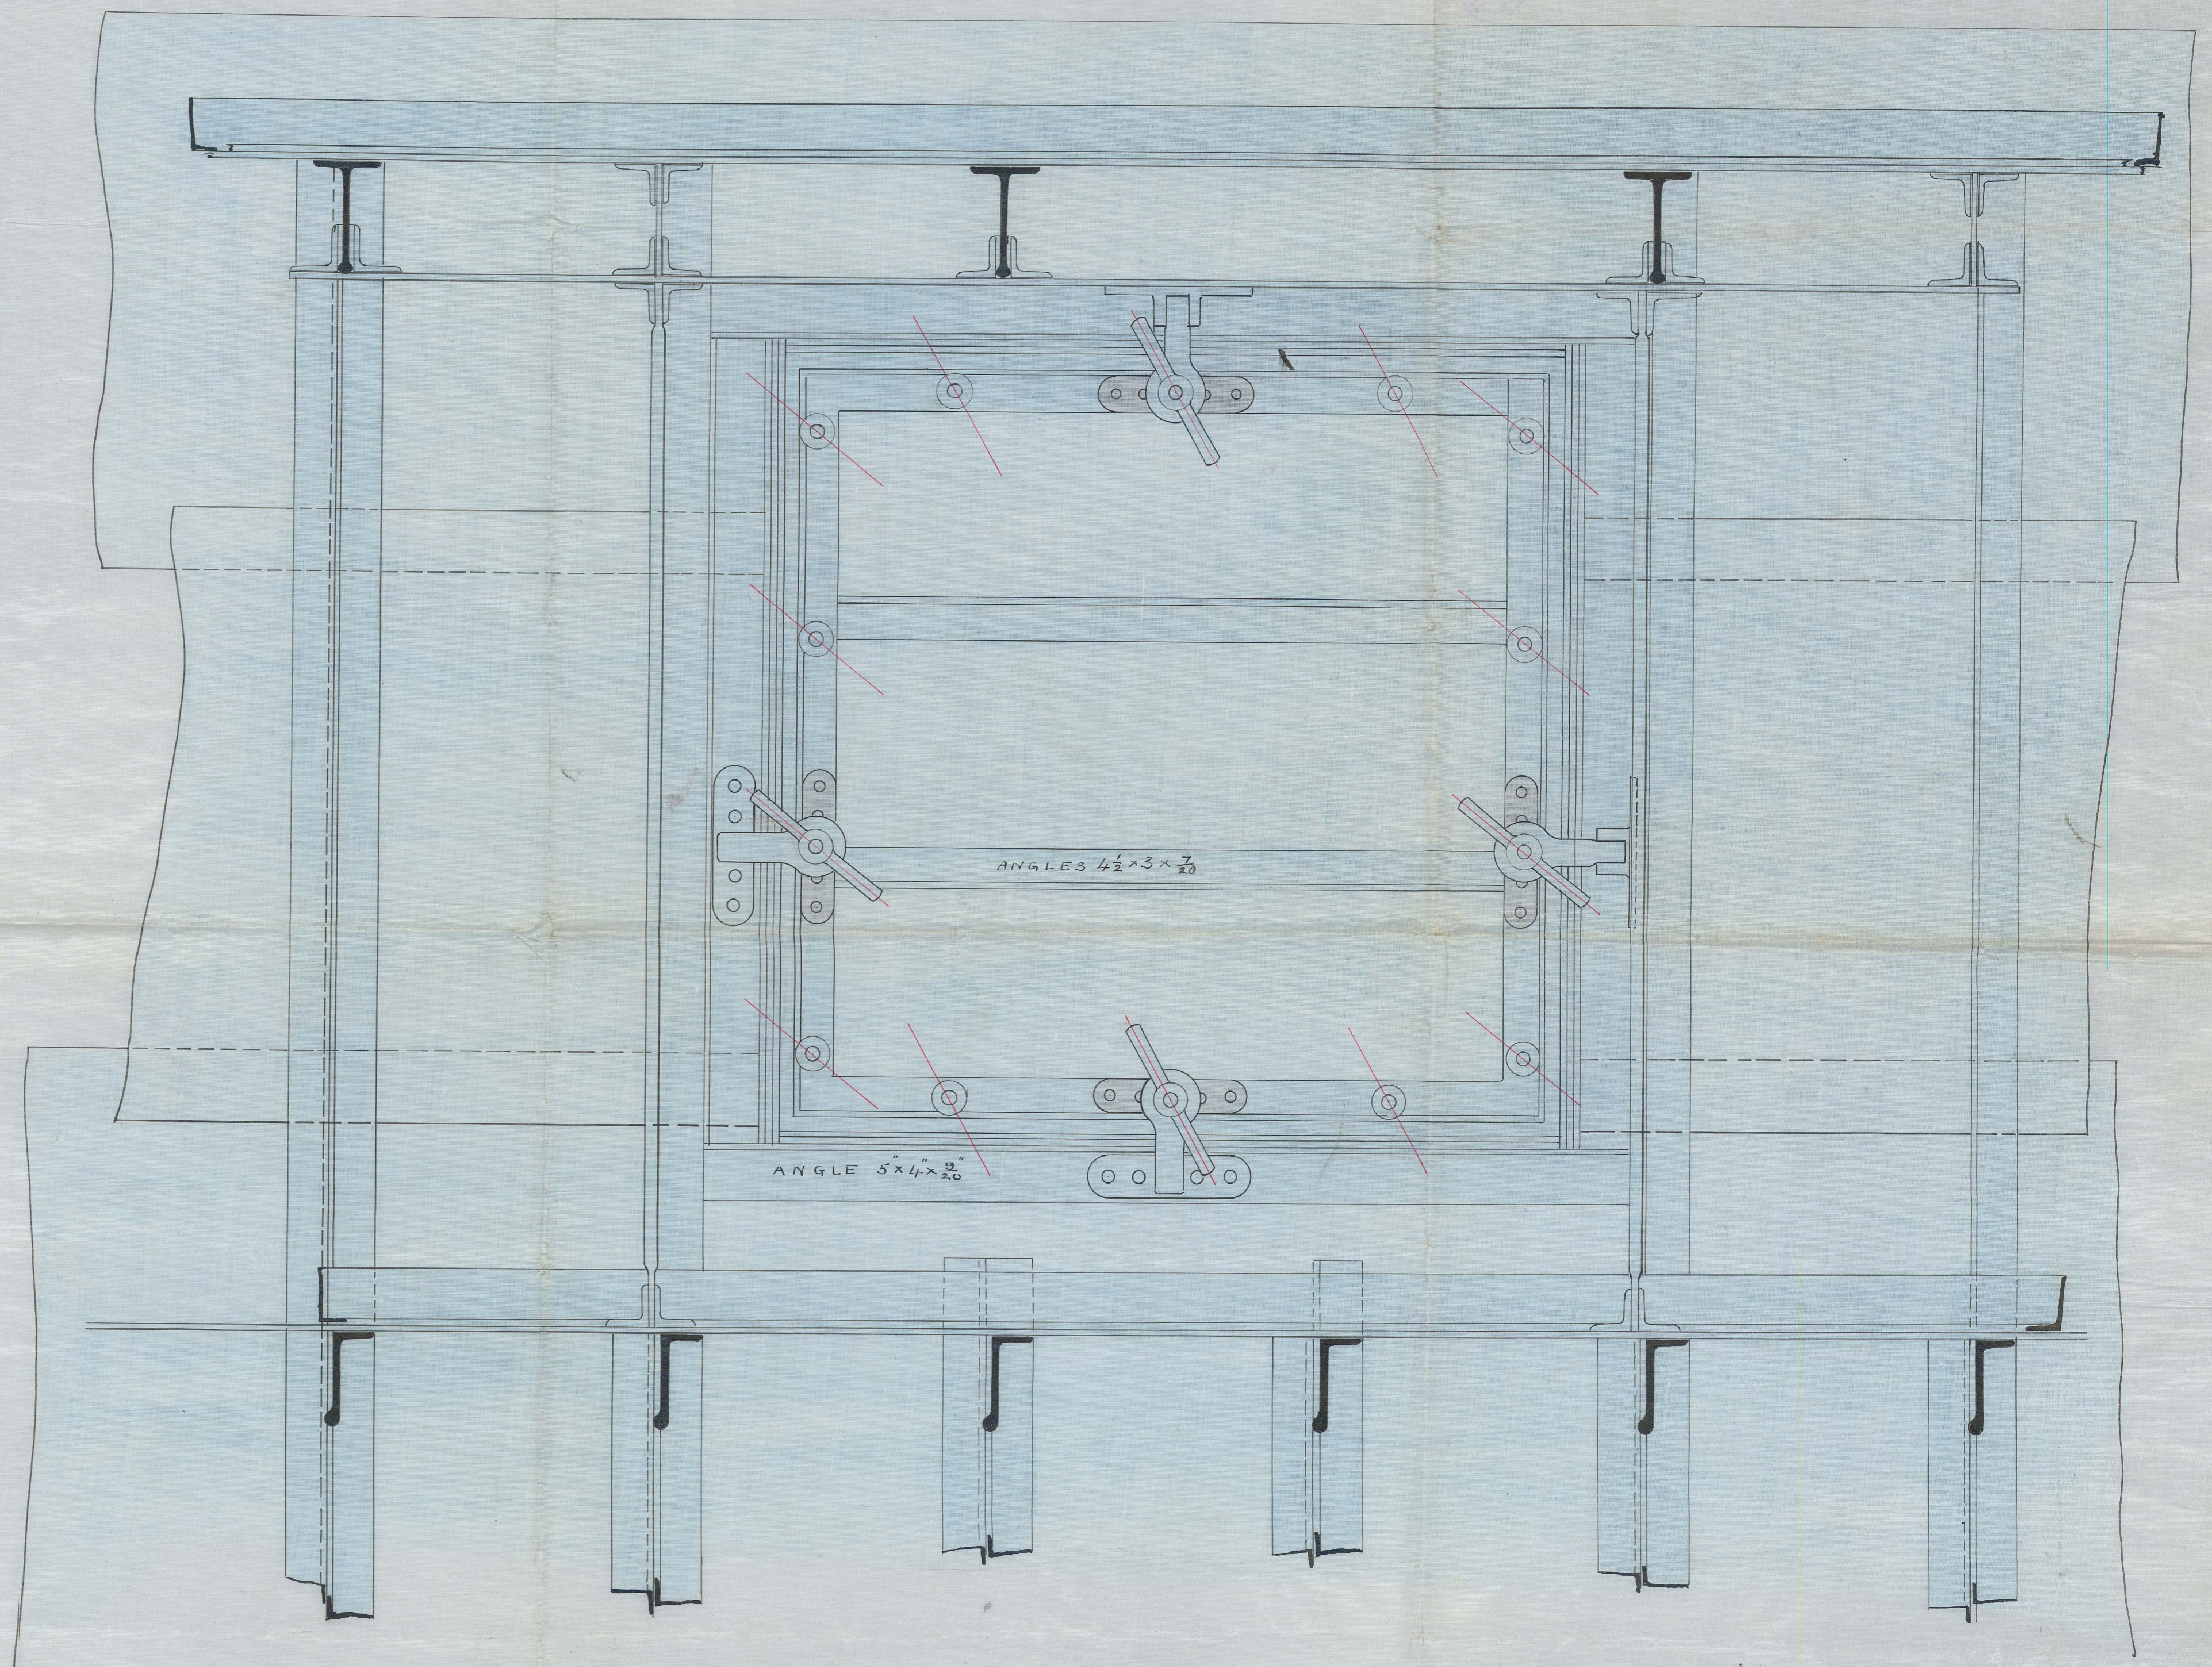




H.T.D.
24/11/87

2775
27/11/87


24.11.87

SECTION

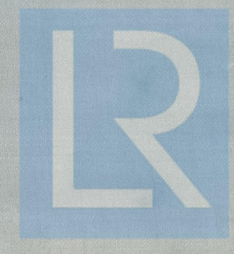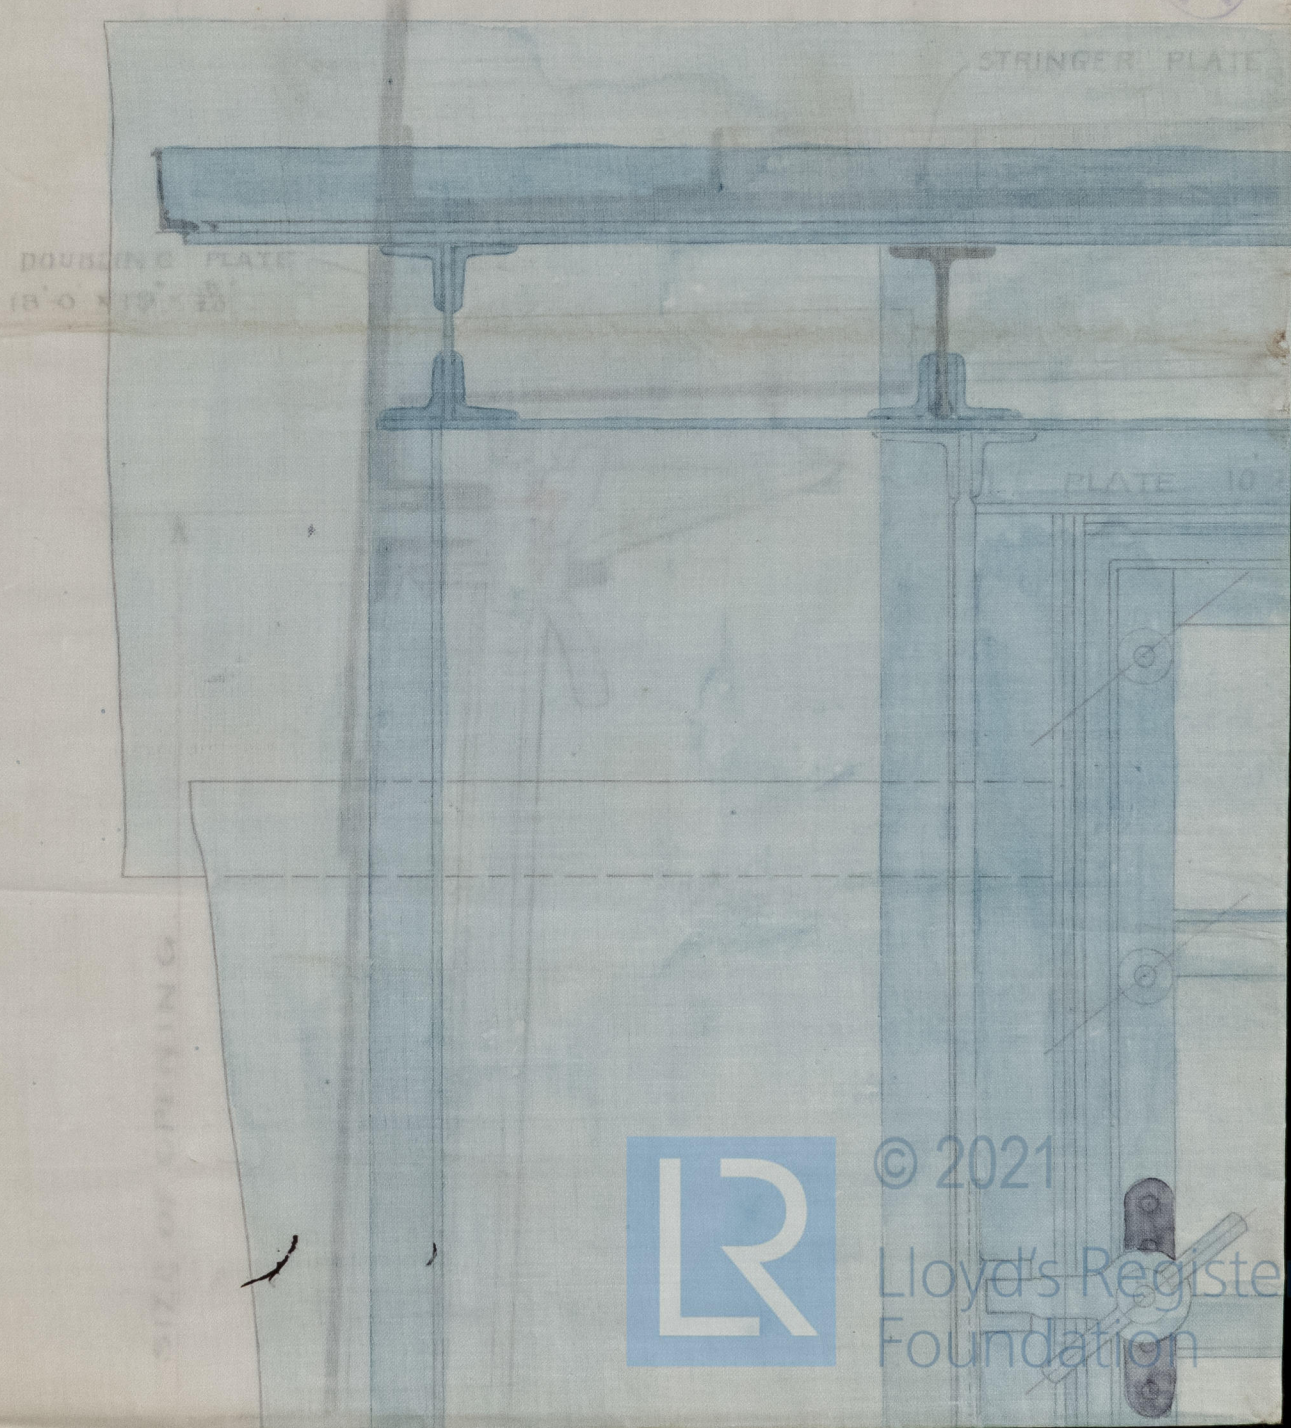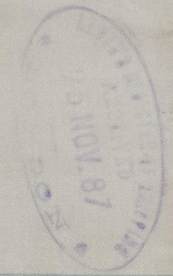

© 2021
Lloyd's Register
Foundation