



Ltr 31/1/88

S. S. "Princess Louise" Glasgow Report No 8443.

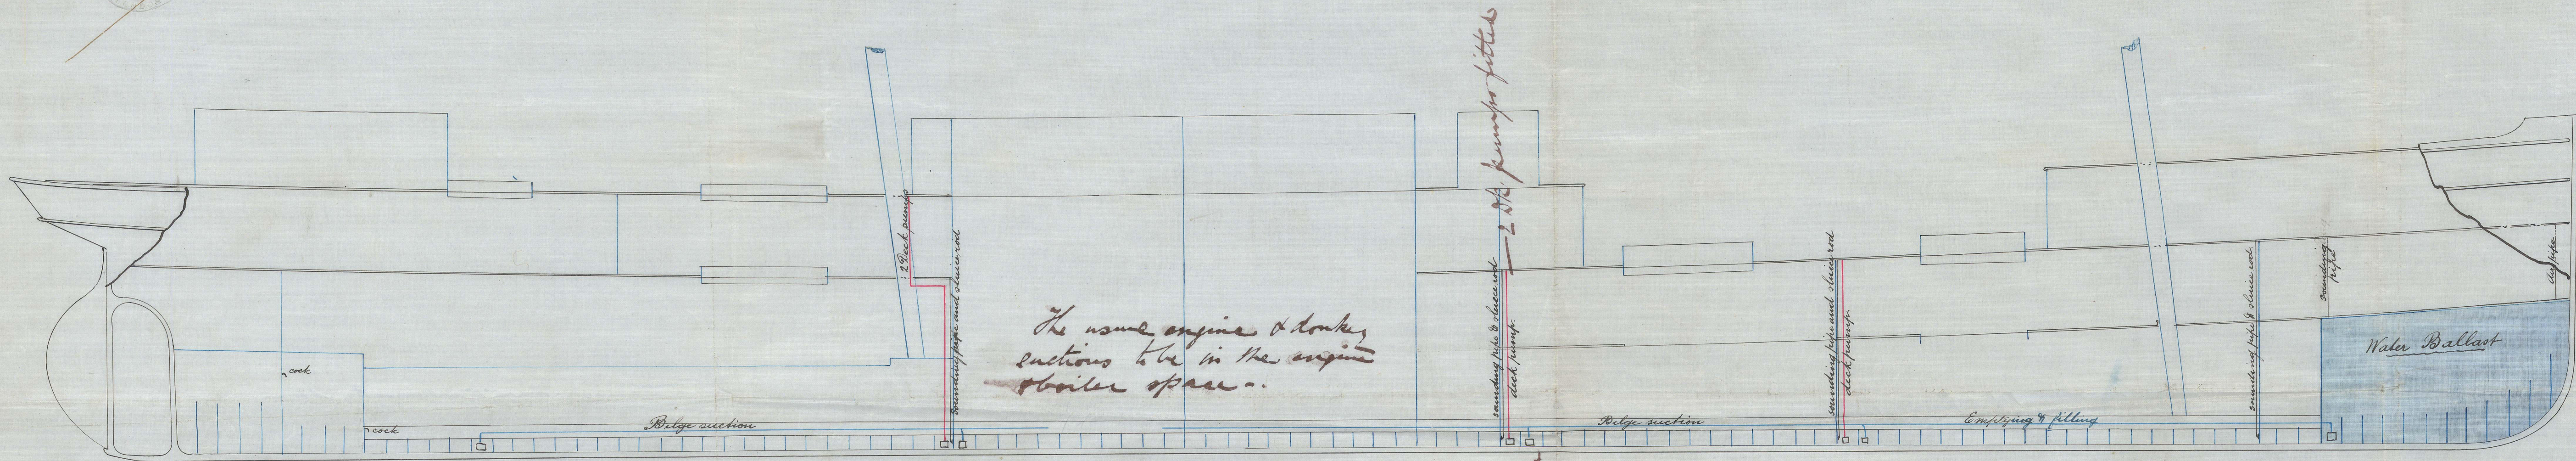

Pumping Arrangements.  
S S No 333  
Scale 1/8" = 1 Foot

No 64  
24

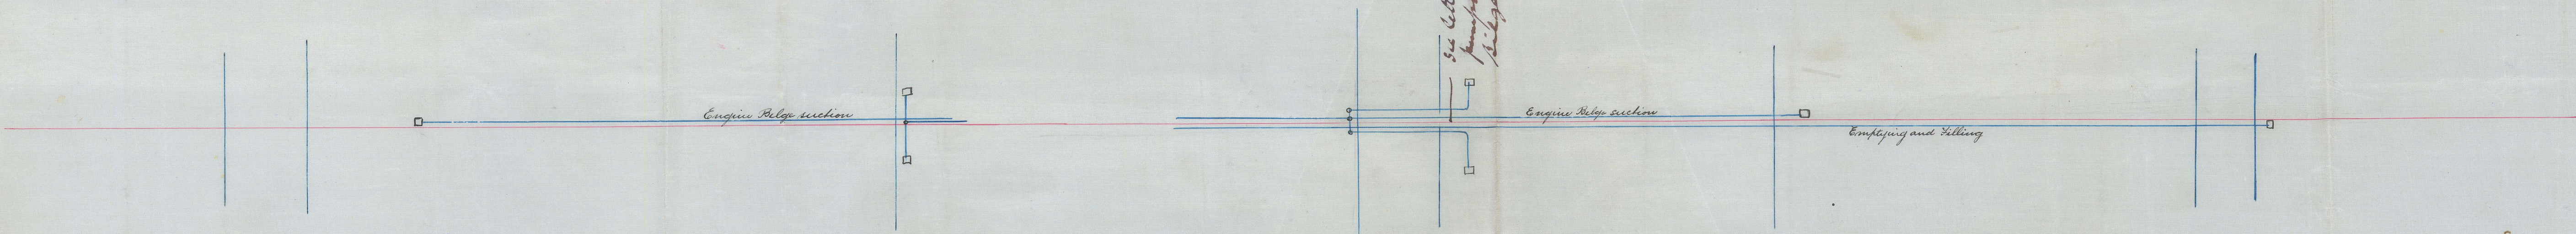

See letter as to deck pumps relieving the bilges &c.

30/1/88

30/1/88



65208-0250



© 2021

Lloyd's Register  
Foundation