
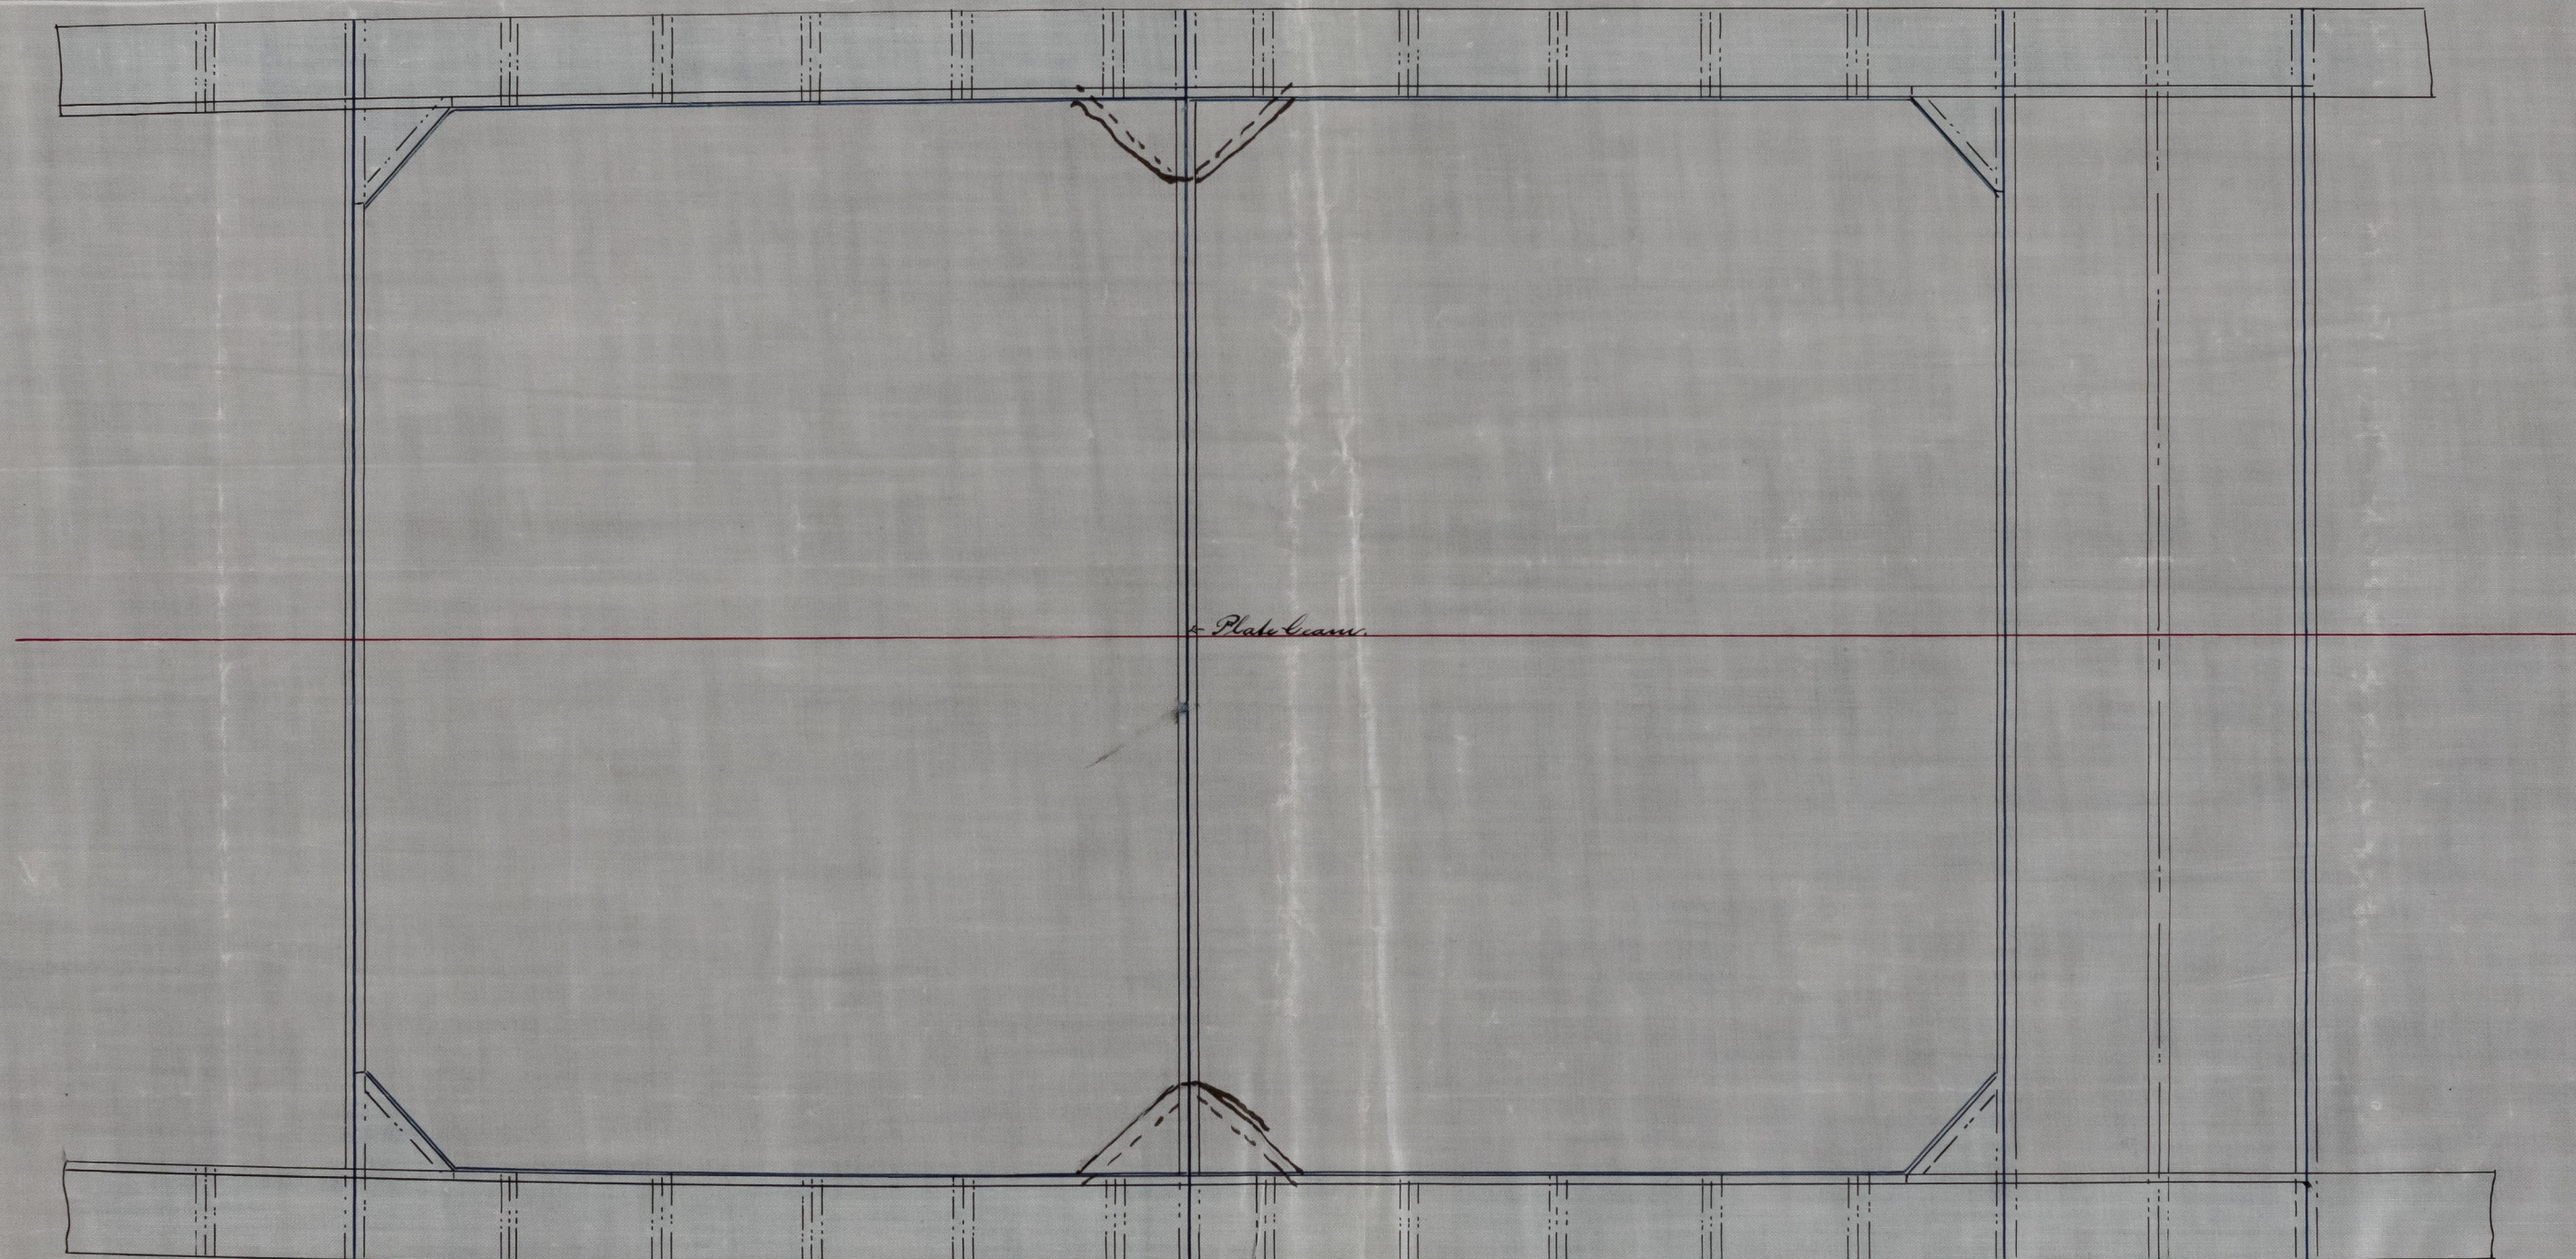


S.S. "Princess Louise" *as fitted* Glasgow Report No. 8443.

S.S. No. 333  
Lower Deck Plan  
Showing transverse & B. space.  
Scale  $\frac{1}{4}$  = one foot.

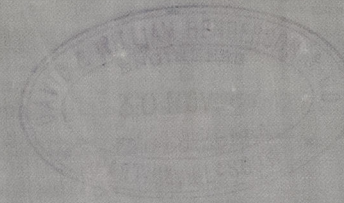

© 2021  
Lloyd's Register  
Foundation

GLS208-0255