

19.10.87.

— S. S. No 333 —



not as fitted

— Longitudinal sketch, showing strong beams. —

~~~~~ IN ~~~~~

— Engine & Boiler Space —

— Scale  $\frac{1}{8}$ " = 1 foot —

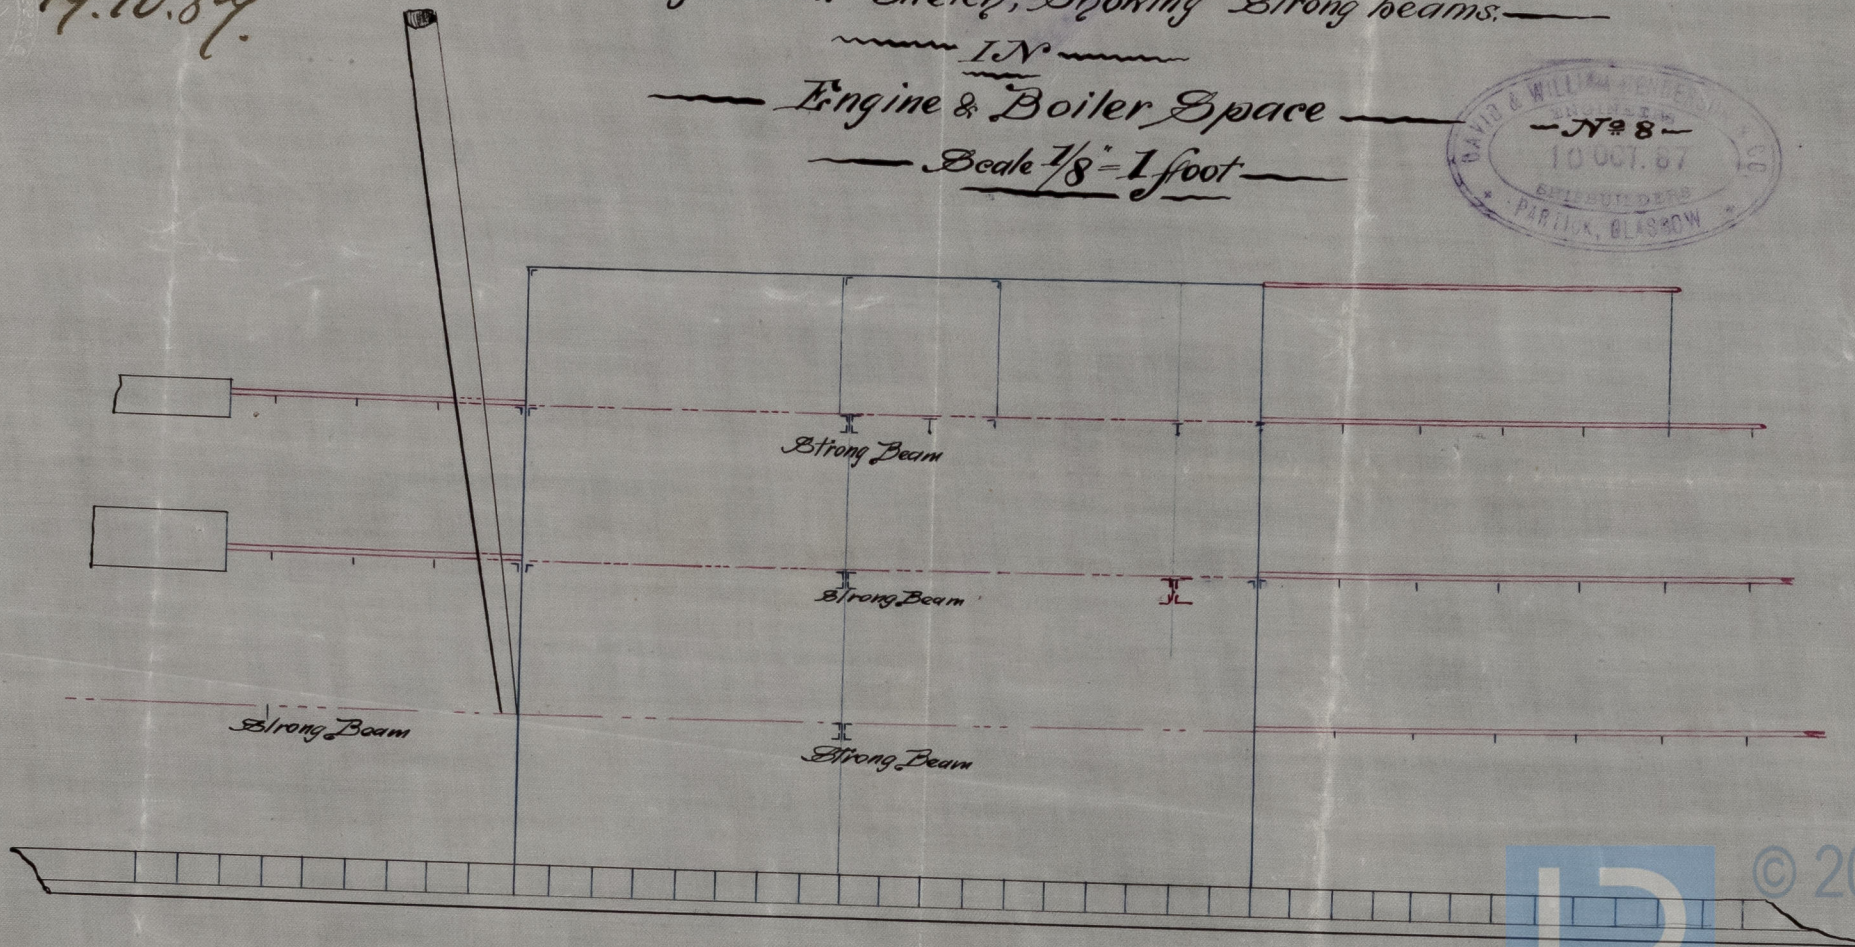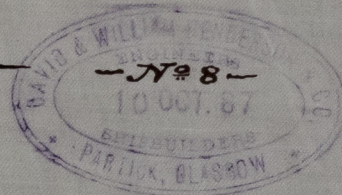

J.P.L.  
19/10/87

© 2021

Lloyd's Register  
Foundation

GL5208-0256