


S.S. 333
Upper Deck Plan Bridge Deck.
Showing beams in way of C. & B spaces.
Scale 1/4" = 1 Foot.

S. S. "Princess Louise"
as fitted
Glasgow Report
No 844/3.

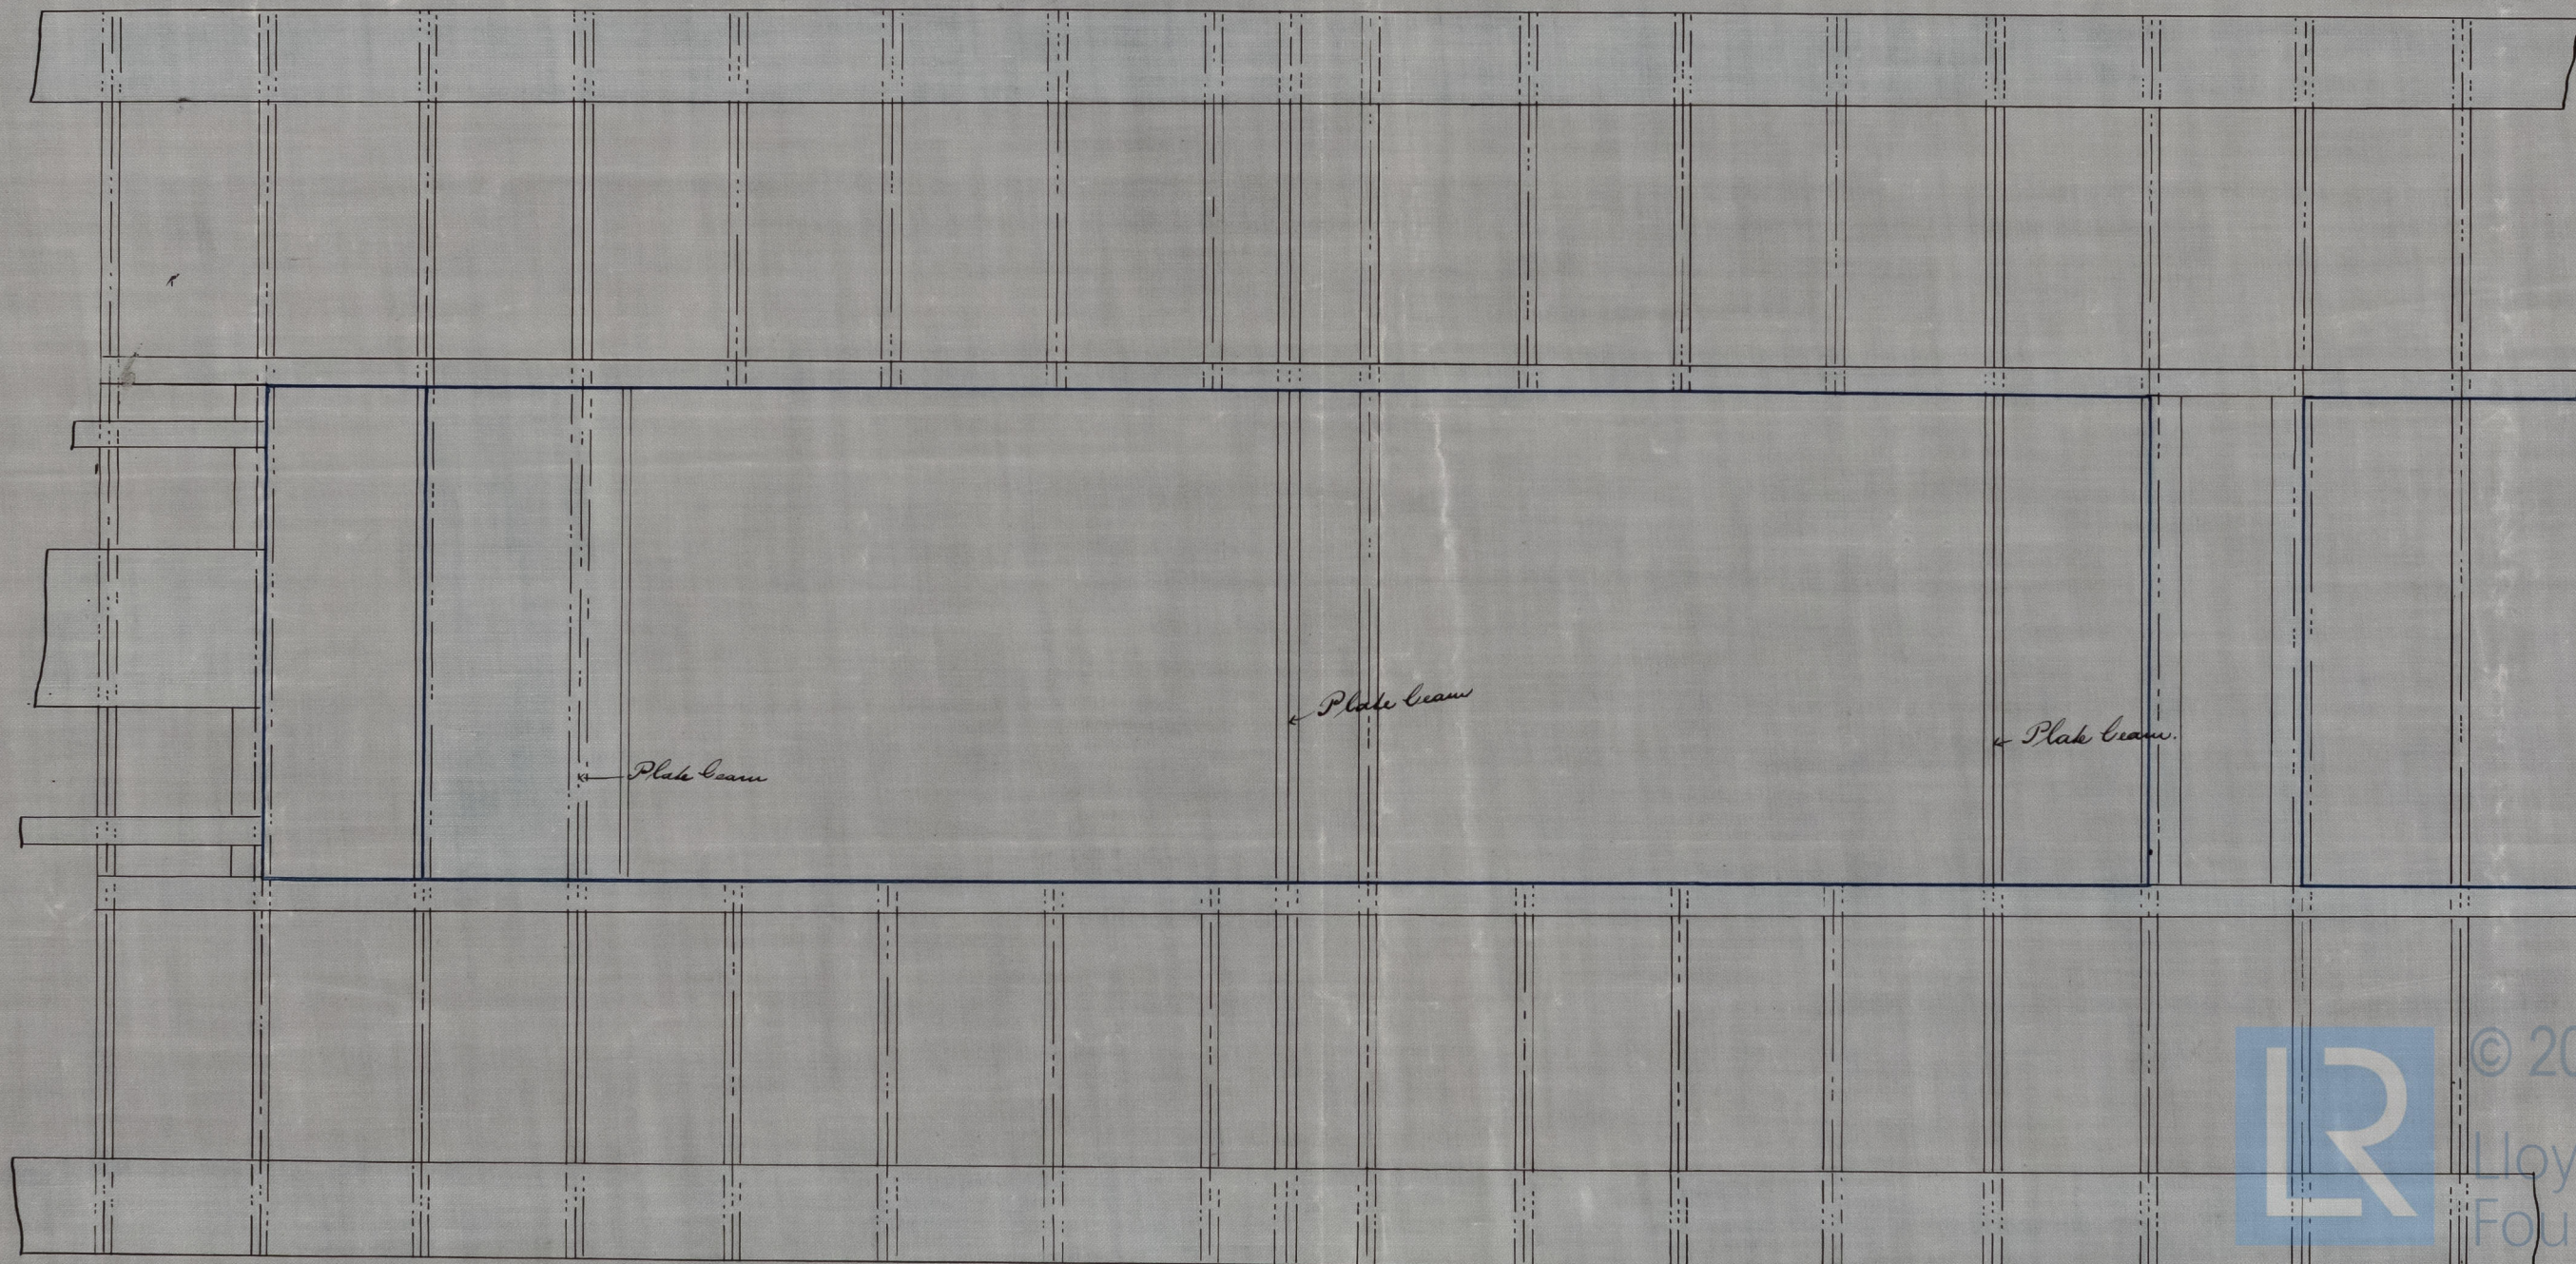

© 2021

Lloyd's Register
Foundation

GLS208-0258