



S. S. Brunner Glasgow Report No. 8524-

H. J. L.
24/11/87.

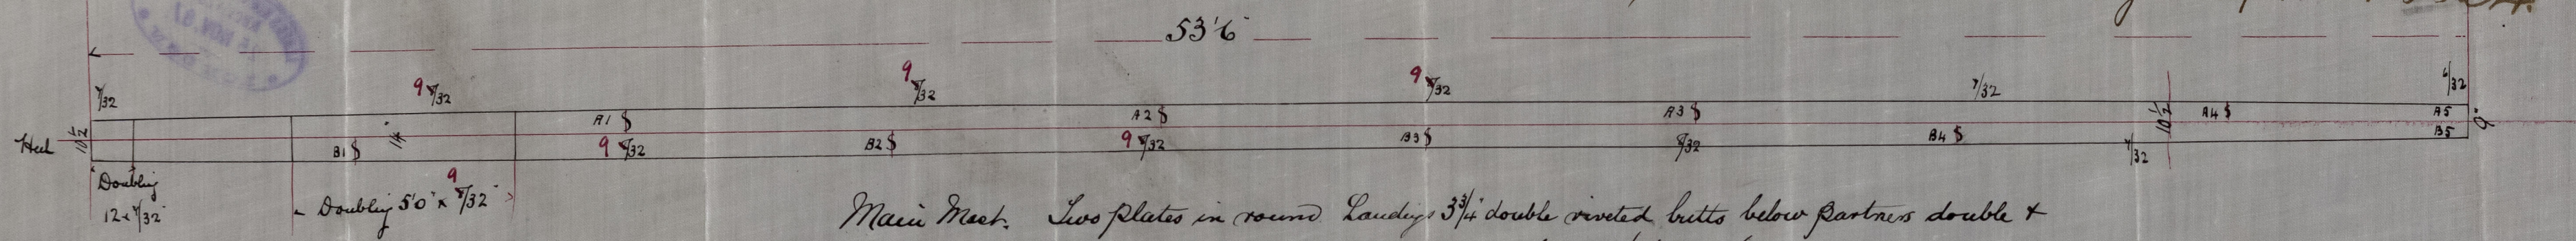


Main Mast. Two plates in round Landings $3\frac{3}{4}$ " double riveted butts below partners double & butts above partners treble riveted Straps $\frac{1}{16}$ " thicker

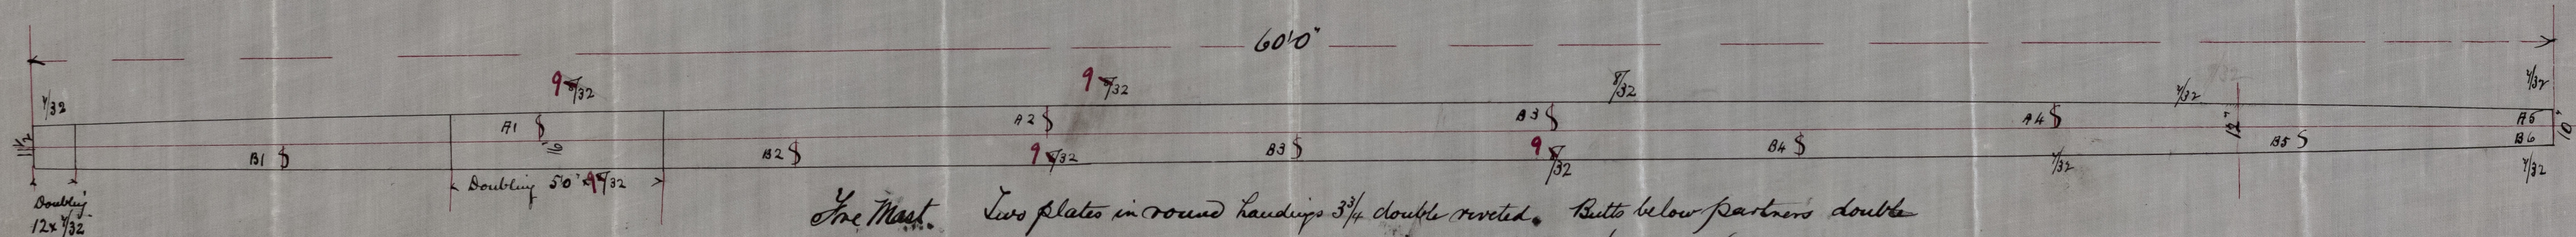

Fore Mast. Two plates in round Landings $3\frac{3}{4}$ " double riveted. Butts below partners double & butts above ditto treble riveted. Straps $\frac{1}{16}$ " thicker

26.11.87.

J. P. L.
26/11/87

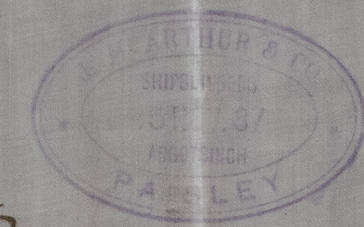

Steel Masts S. S. No. 48
Scale $\frac{3}{8}$ " = 1 foot



© 2021
Lloyd's Register
Foundation



15/35









8.11.85

© 2021

Lloyd's Register
Foundation

GLS209-0068