Revised Midships Section of Screw Steamer No 48

1/2 2'0" x 26'0" x 13'10 7/20 M.

To class 100A Special Survey Steel

Scale 1/2" = 1 foot.

From Messrs J. McArthur & Co
Abbotsinch
Paisley

J. McARTHUR & CO. SHIPBUILDERS 15 OCT. 87 ABBOTSINCH PAISLEY

H.E.K. 17/10/87. 20/10/87.

1/2 B.	13:0
1/2 Grt.	14:37
Depth	24:57
	51·91
	170·91
2nd N.	8871·93
Equip. N.	9492·96

1/2 Breadth	13·0
1/2 Girth	24·6
Depth	14·37
1st Numeral	51·91
Length	170·91
	5191
	46773
	363790
	5191
2nd Numeral	8882·1924
	622
Equipt. Numeral	9504
Breadth to Length	6·5
Depth to Length	11·8

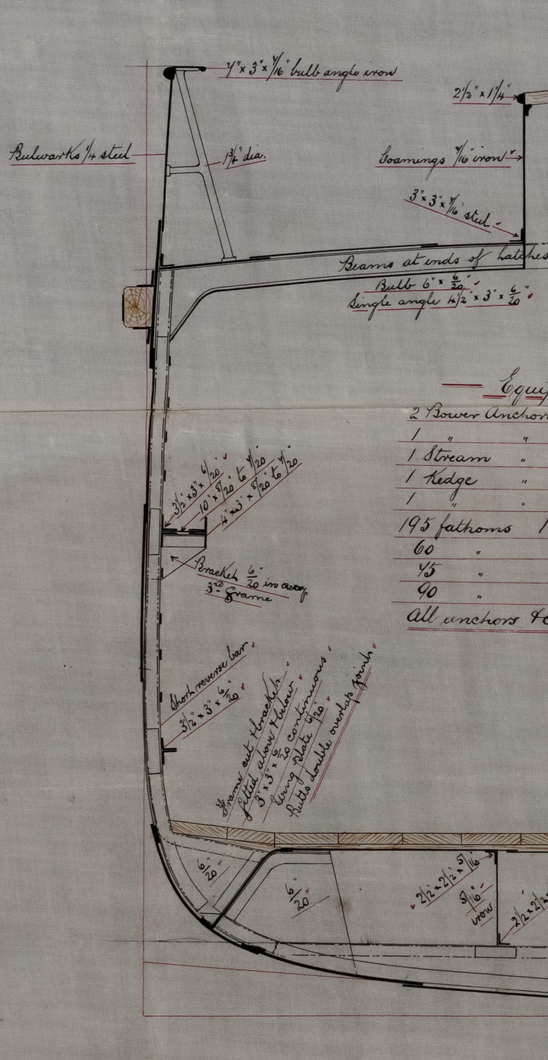

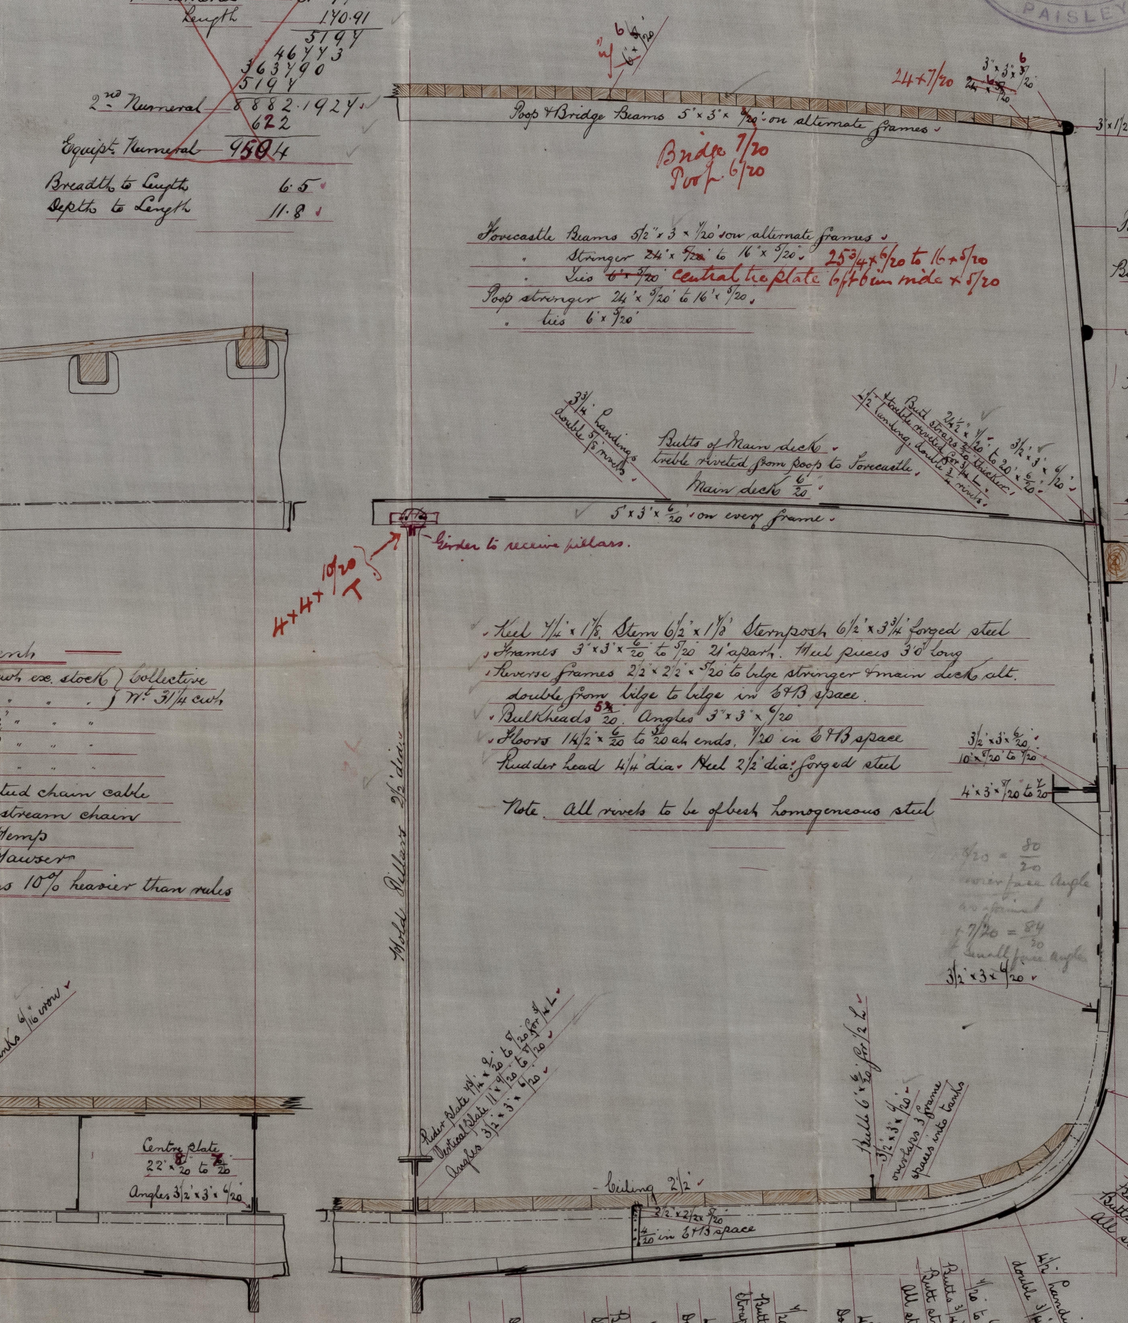

© 2021 Lloyd's Register Foundation
GLS2041 0004

© 2021 Lloyd's Register Foundation

G-L5209-0069

LLOYD'S REGISTER OF SHIPPING RECEIVED 25 NOV. 87 LONDON
LLOYD'S REGISTER OF SHIPPING RECEIVED 15 DEC. 87 LONDON
LLOYD'S REGISTER OF SHIPPING RECEIVED 18 OCT. 88 LONDON
LLOYD'S REGISTER OF SHIPPING RECEIVED -2 MAY. 88 LONDON