

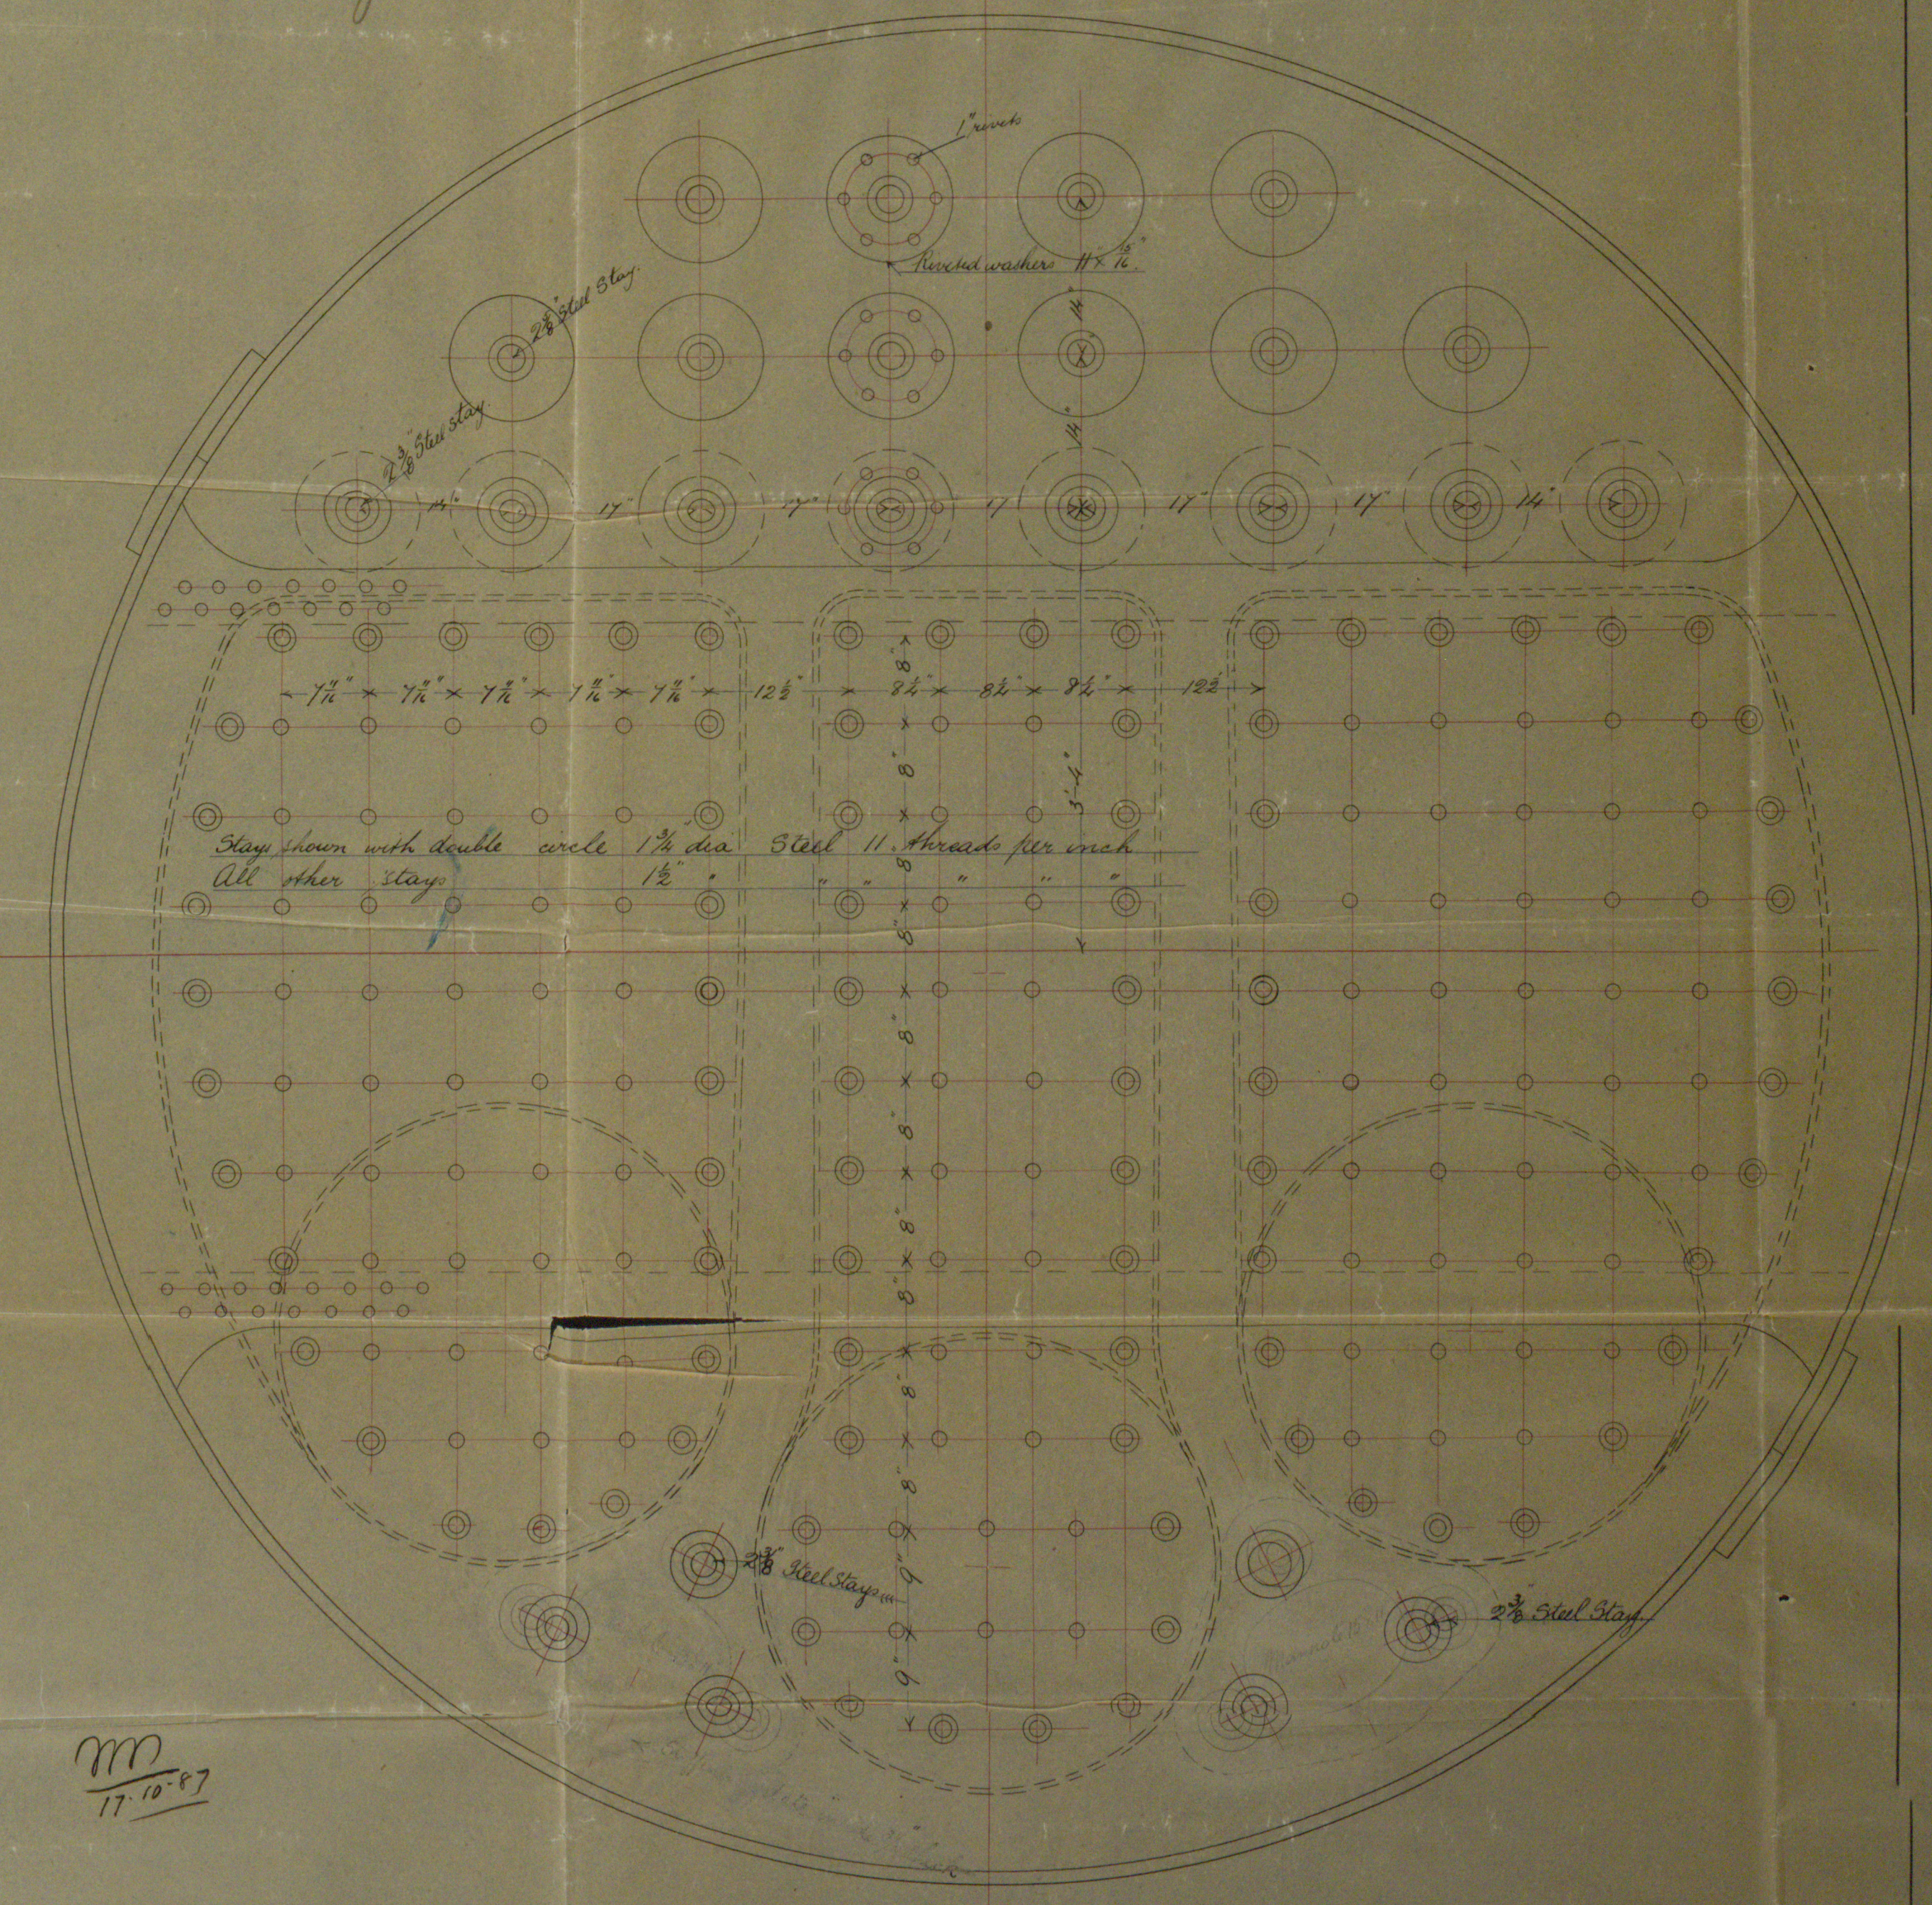
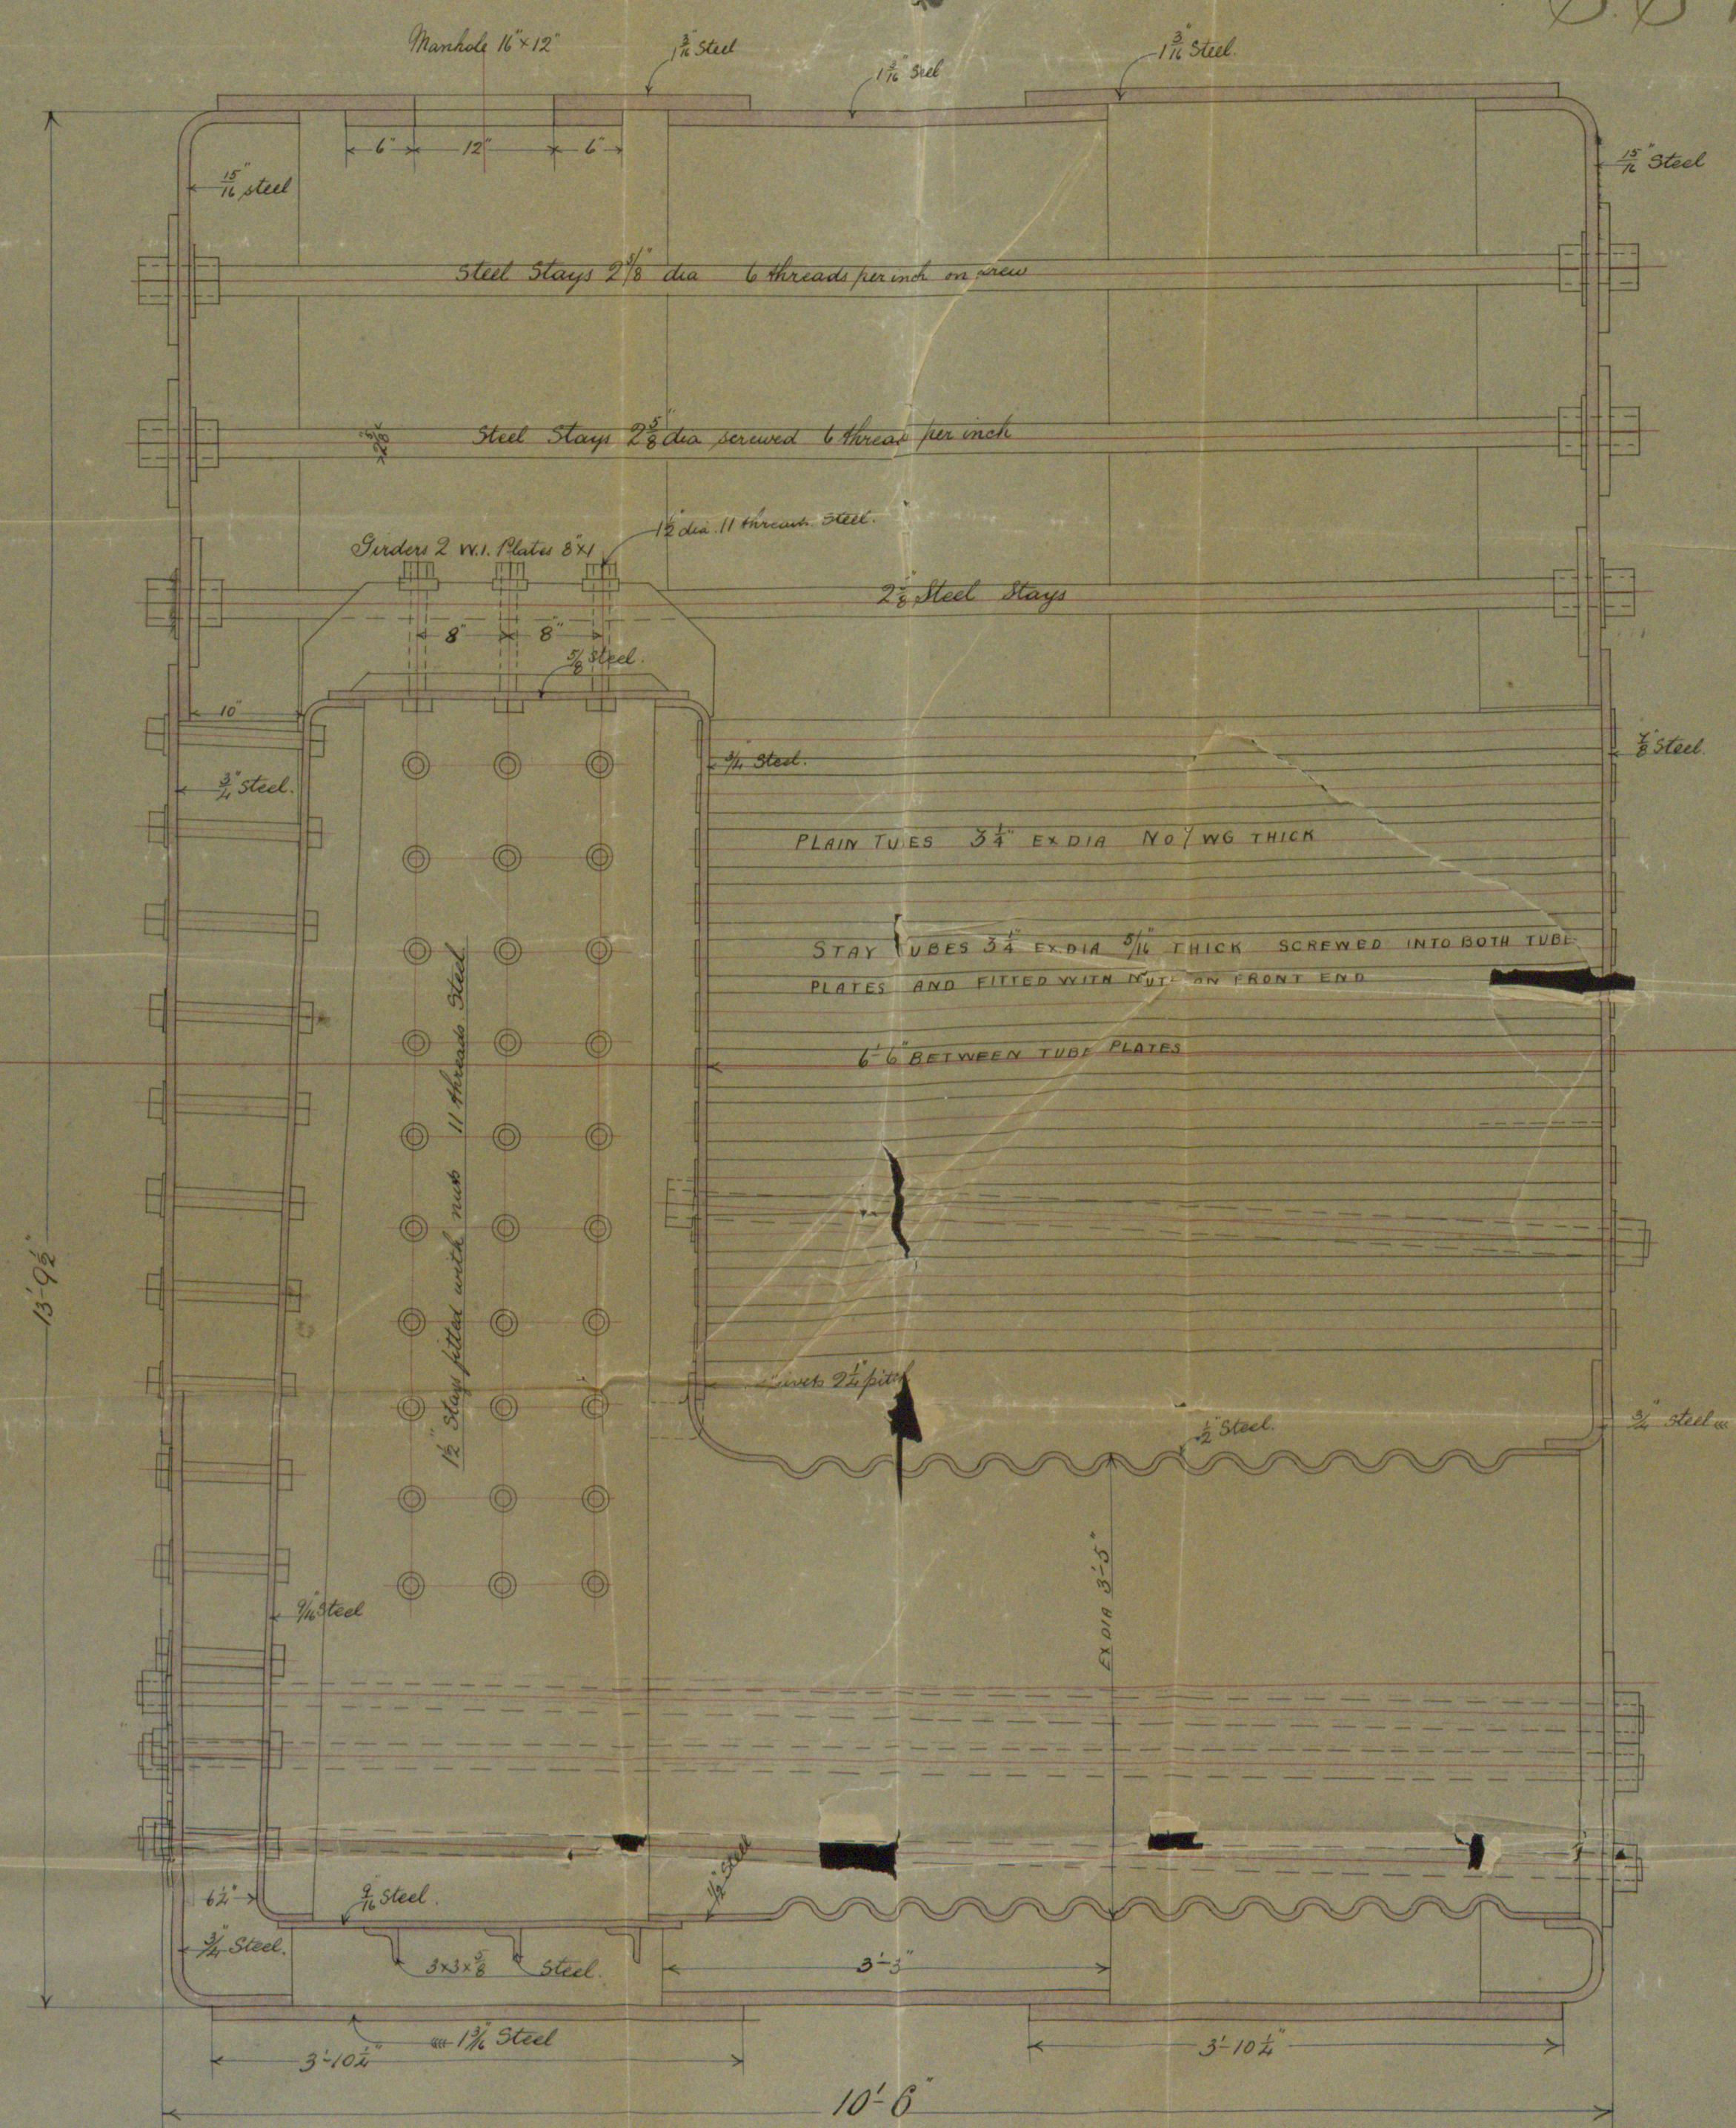
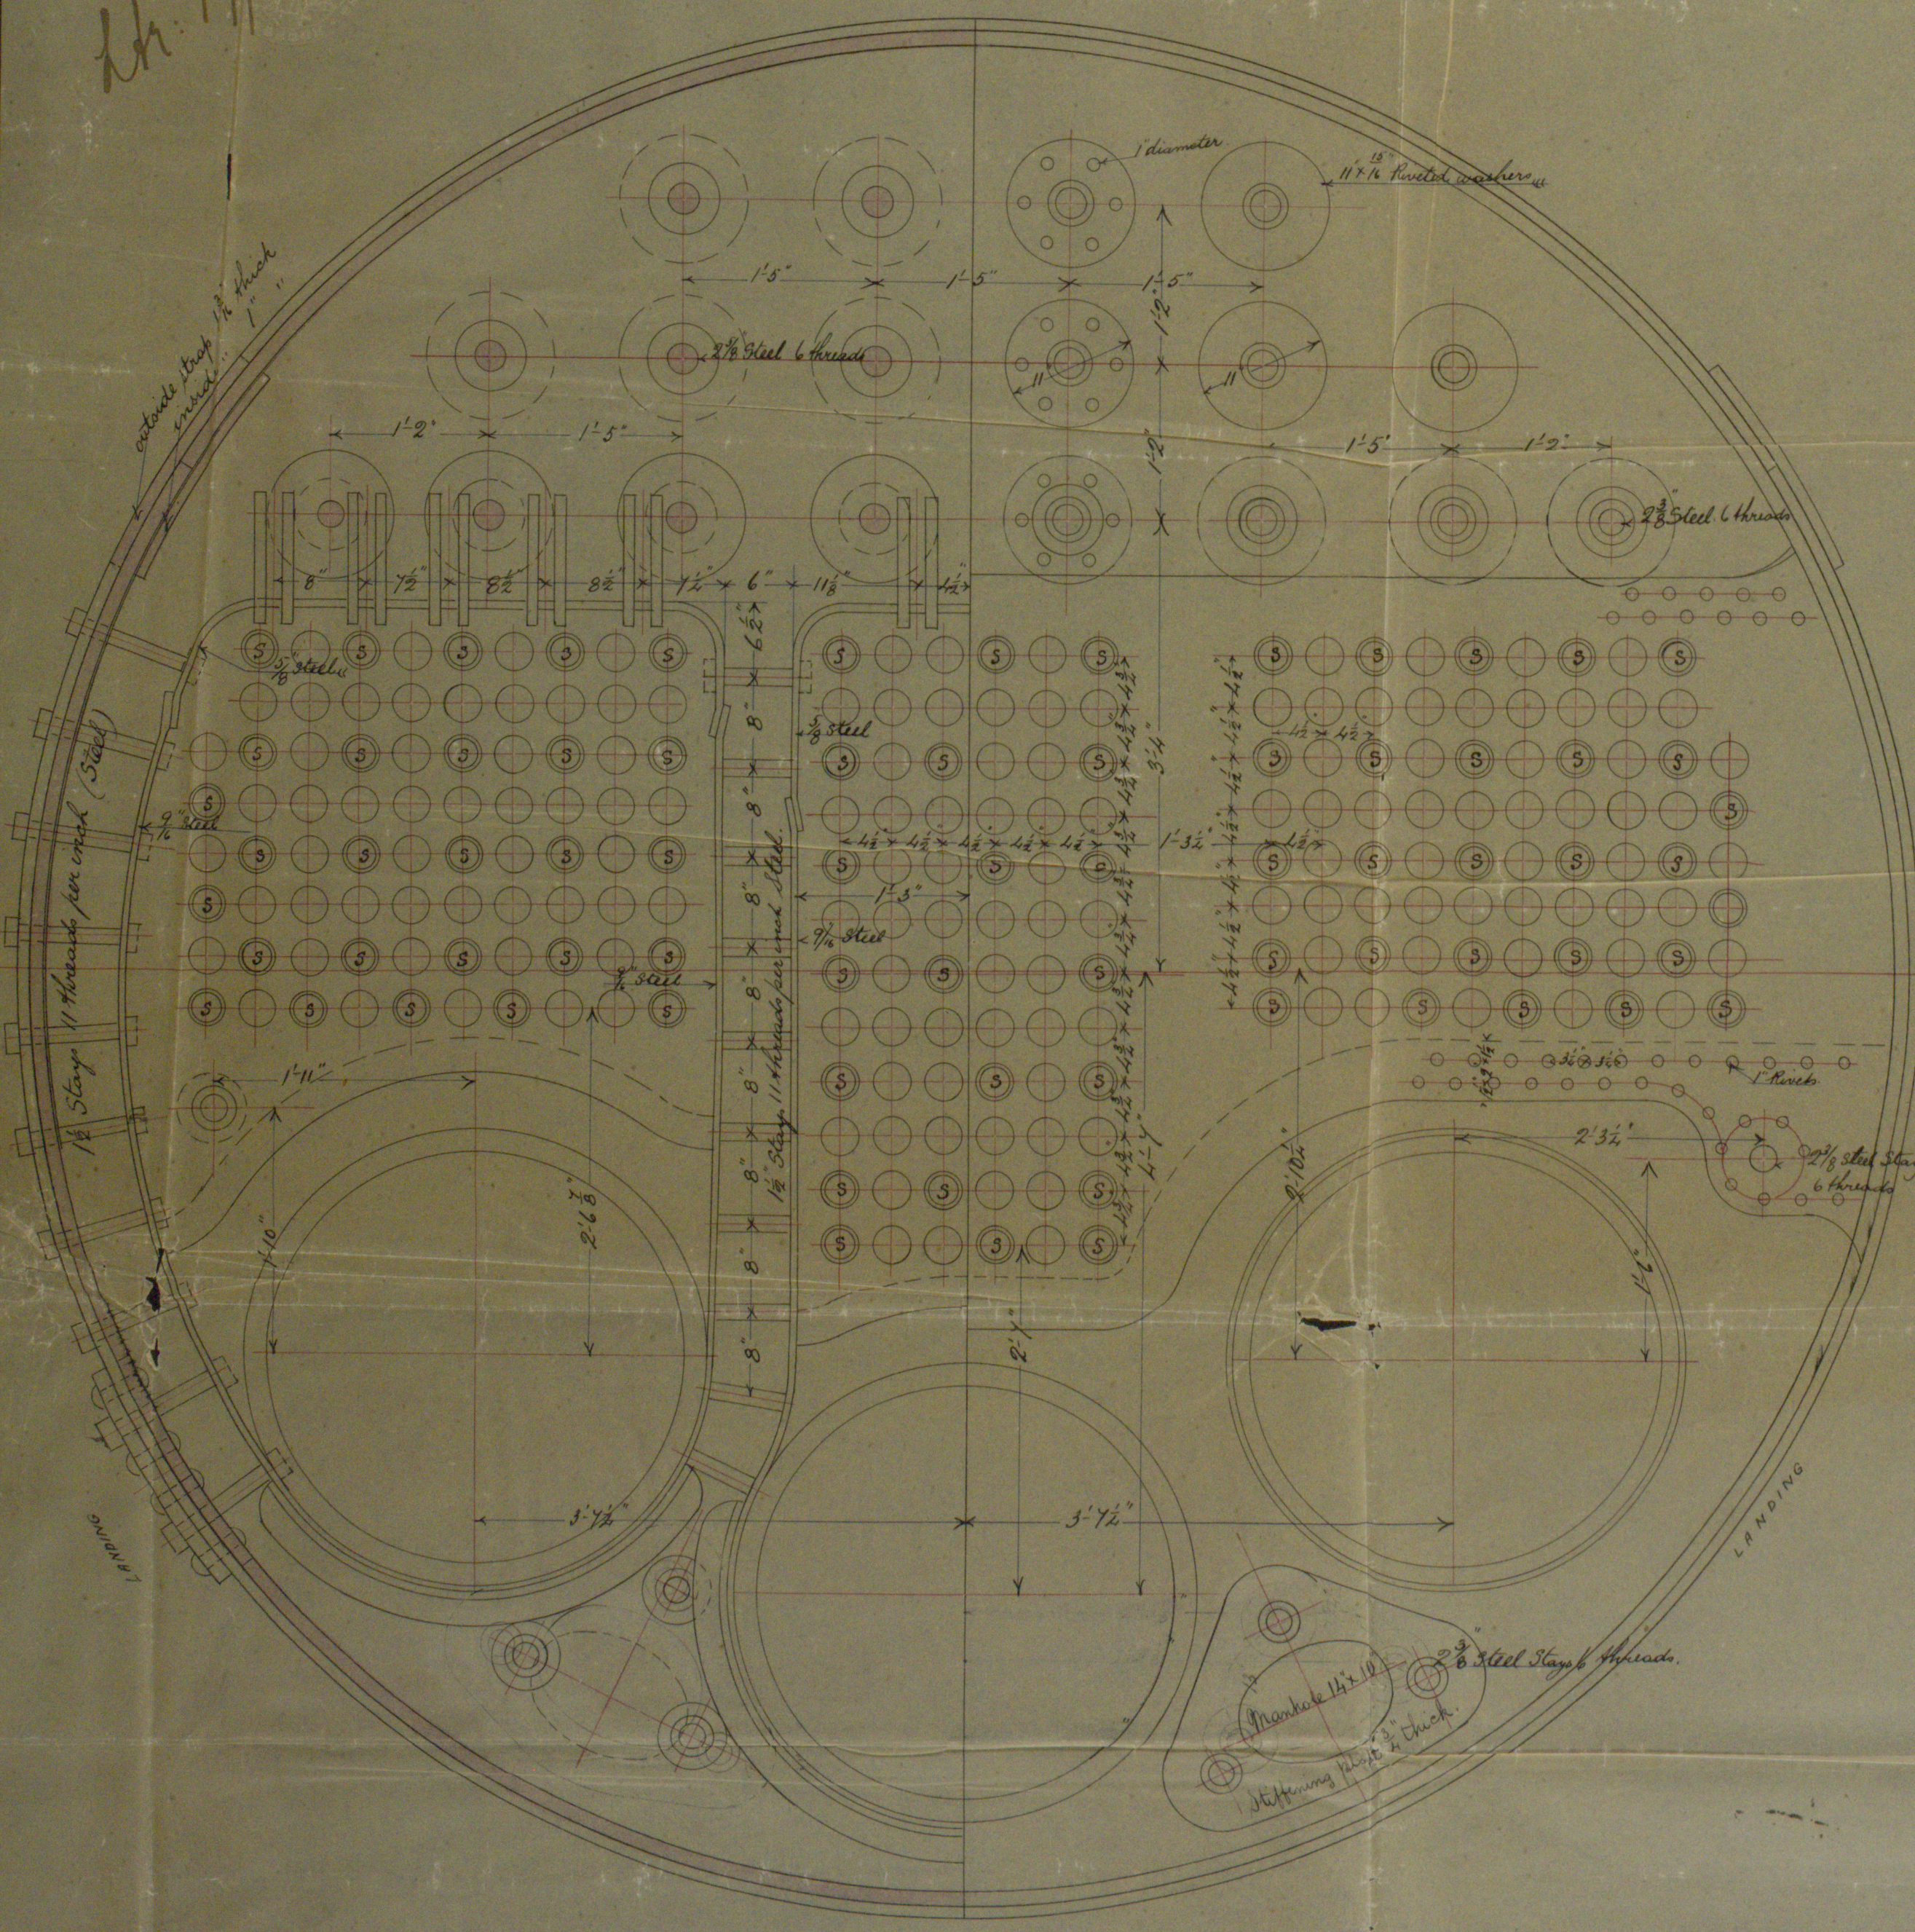


24. 17/10/07


S.S. "Brunner" Glasgow Report No 8521.

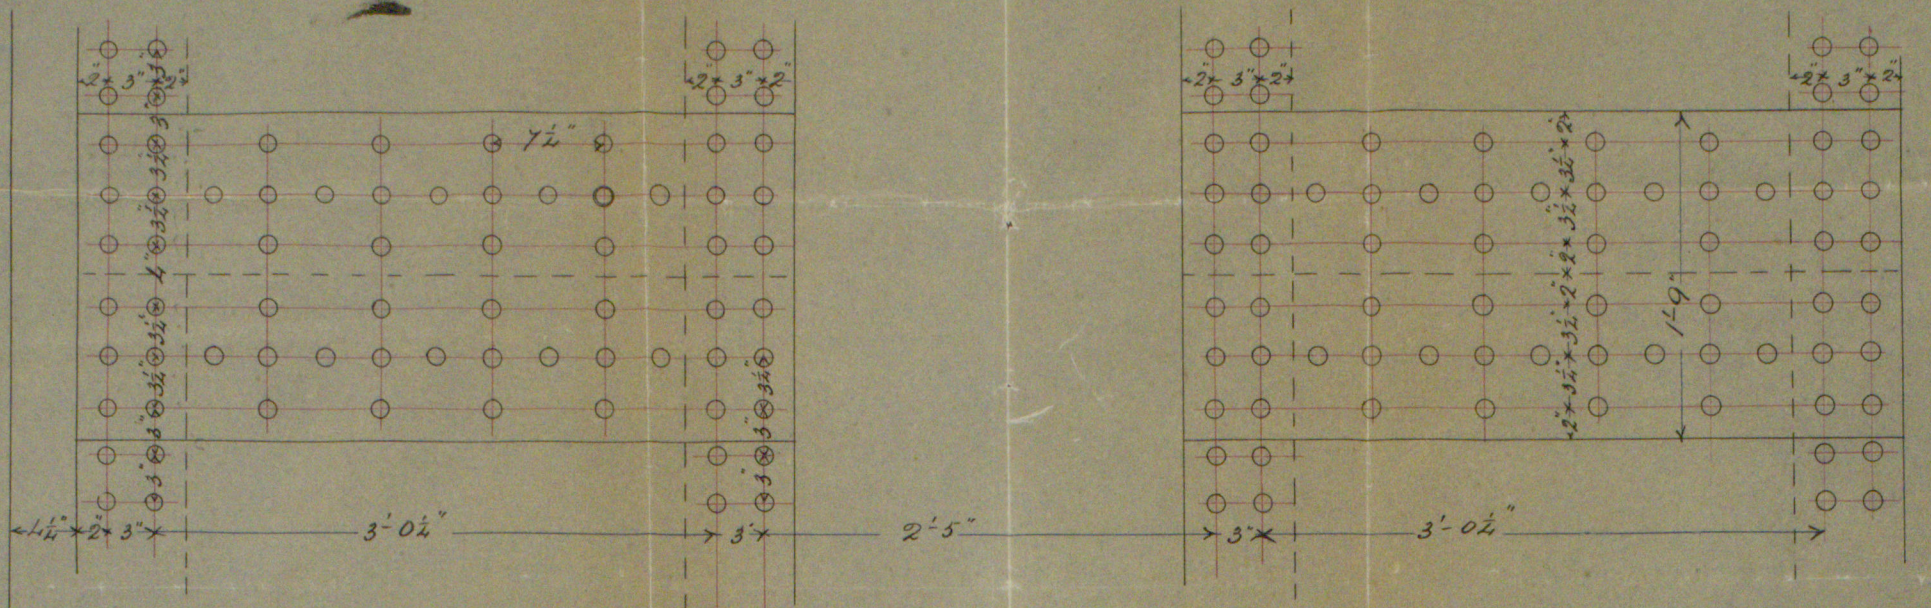

BOW, McLACHLAN & CO
ENGINEERS & IRONFOUNDERS
THISTLE WORKS
PAISLEY

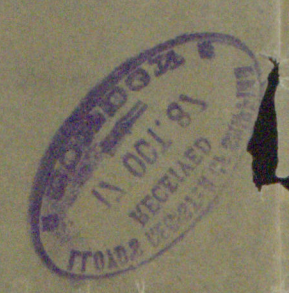

All holes drilled on place
Steel rivets 1/2" dia finished.
Circumferential joints 3' pitch

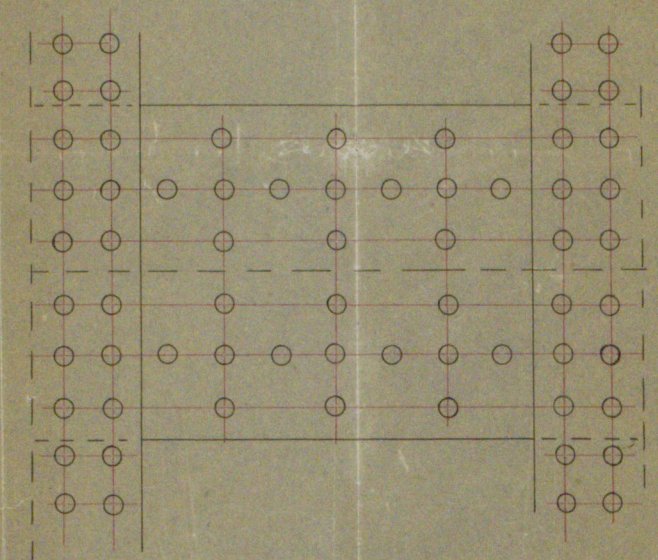


MARINE RETURN TUBE BOILER No 203

Scale One inch = One foot

WORKING PRESSURE 150 LBS.


BOW, McLACHLAN & CO
ENGINEERS & IRONFOUNDERS
THISTLE WORKS
PAISLEY

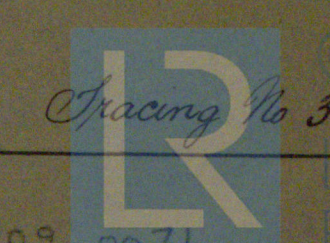

GL5209-0071

GLS209-0071


PAISLEY
THISTLE WORKS
ENGINEERS & IRONFOUNDERS
BOW, Mc LAHLAN & CO

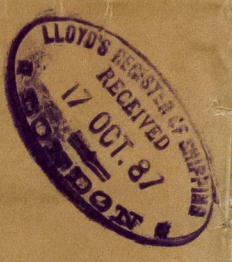

WORKING PRESSURE 150 LBS.

PAISLEY
THISTLE WORKS
ENGINEERS & IRONFOUNDERS
BOW, Mc LAHLAN & CO

MARINE RETURN TUBE BOILER No 203

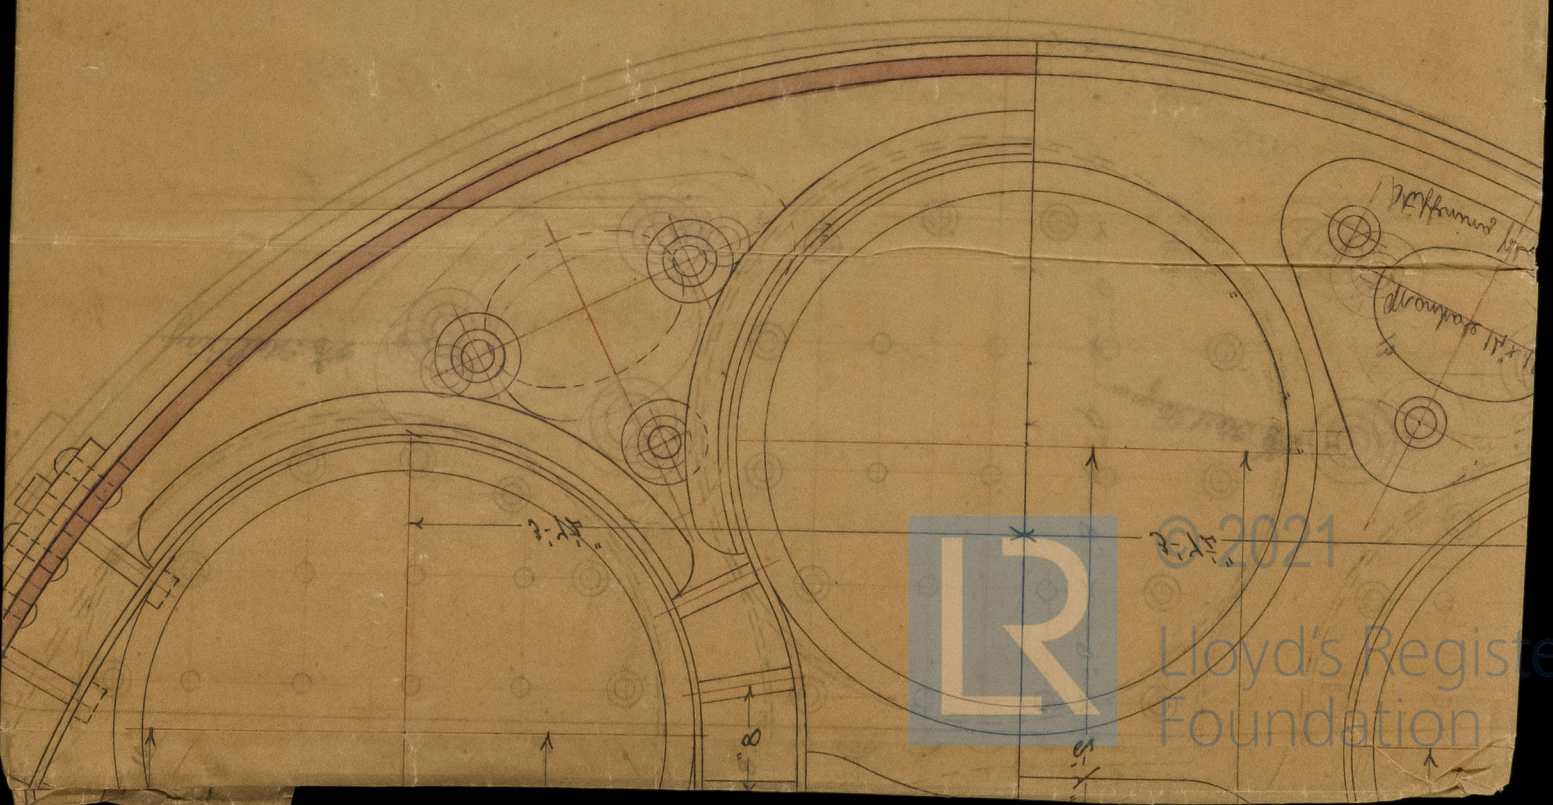

© 2021
Lloyd's Register
Foundation