

Lloyd's Register of British and Foreign Shipping.

(Report on Vessel No. 8590 Port Glasgow)

S.S. "Baikis Maru."

No. 1493

SHIP FORGINGS ~~OR CASTINGS~~

I have to report that the undermentioned Iron ~~or Steel~~ Forgings ~~or Castings~~, manufactured by Messrs Wm Beardmore & Co. of Glasgow for the Vessel No. 255, being built by The London & Glasgow S. B. Co. of Glasgow. have been inspected by me as set forth below, and found to be, so far as can be seen, sound and efficient.

The words FORGINGS or CASTINGS, IRON or STEEL, should be struck out as may be required.

Mark on Forgings.


Lloyd's
No. 1493
G. N.

George Newcomb.
Glasgow.

9/12/84.

| | STERN FRAME. | RUDDER FRAME. | STEM. |
|------------------------|--------------|---|-------|
| Material* | / | Scrap iron. | / |
| How made | | Forged. | |
| Dimensions | | 8 1/4 dia | |
| Progress on Inspection | | Forging & smithing | |
| Dates when Inspected | | 15.19.24/6/84. 11.14.22.26/10/84. 1.4.23/11/84. 6/12/84. | |

SKETCHES OF FRAMES SHEWING POSITION AND DESCRIPTION OF WELDS OF FORGINGS, OR PARTICULARS OF TESTS APPLIED TO CASTINGS.

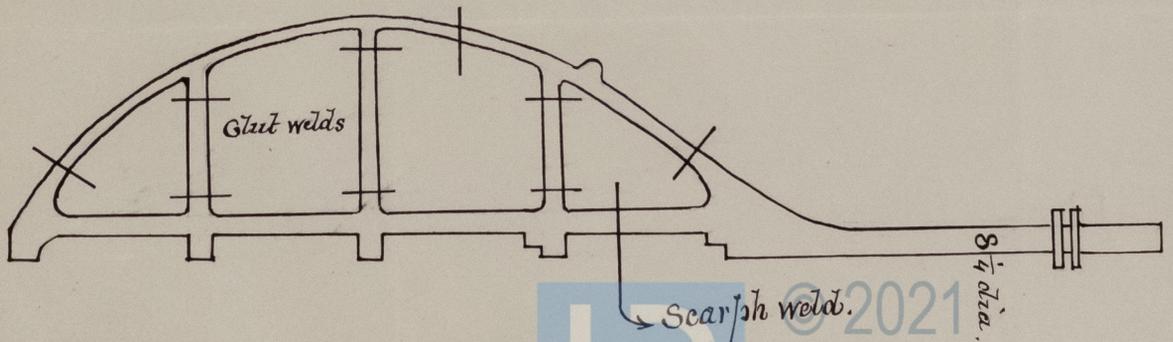

* If of Iron, state whether scrap or puddled iron.

