


S. S. "Hobe Maru."  
Glasgow Report 18764.

DIAMETER OF RIVET  $\frac{1}{16}$  FINISHED ——— STEEL RIVETS ———  
 PERCENTAGE OF PLATE 61.3 ———  
 PERCENTAGE OF RIVET 53 ———  
 PITCH 3 9/16 ———  
 128 RIVETS IN THE CIRCUMFERENCE ———  
 ALL HOLES DRILLED IN PLACE AFTER BENDING ———

2 off

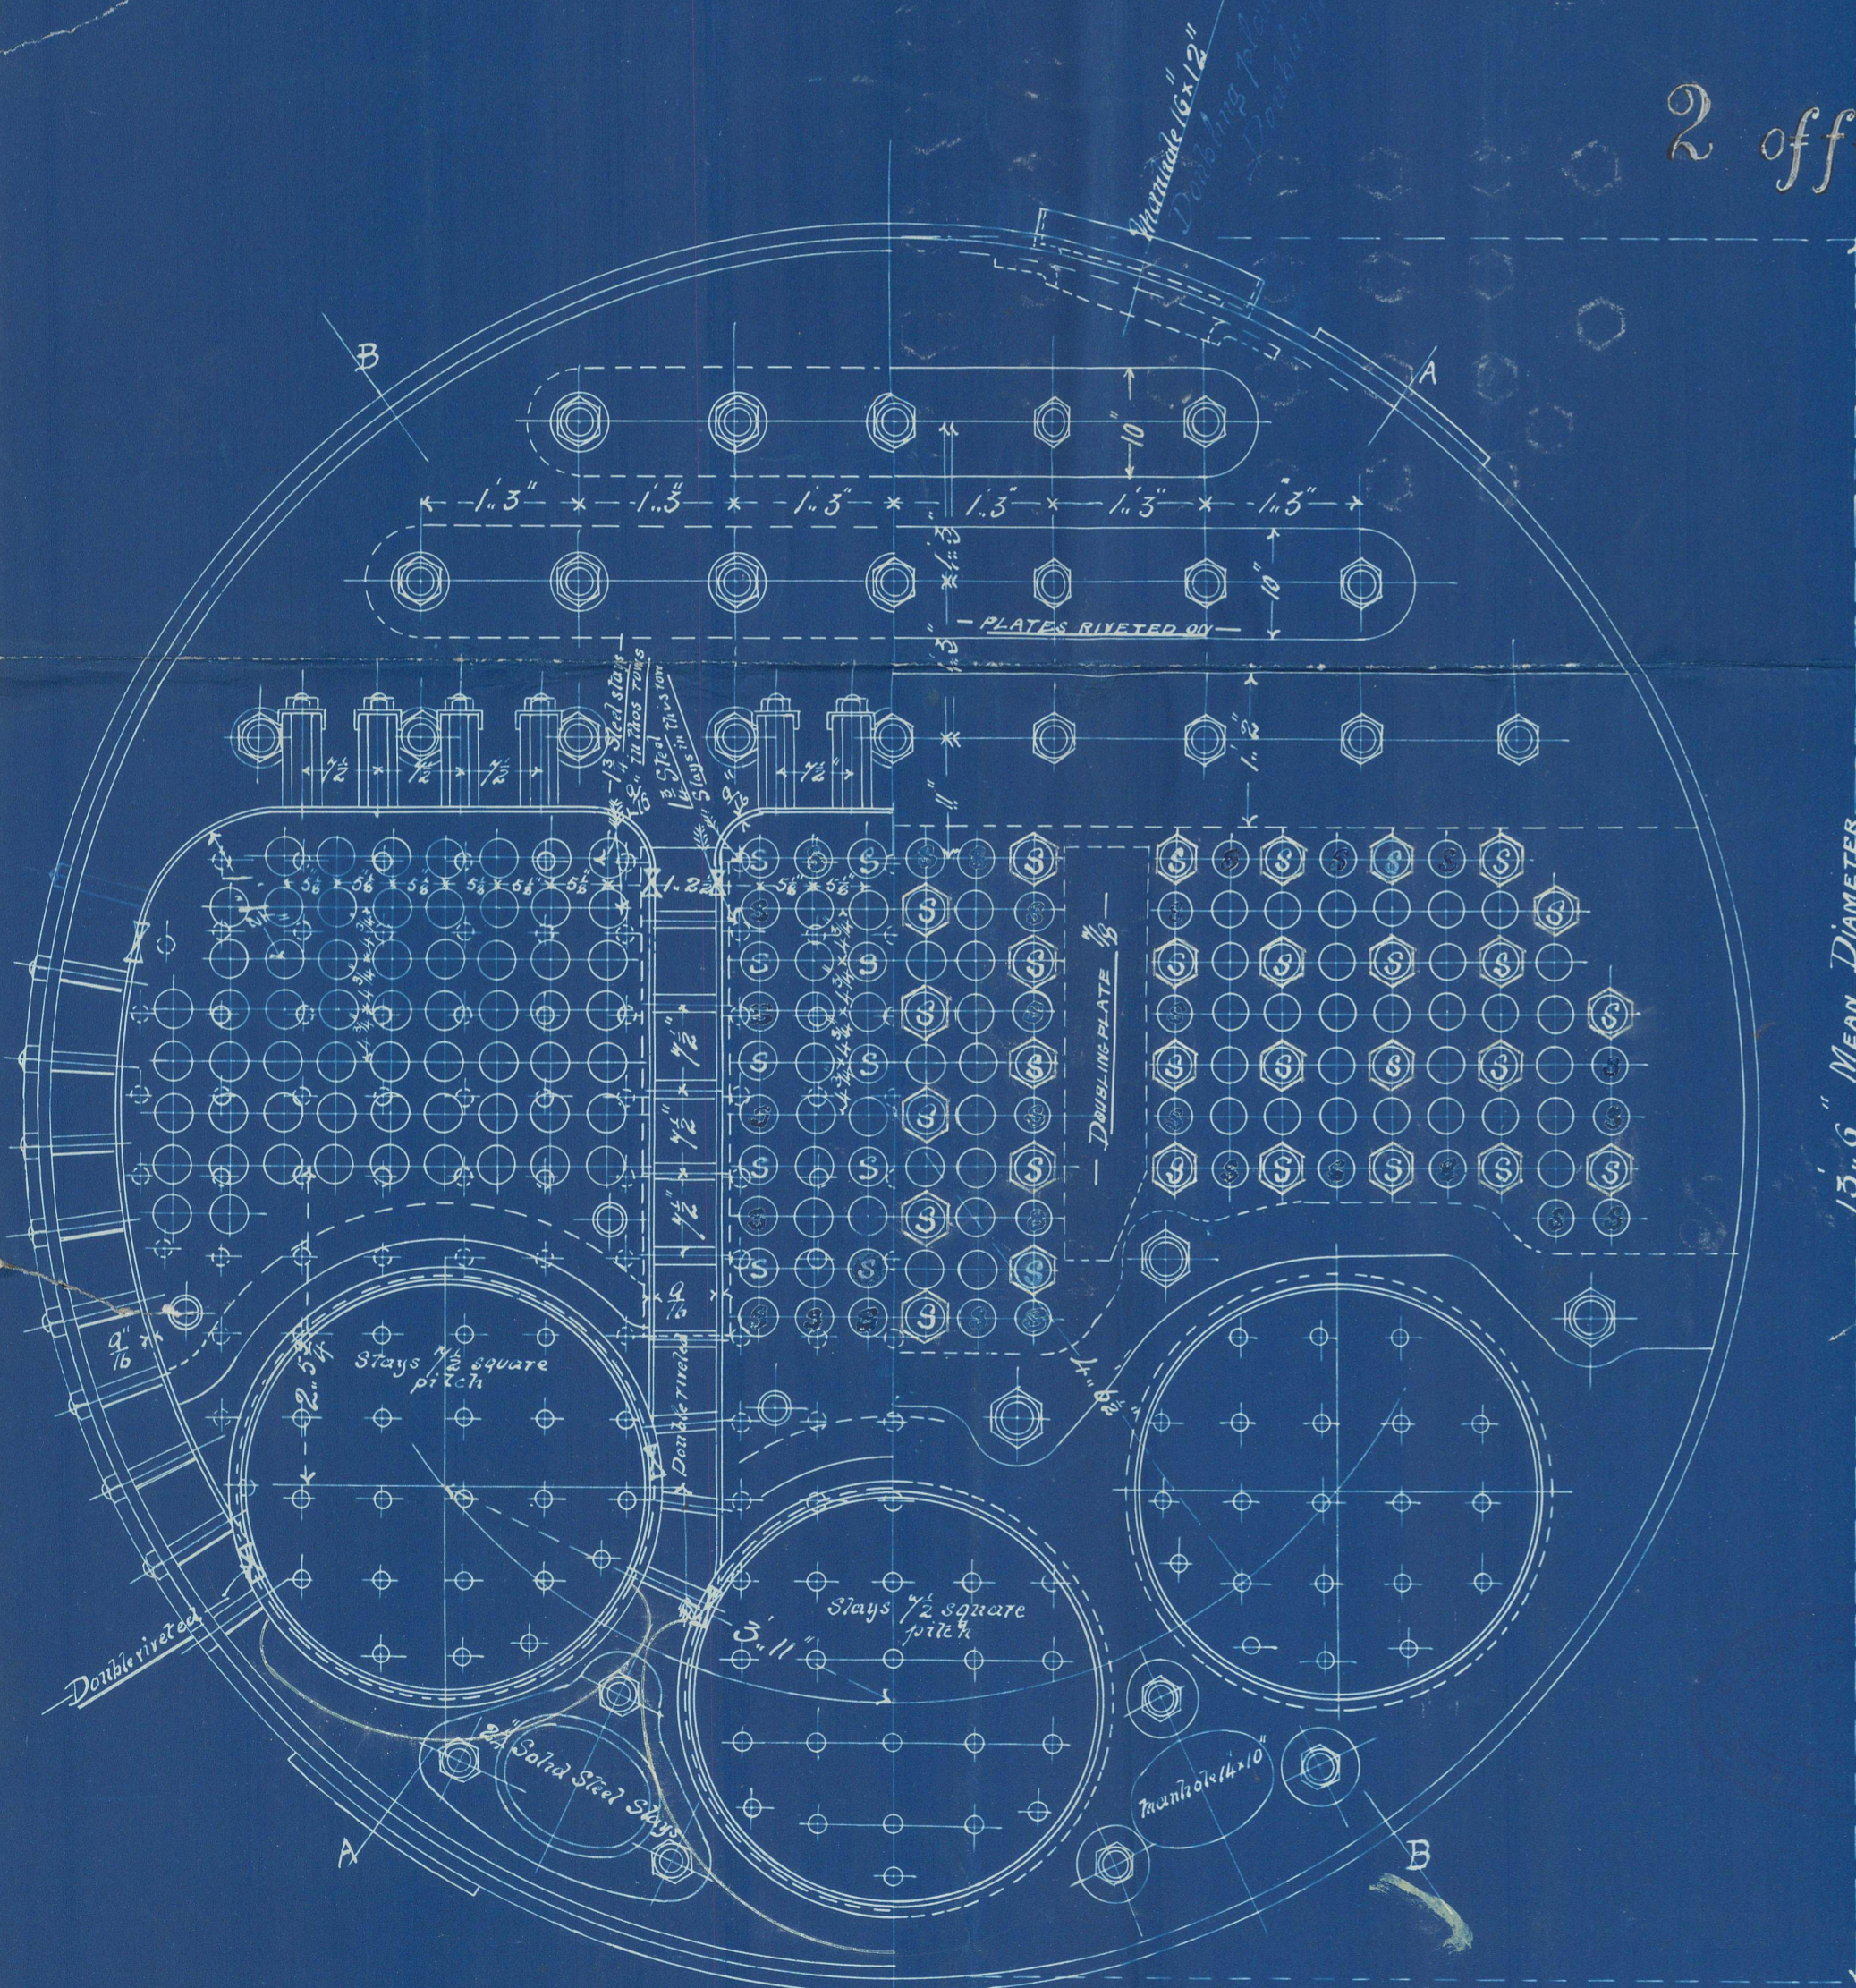

WORKING PRESSURE 160 LBS. PER SQ. INCH

SCALE  $\frac{3}{4}$ " = ONE FOOT—

LONDON &amp; CLASCOM

ENGINEERING & IRON SHIP BUILDING CO  
(LIMITED)

GLASGOW & COVAN

GLASGOW & COY



GLS209-0248

