


*Book 8 of 10
1898/99*

*S. S. "Saikio Maru" Glasgow Report No. 8590
S. S. "Kobe Maru" Glasgow Report
No. 8764.*

*Diameter of rivet 1 1/8" Finished
118 Rivets in the circumference
Percentage of Plate 88.3
Percentage of Rivets 69.8
Pitch 4.54*

All Holes drilled in place after bending

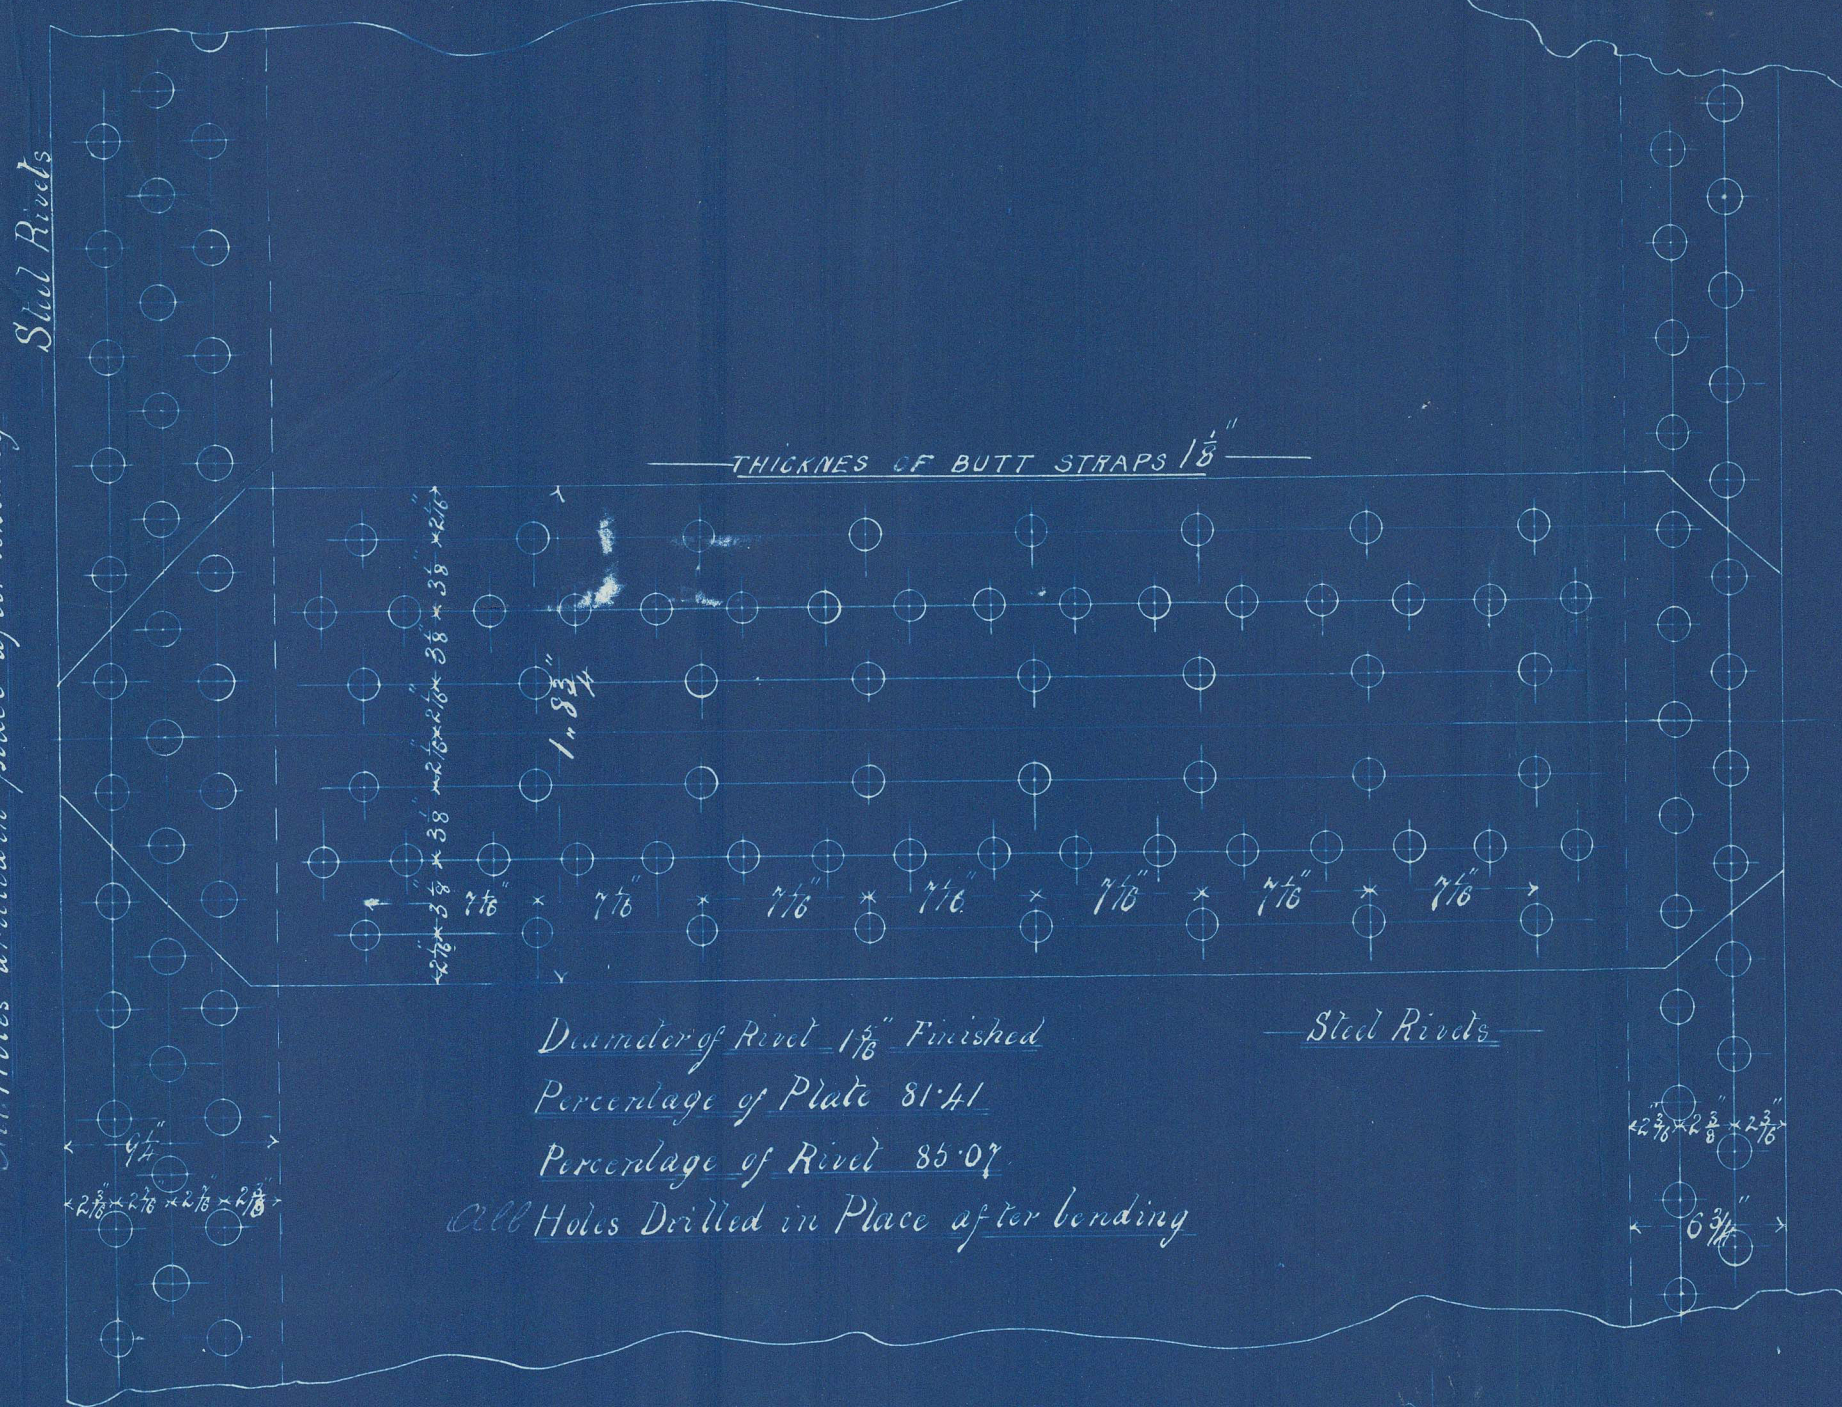

Steel Rivets

Diameter of Rivet 1 1/8" Finished

Percentage of Plate 81.3

Percentage of Rivet 83

Pitch 3.9"

128 Rivets in the circumference

All Holes drilled in place after bending



DOUBLE ENDED STEEL BOILER

No. 255-6


SCALE 3/4" = ONE FOOT
WORKING PRESSURE 160 LBS. PER. SQ. INCH.

LONDON & GLASGOW
ENGINEERING & SHIP BUILDING CO.
(LIMITED)
GLASGOW & COVAN

17' 3"
18' 5"



GLS209-0250

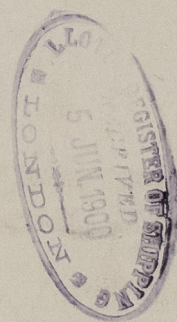

GLS209 - 0250



© 2021
Lloyd's Register
Foundation