

15.12.87
28.12.87

s.s. "Abertay"
No. 8695.

Steel Steamer No 258.


Scale 1" = 100 ft.
Class 100.57

12/12/87

Height
To castle 60.6
Bridge 50.0
L.L. 88.10
199.4

H.M.B. 16.46
D 15.85
H.M.G. 28.63
1st No. 60.94
2nd 13333.67

| | | |
|------------------|--------|--|
| H.M.B. | 25.02 | |
| H.M.G. | 15.40 | |
| D.T.B. | 15.00 | |
| Breadth | 32.92 | |
| Depth | 15.85 | |
| Length in Length | 18.80 | |
| Breadth | 6.64 | |

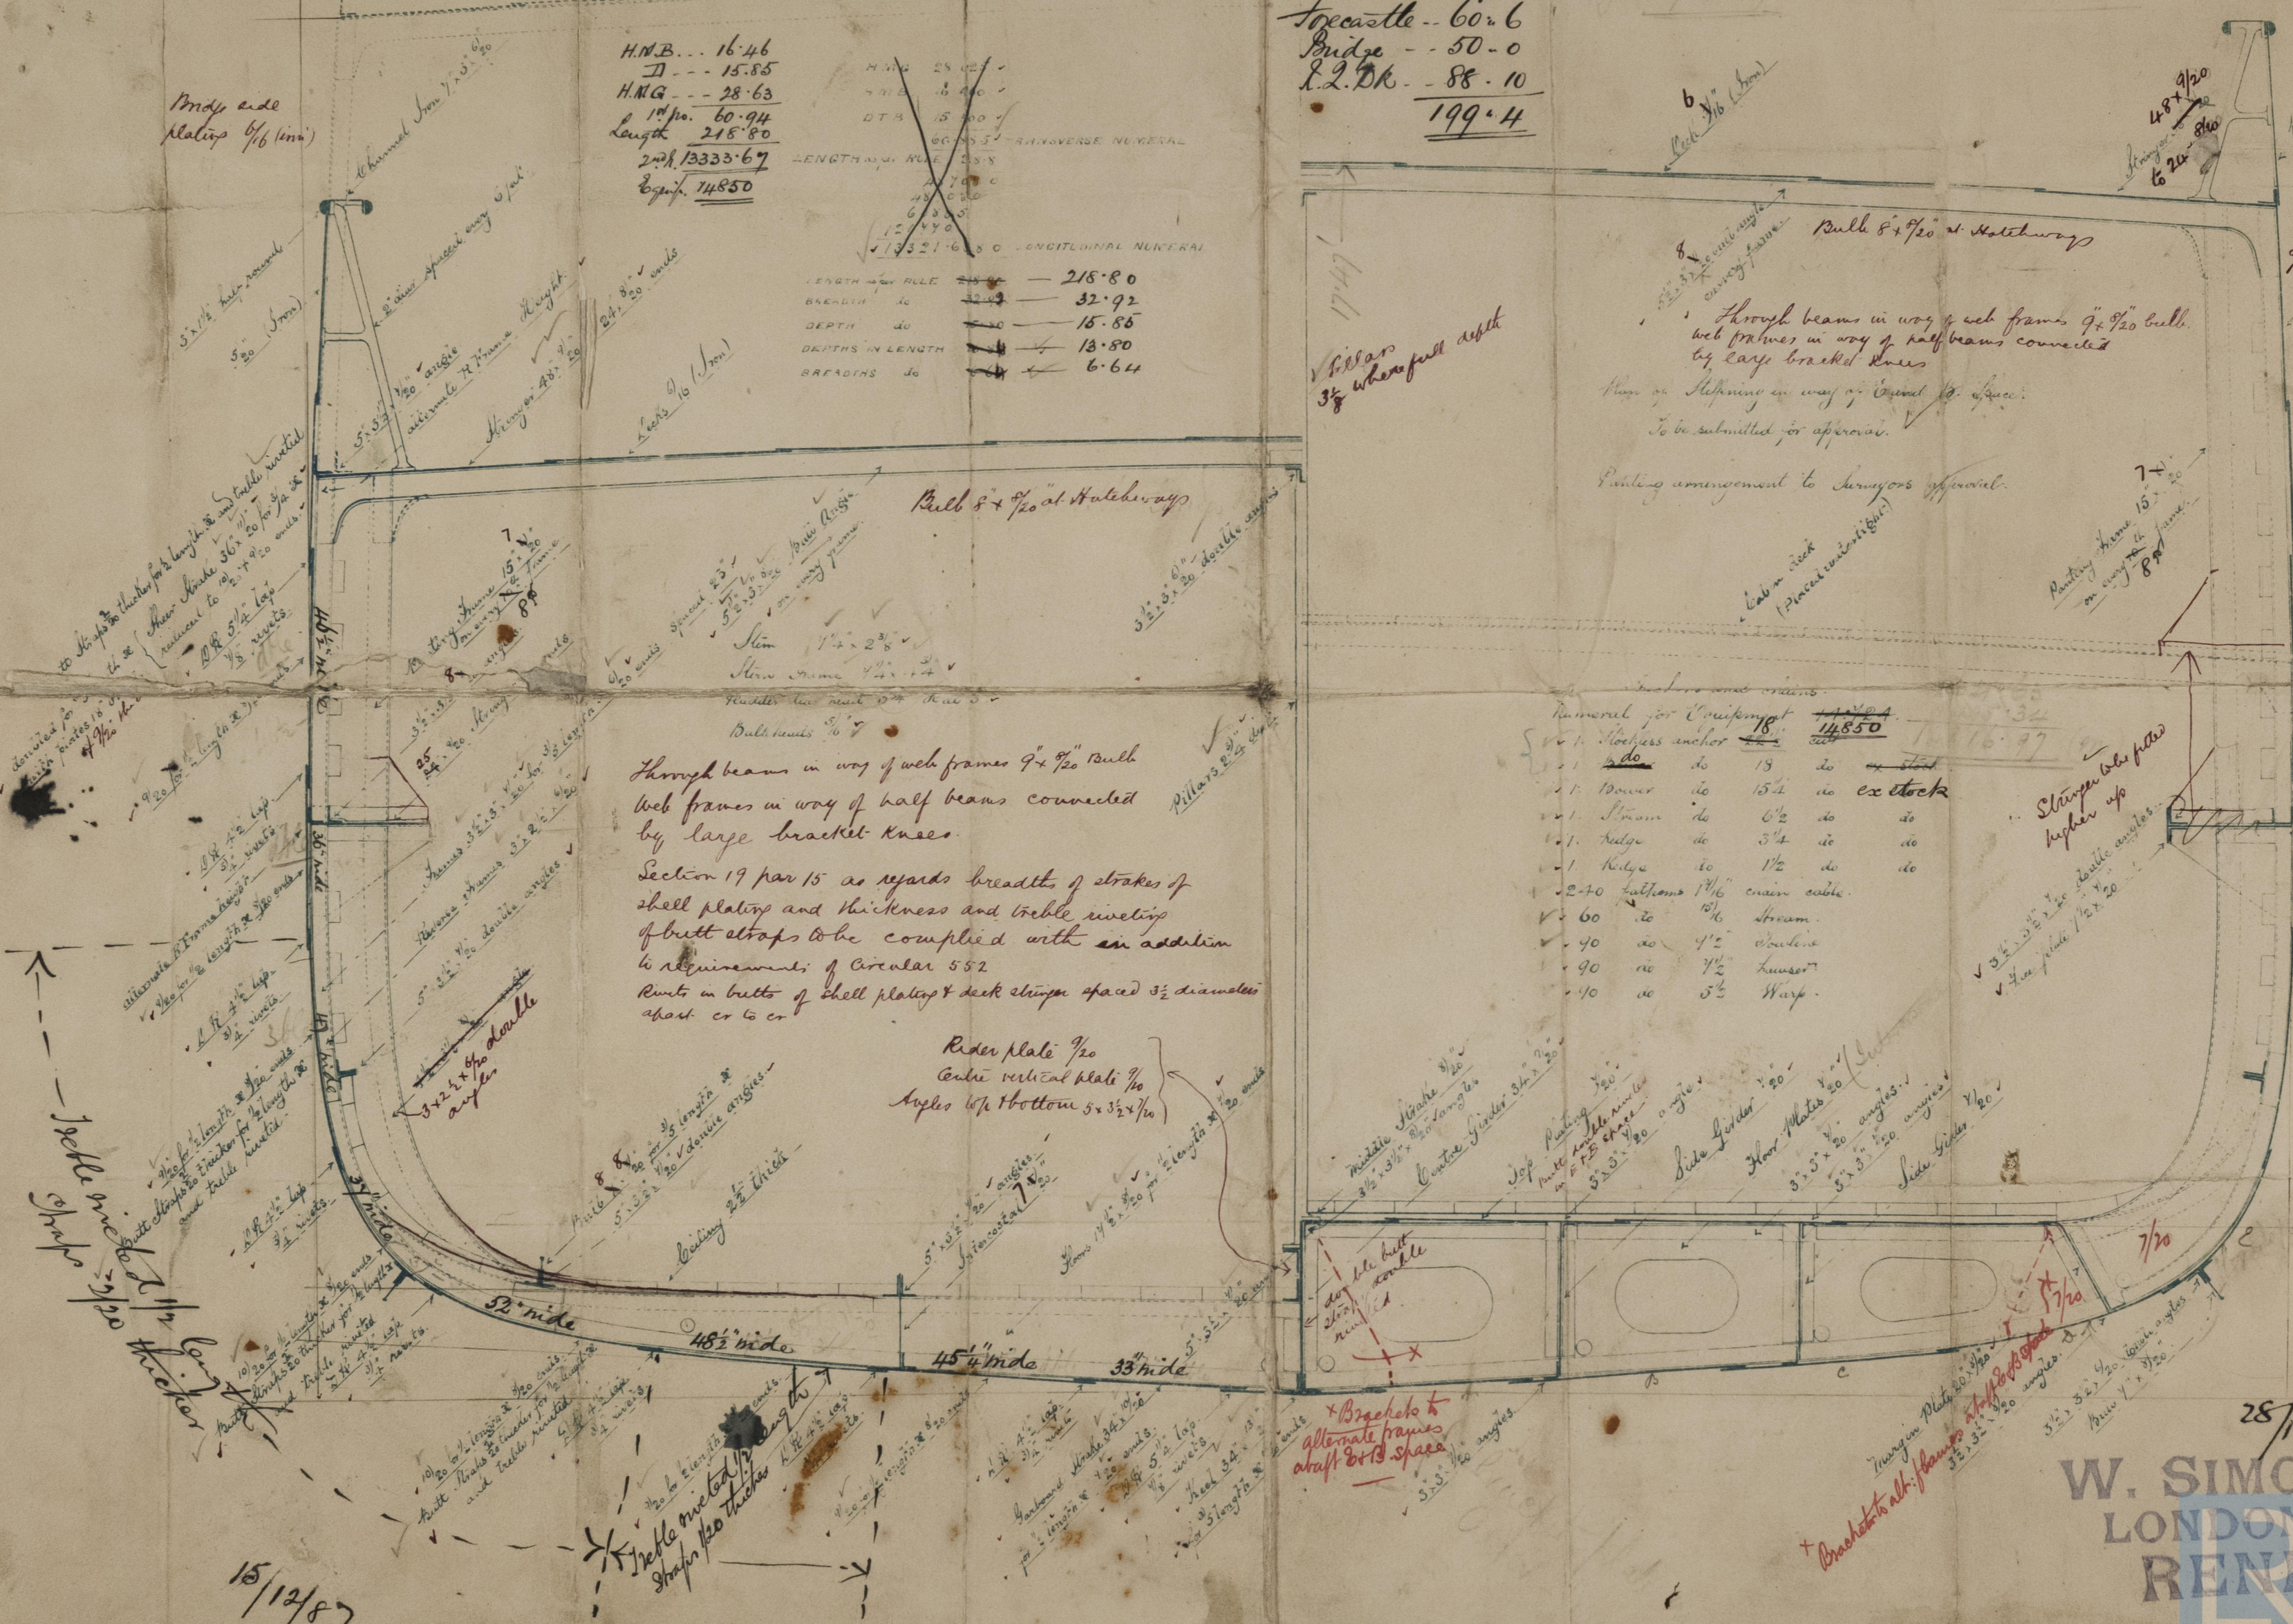

W. SIMONS & CO.
LONDON WORKS,
RENFREW.
Lloyd's Register
Foundation

G15210-0017



© 2021

Lloyd's Register
Foundation