


S.S. Nos 255 and 256

Scale $\frac{1}{8}$ " = 1 Foot.

S.S. "Saikio Maru" Glasgow Report No. 8590.
S.S. "Kobe Maru" Glasgow Report No. 8764.


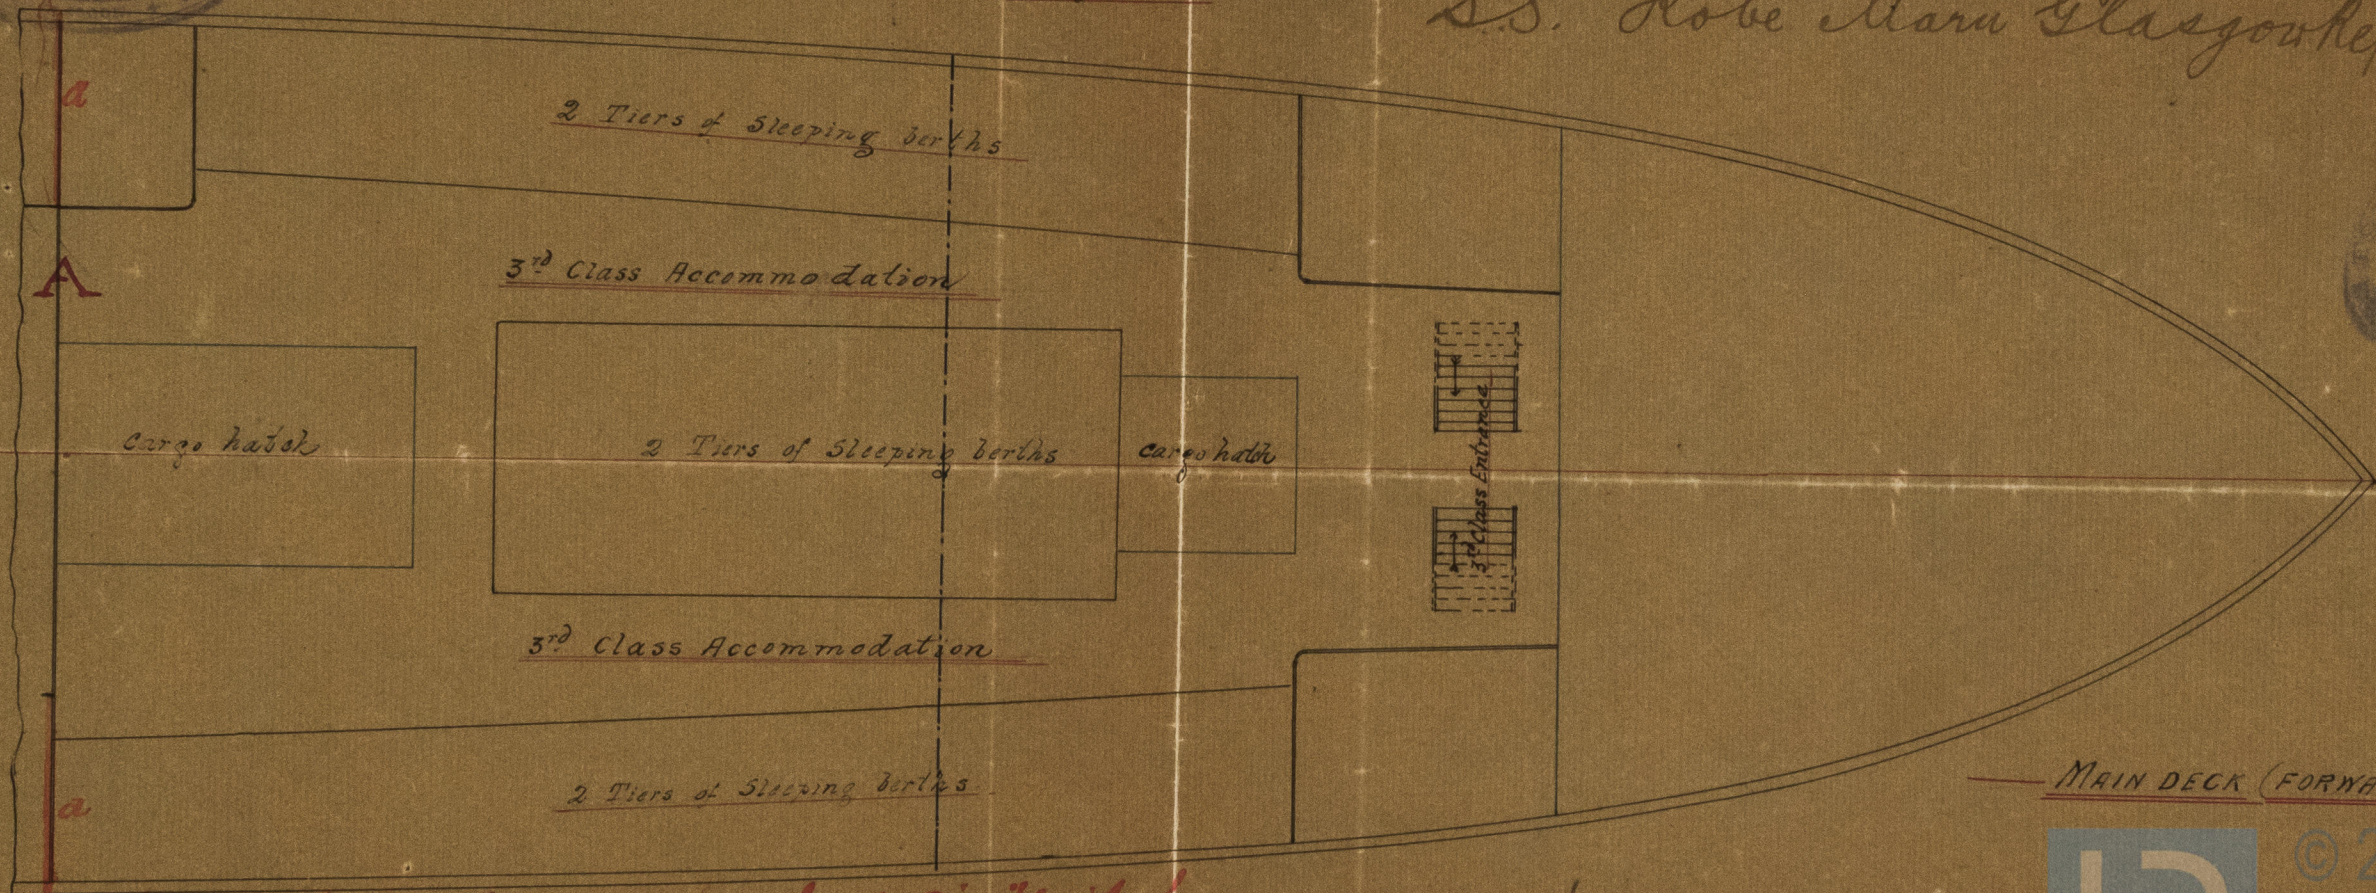



Can fit a Wing Bulkhead at a a for about 8' 9" wide from
vessel's side if so required. For the London & Glasgow C. & S. S. Co. Ltd.
L. M. & Co. 17/8/87



© 2021

Lloyd's Register
Foundation

GLS210-0229

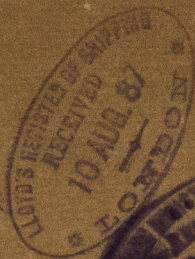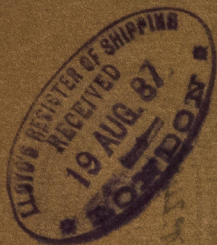

GLS210-0229

24/9/87




© 2021
Lloyd's Register
Foundation