


Ln 5/4/01

S. S. "Saikio Maru" Glasgow Report No. 8590.-  
S. S. "Kobe Maru" Glasgow Report No. 8764.-

PUMPING & DRAINING

S. S. No. 255-56

Scale 1/4" = 1 Foot

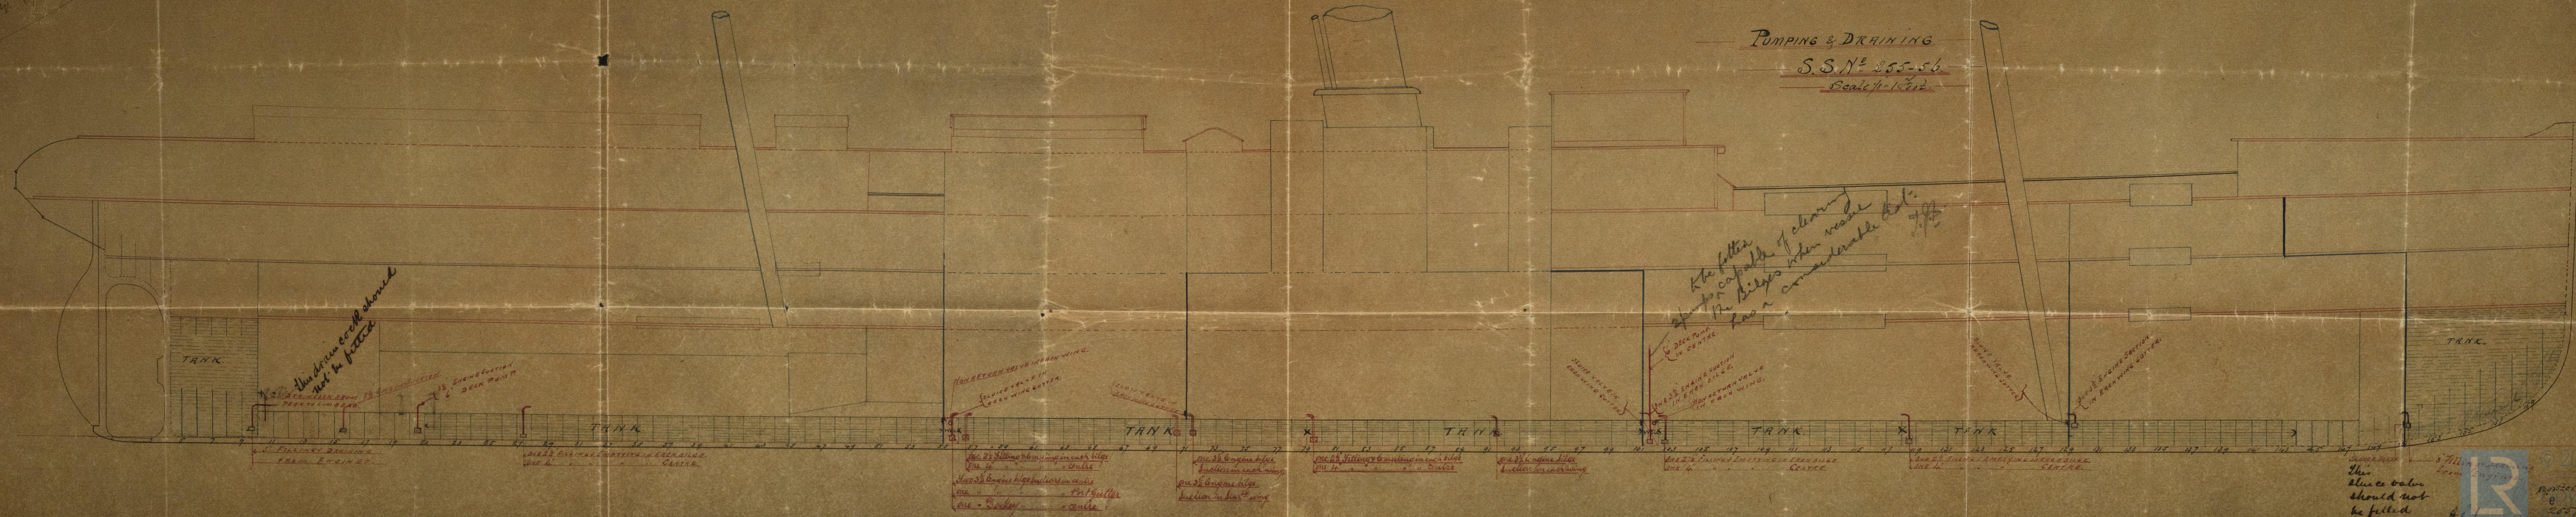

The filter  
is capable of clearing  
the bilges when needed  
has a considerable dist.

The drum could should  
not be fitted


Since this  
sluice valve  
should not  
be filled

5 Filling from  
Engine Room  
No. 2, 11, 17

© 2021  
R  
Register  
Foundation

GLS210-0233



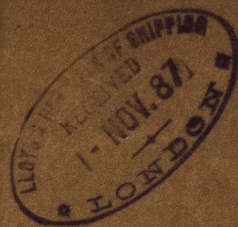

GLS2100233



© 2021

Lloyd's Register  
Foundation