


4.8.87
1.9.89
17.9.87

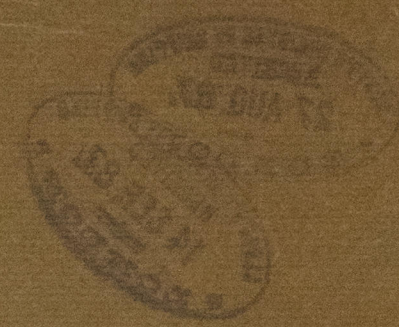

S.S. "Saikio Maru" Glasgow Report No. 8590.
S.S. "Kobe Maru" Glasgow Report No. 8564.


LONGITUDINAL SECTION

OF

S.S. Nos 255-256

All as for Section submitted

SCALE 1/8 INCH

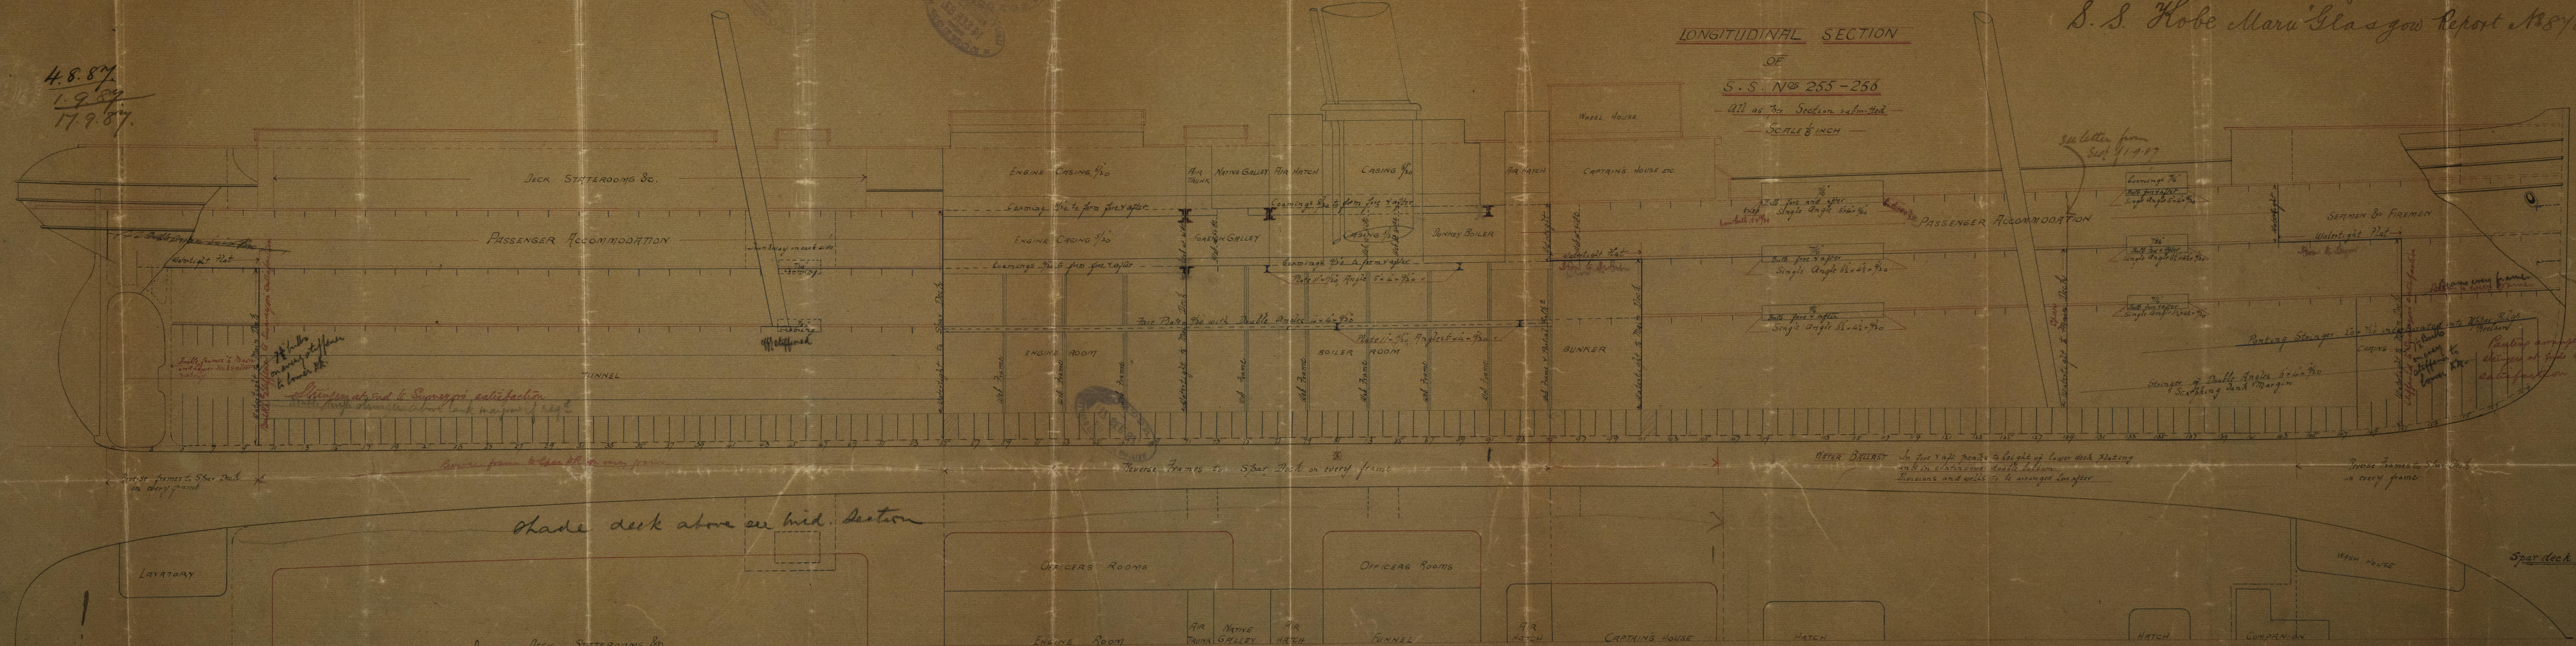

shade deck above see mid section

Deck beams as per midship section
Variations and deductions at ends as per (sect 13)

JAB
3/8/87

GLS210-0234



Lloyd's Register
Foundation

LLOYD'S REGISTER OF SHIPPING
RECEIVED
27 AUG. 87
LONDON
LLOYD'S REGISTER OF SHIPPING
RECEIVED
14 SEP. 87
LONDON

LLOYD'S REGISTER OF SHIPPING
RECEIVED
10 AUG. 87
LONDON

LLOYD'S REGISTER OF SHIPPING
RECEIVED
17 SEP. 87
LONDON

GLS210-0234



© 2021
Lloyd's Register
Foundation