

14.9.87.


PLAN OF DECK PLATING IN WAY OF ENGINE AND BOILER OPENINGS
OF
S.S. Nos 255 AND 256
SCALE 1/4 INCH

S.S. "Saikio Maru" Glasgow Report No. 8590.
S.S. "Kobe Maru" Glasgow Report No. 8464


Spar Deck Plan.



Main Deck Plan.

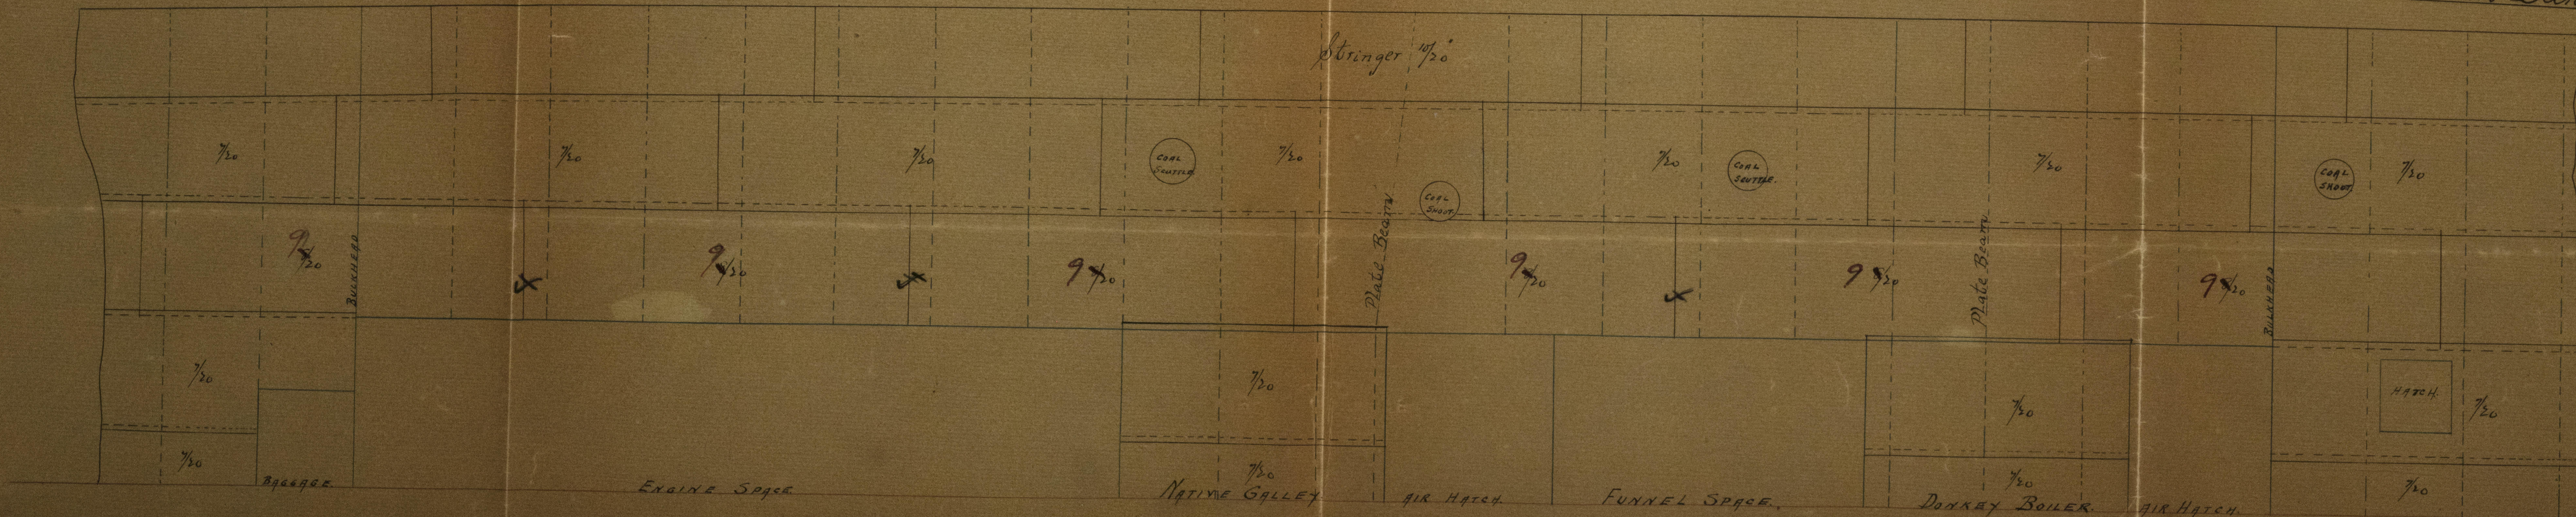

14/9/87

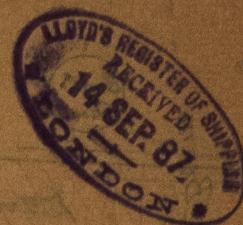

GLS210-0235




© 2021
Lloyd's Register
Foundation