


Conquistador
Gls 8804

See br. to
Gls 27.3 88.

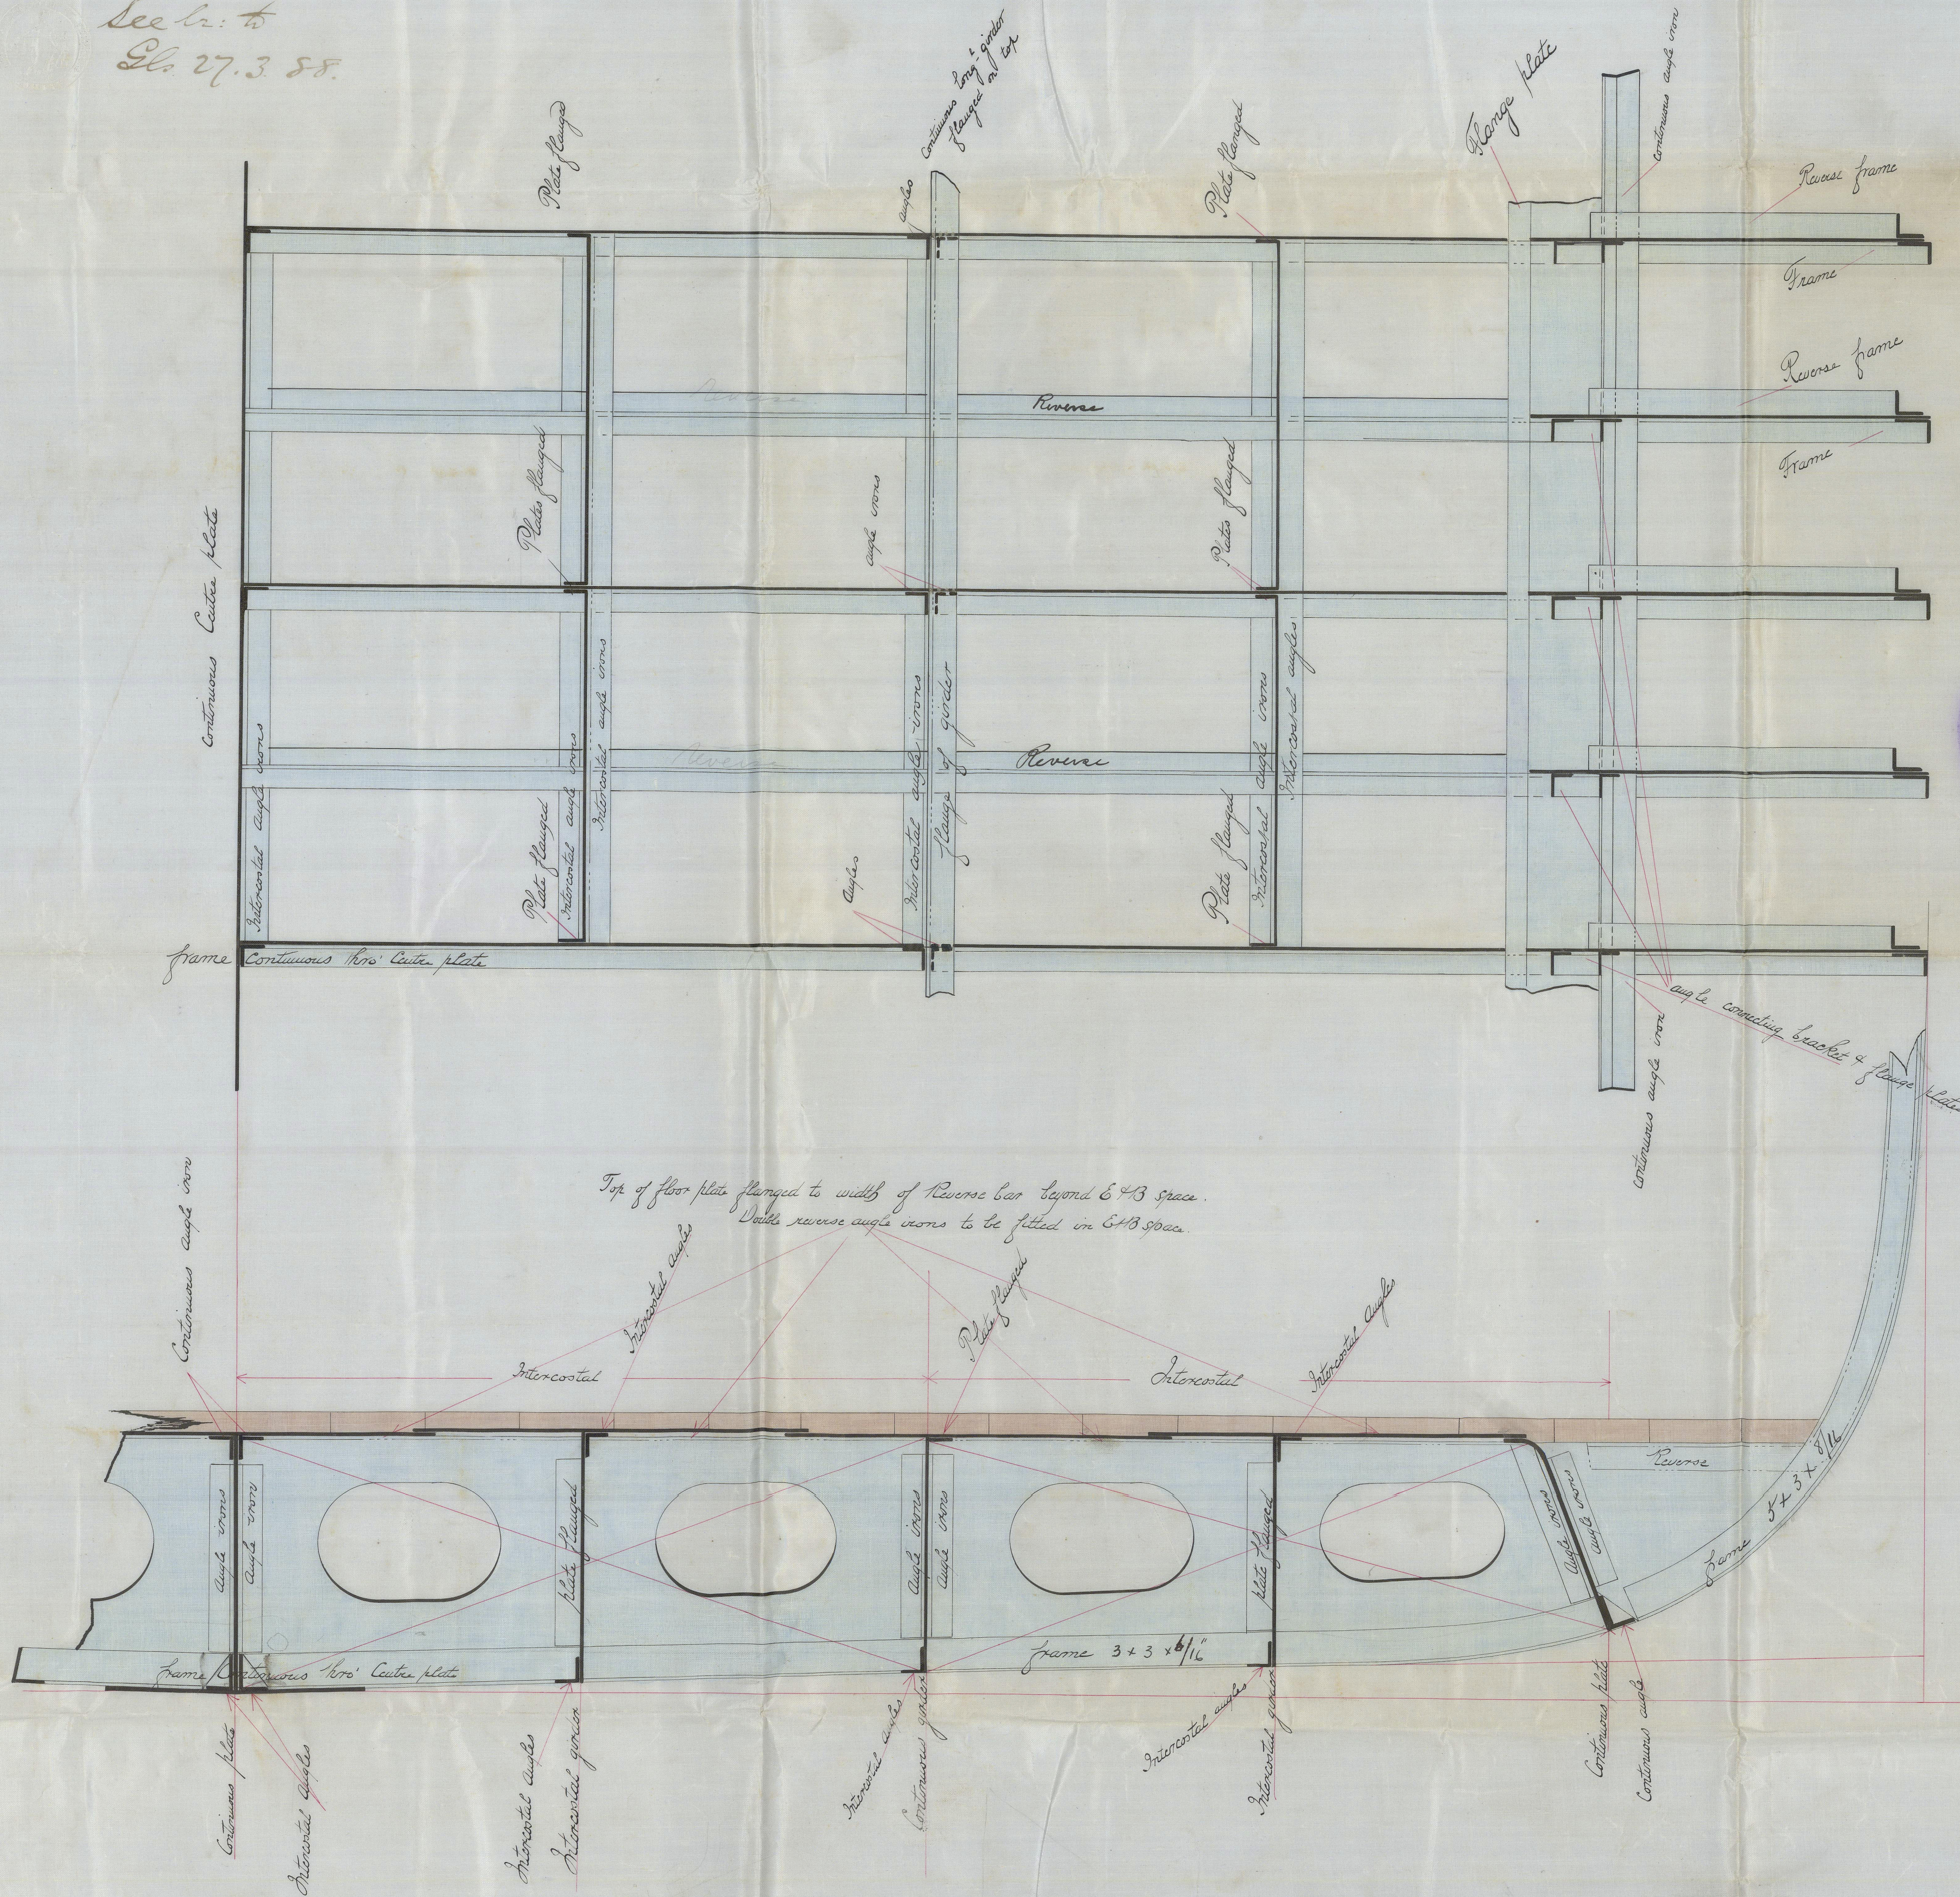

Vessel built of iron - hence plating has not been carried out
S. Heale



PLAN, TRANSVERSE SECTION AND LONGITUDINAL SECTION AT CENTRE PLATE

OF


DOUBLE BOTTOM OF S.S. No 286

SCALE 1 INCH = ONE FOOT

This plan only shows proposed
arrangement - not exact sizes

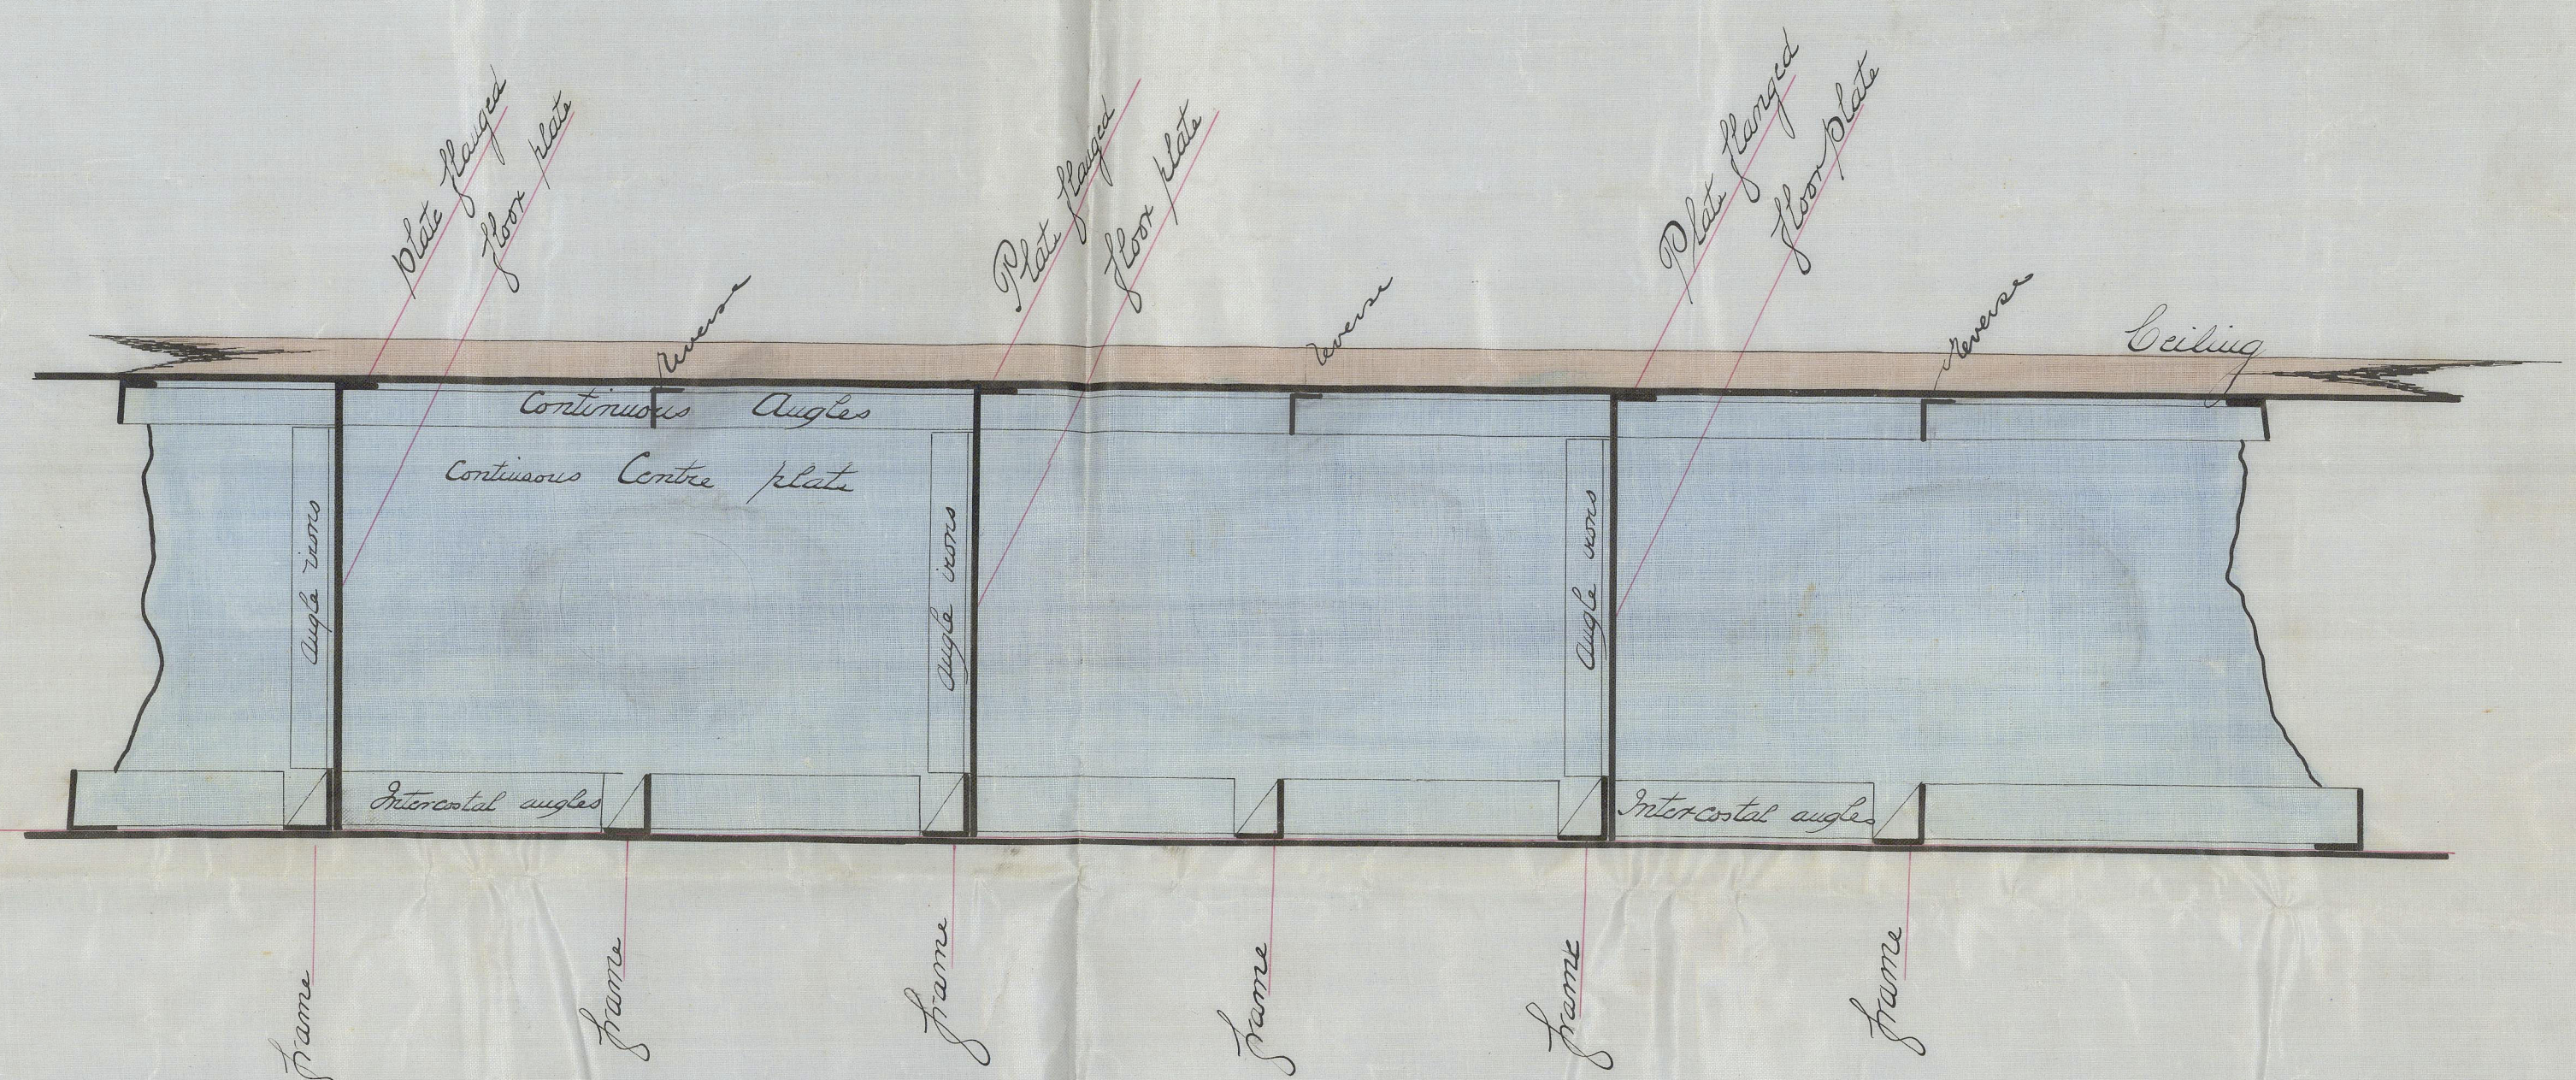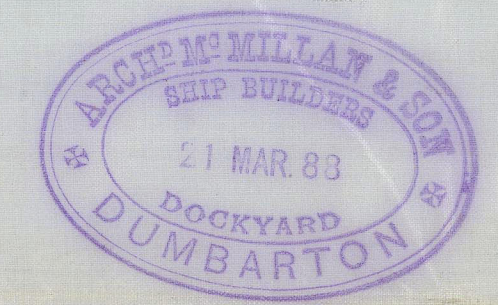



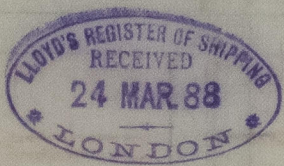

675211-0028



© 2021

Lloyd's Register Foundation