

Lh 4/6/0

S. S. "Veloxy"
Glasgow Report No 8848



BOILERS NOS 400-401

PRESSURE 25 LBS PER SQUARE INCH

SCALE 1/2" = 1 FOOT

1 RIGHT - 1 LEFT


TO PASS LLOYD'S SURVEY

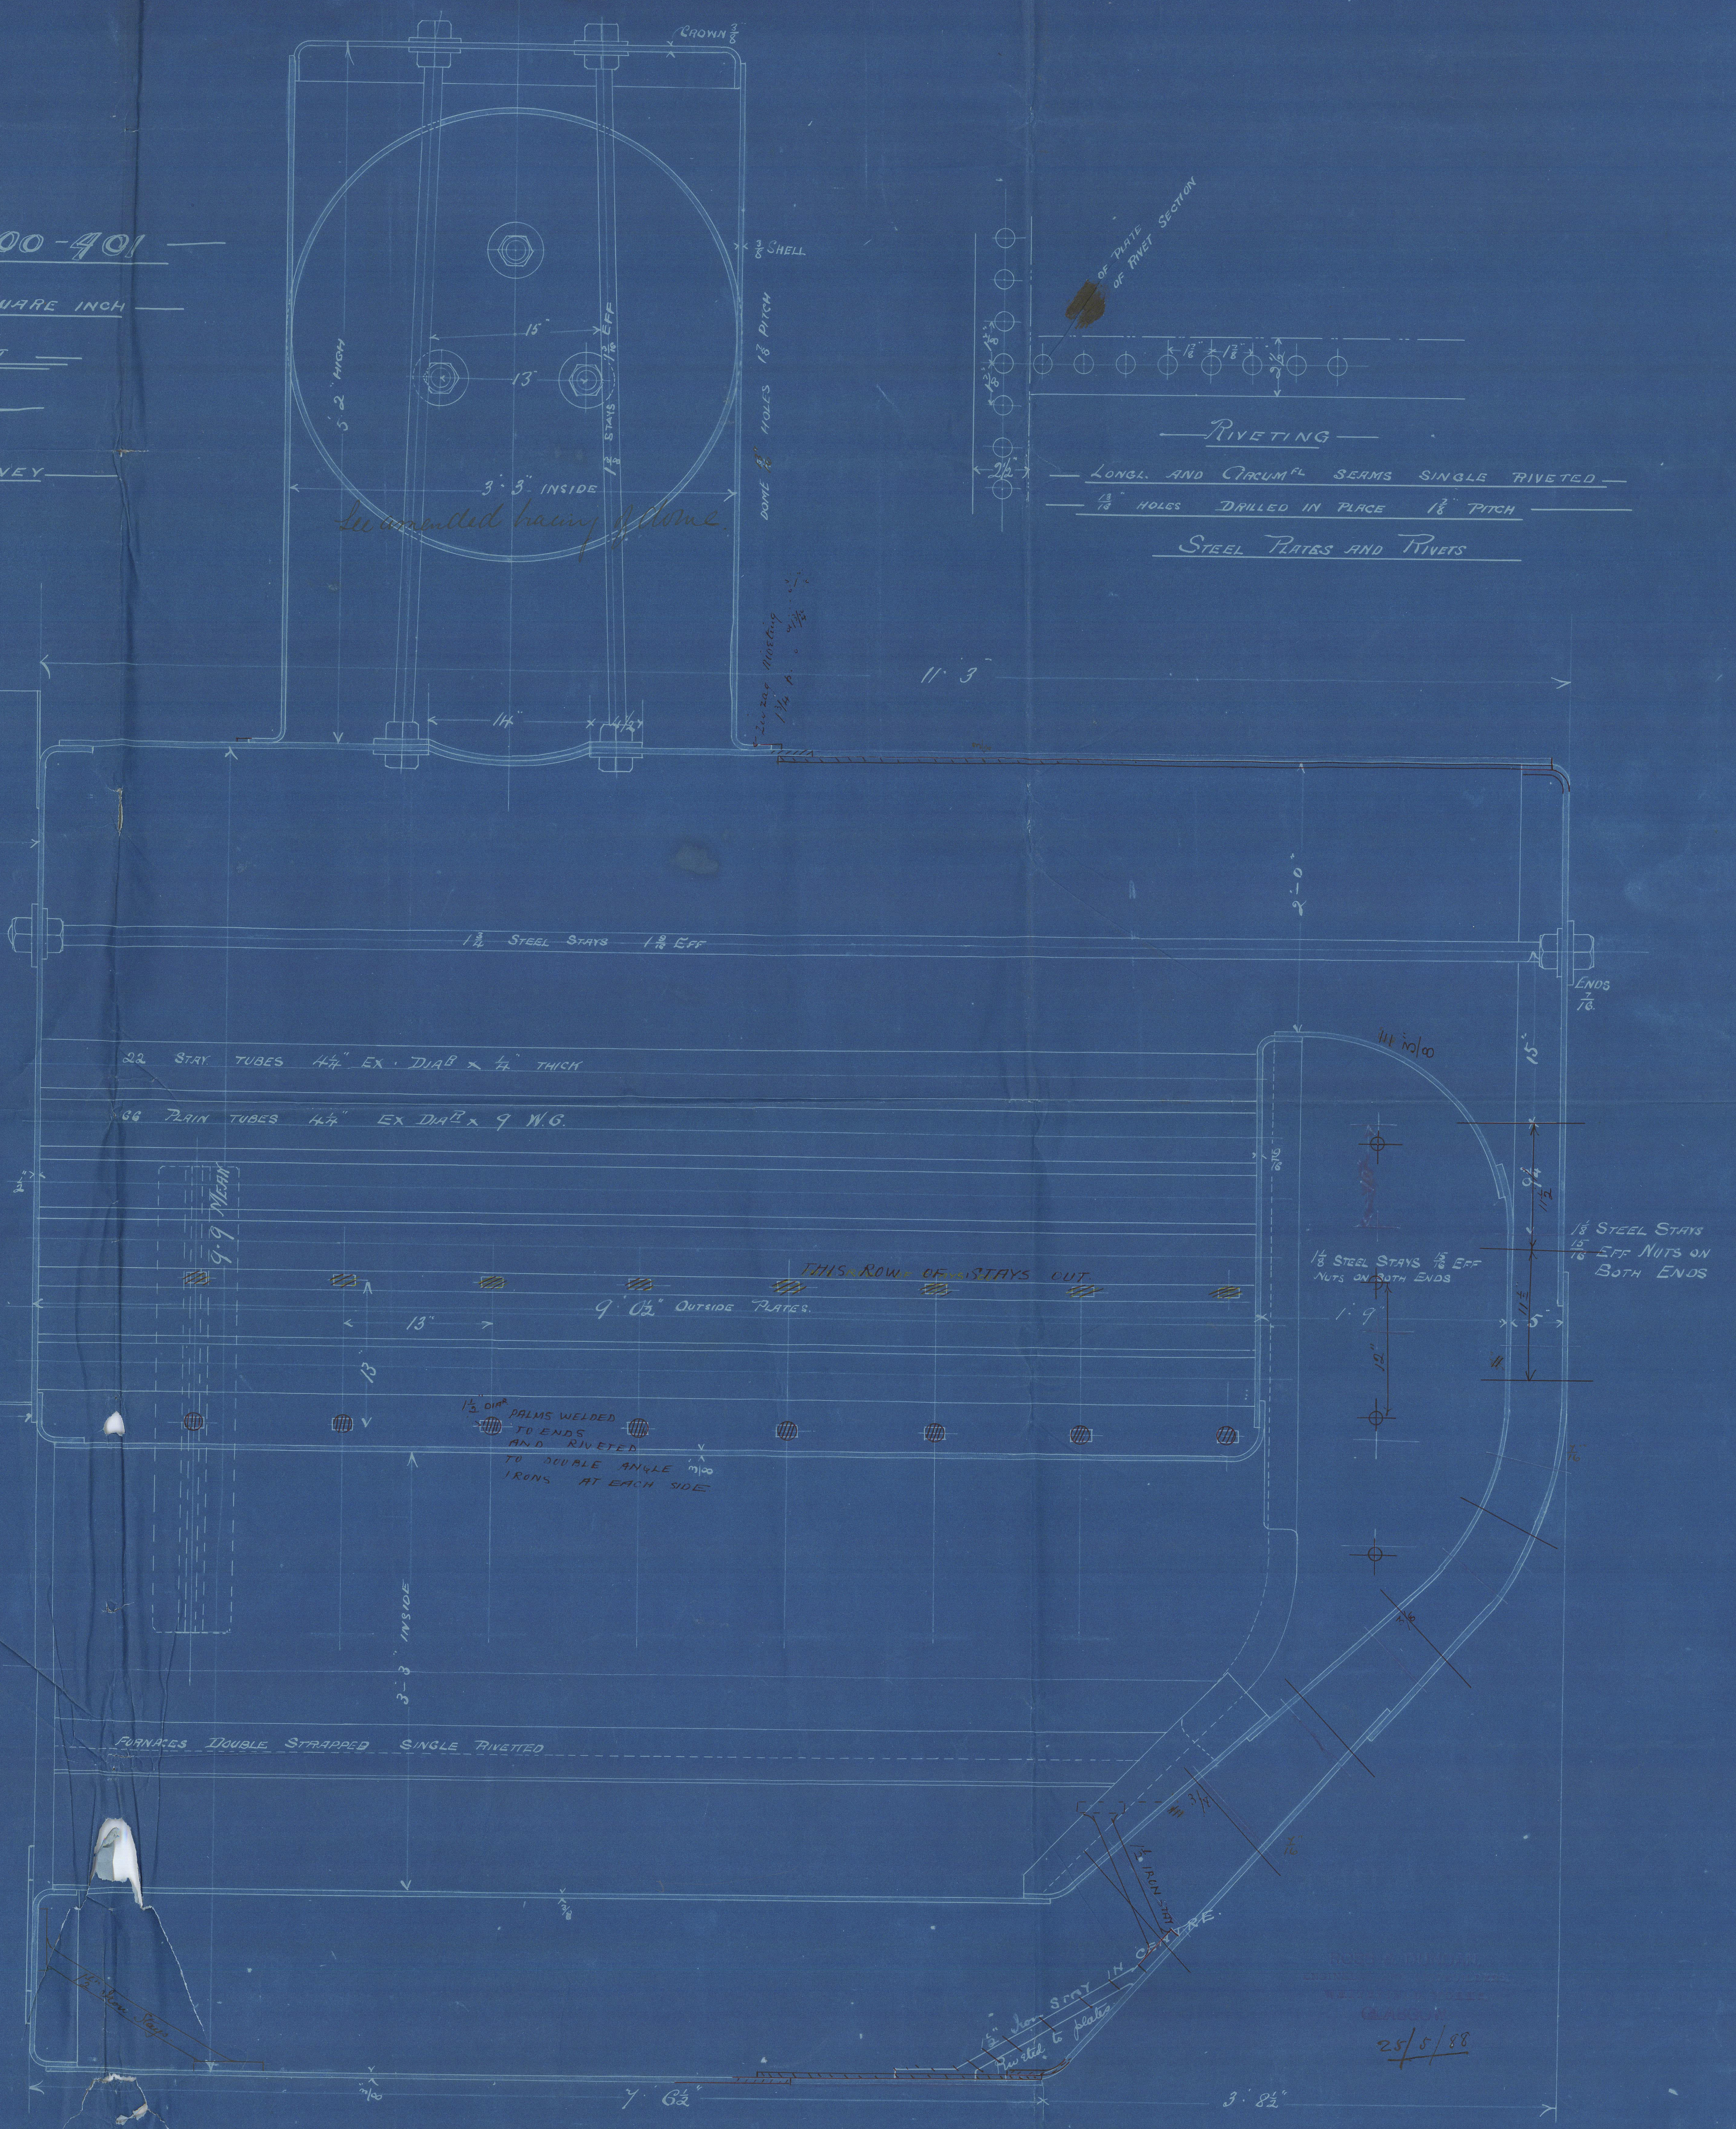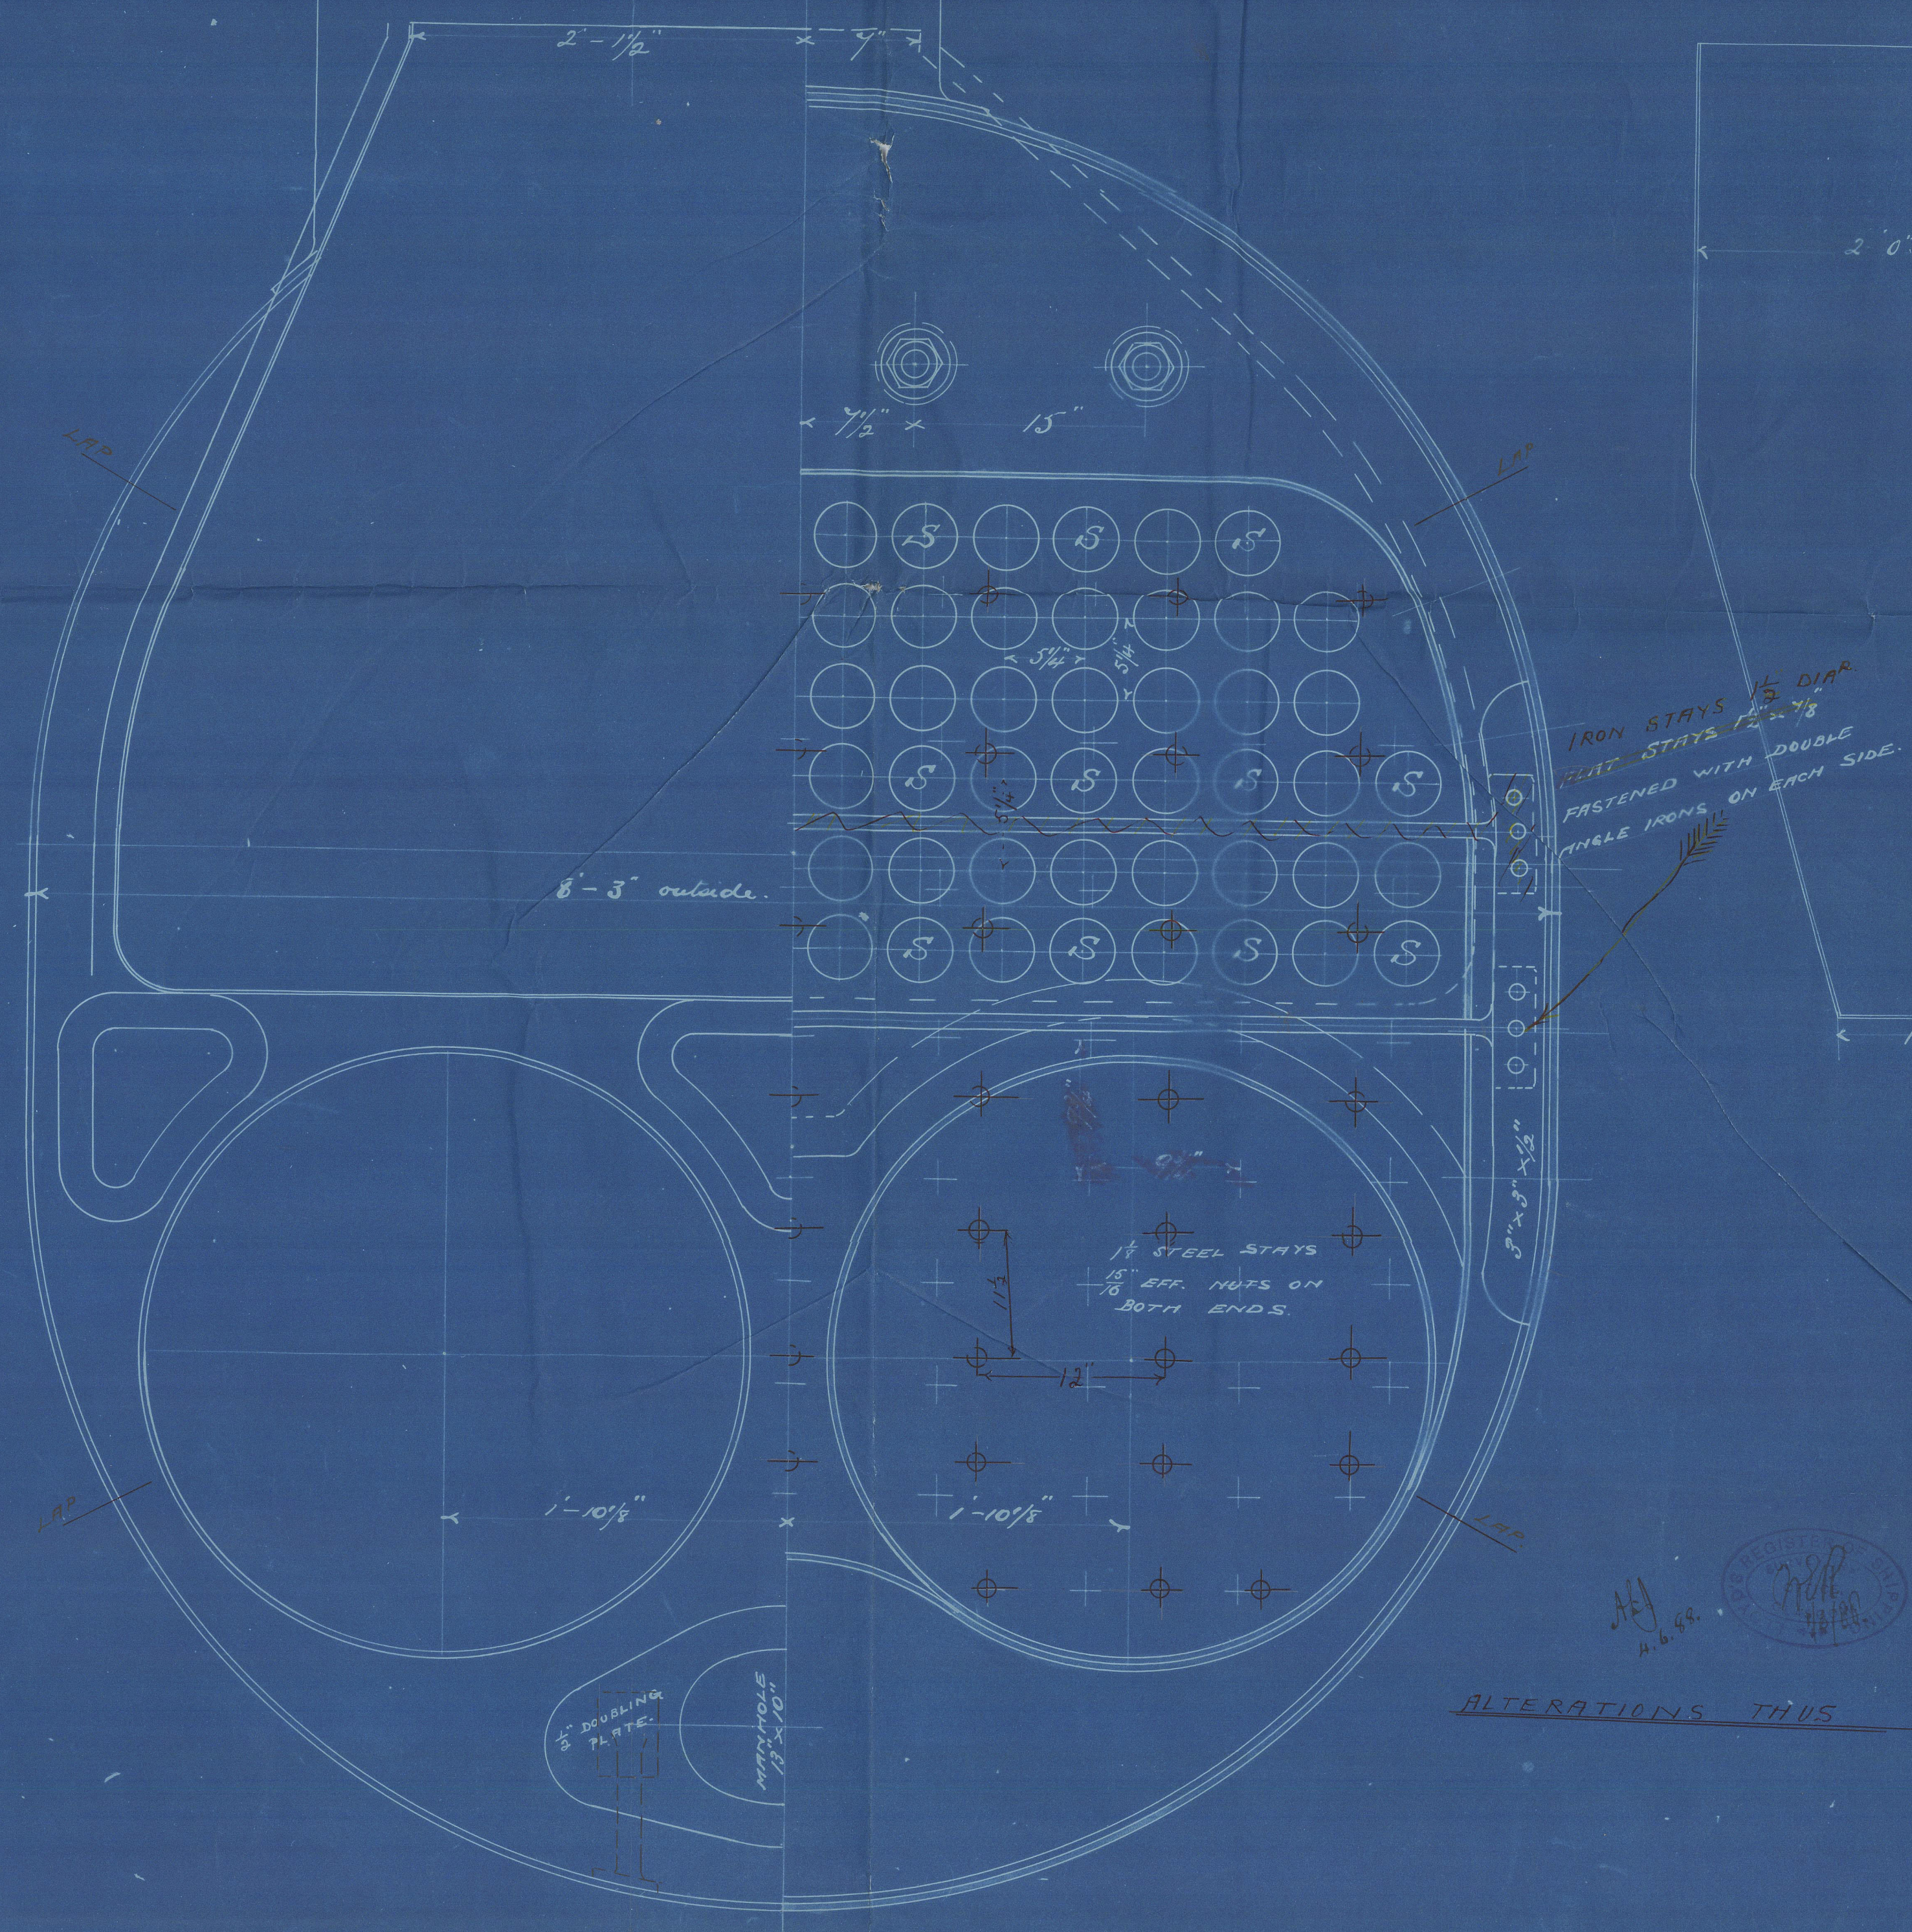

RYETING
LONG. AND CIRCUM. SEAMS SINGLE RIVETED
1/8" HOLES DRILLED IN PLACE 1 1/2" PITCH
STEEL PLATES AND RIVETS

ALTERATIONS THIS


25/5/88

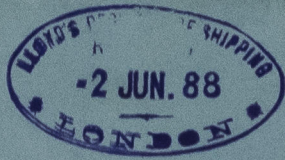

© 2021

Lloyd's Register
Foundation

LLOYDS.

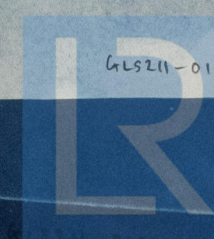

GLS211-0104

© 2021

Lloyd's Register
Foundation