



No 55. "Fort Williams" I.S. Bel. report No 3471.
No 56 "Hicklands" I.S. Bel. report No 3484.

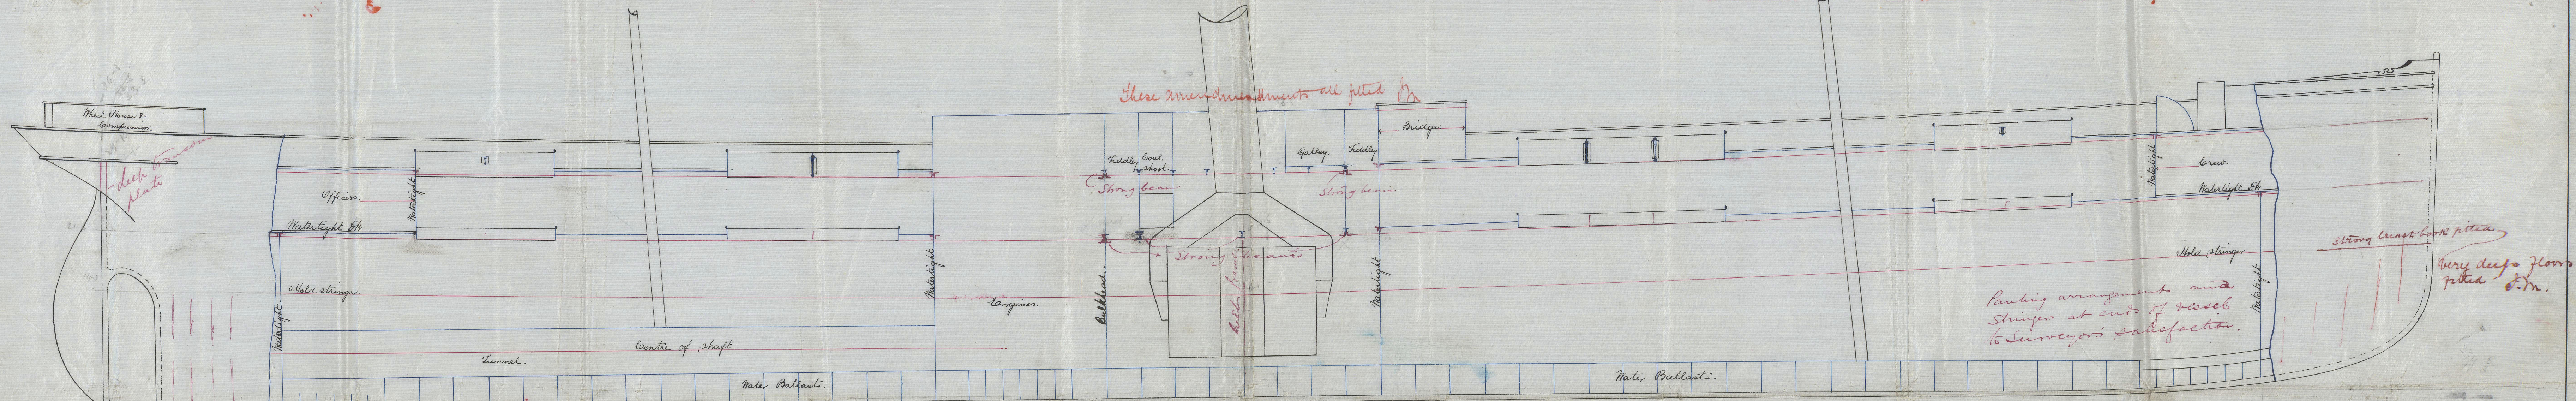

— Spar Deck. —

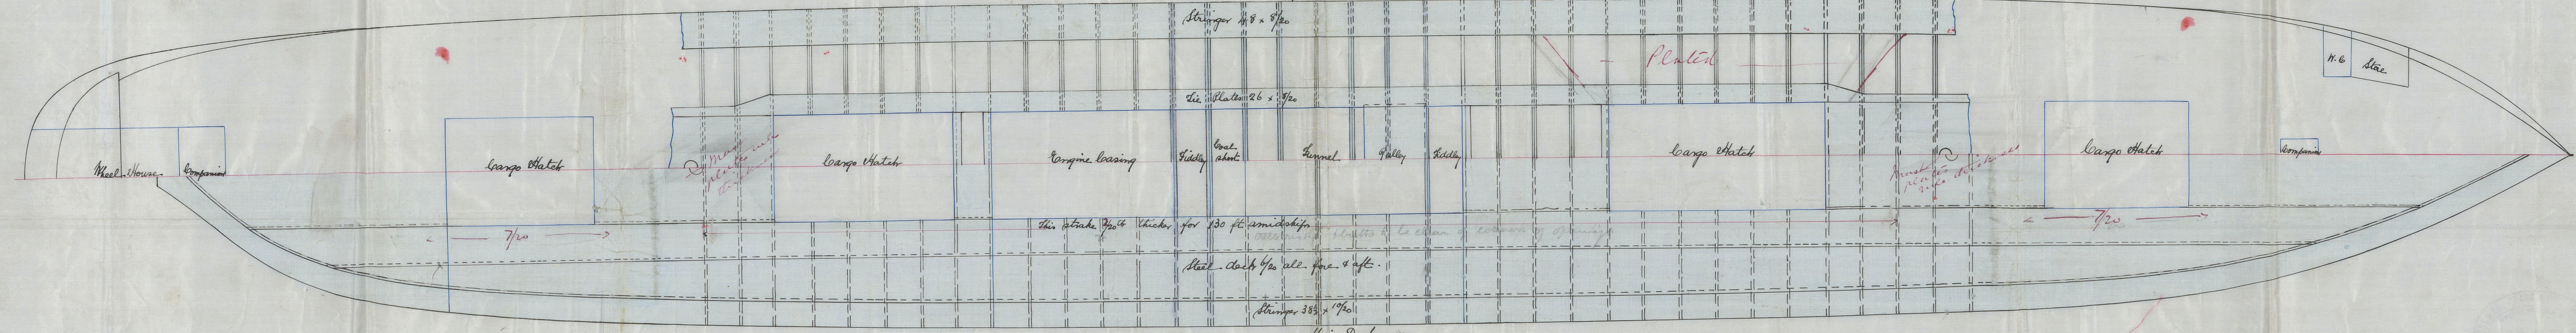

— Main Dec

J. H. L.
1871/88

22/1/85