

Middship Section N^o 55 & 56. S.S.

N^o 55. Fort William. Rel. Rep. 3471
N^o 56. "Kirkland". Rel. Rep. 3484

19.1.88
22.6.88.


Dimensions 27' x 37' x 26' 2" Mid to Spar Dk

To class 100 A. 1. Spar Dk (Steel)

Scale 1/2 inch = one foot

Numerals 1/2 Breadth	18.5	Proportions Breadth 7.2
1/2 Girth	34.75	Depth 13.5
Depth	19.93	

$$73.17 \times 269.5 = 19,719.3 \text{ Plating N}^o$$

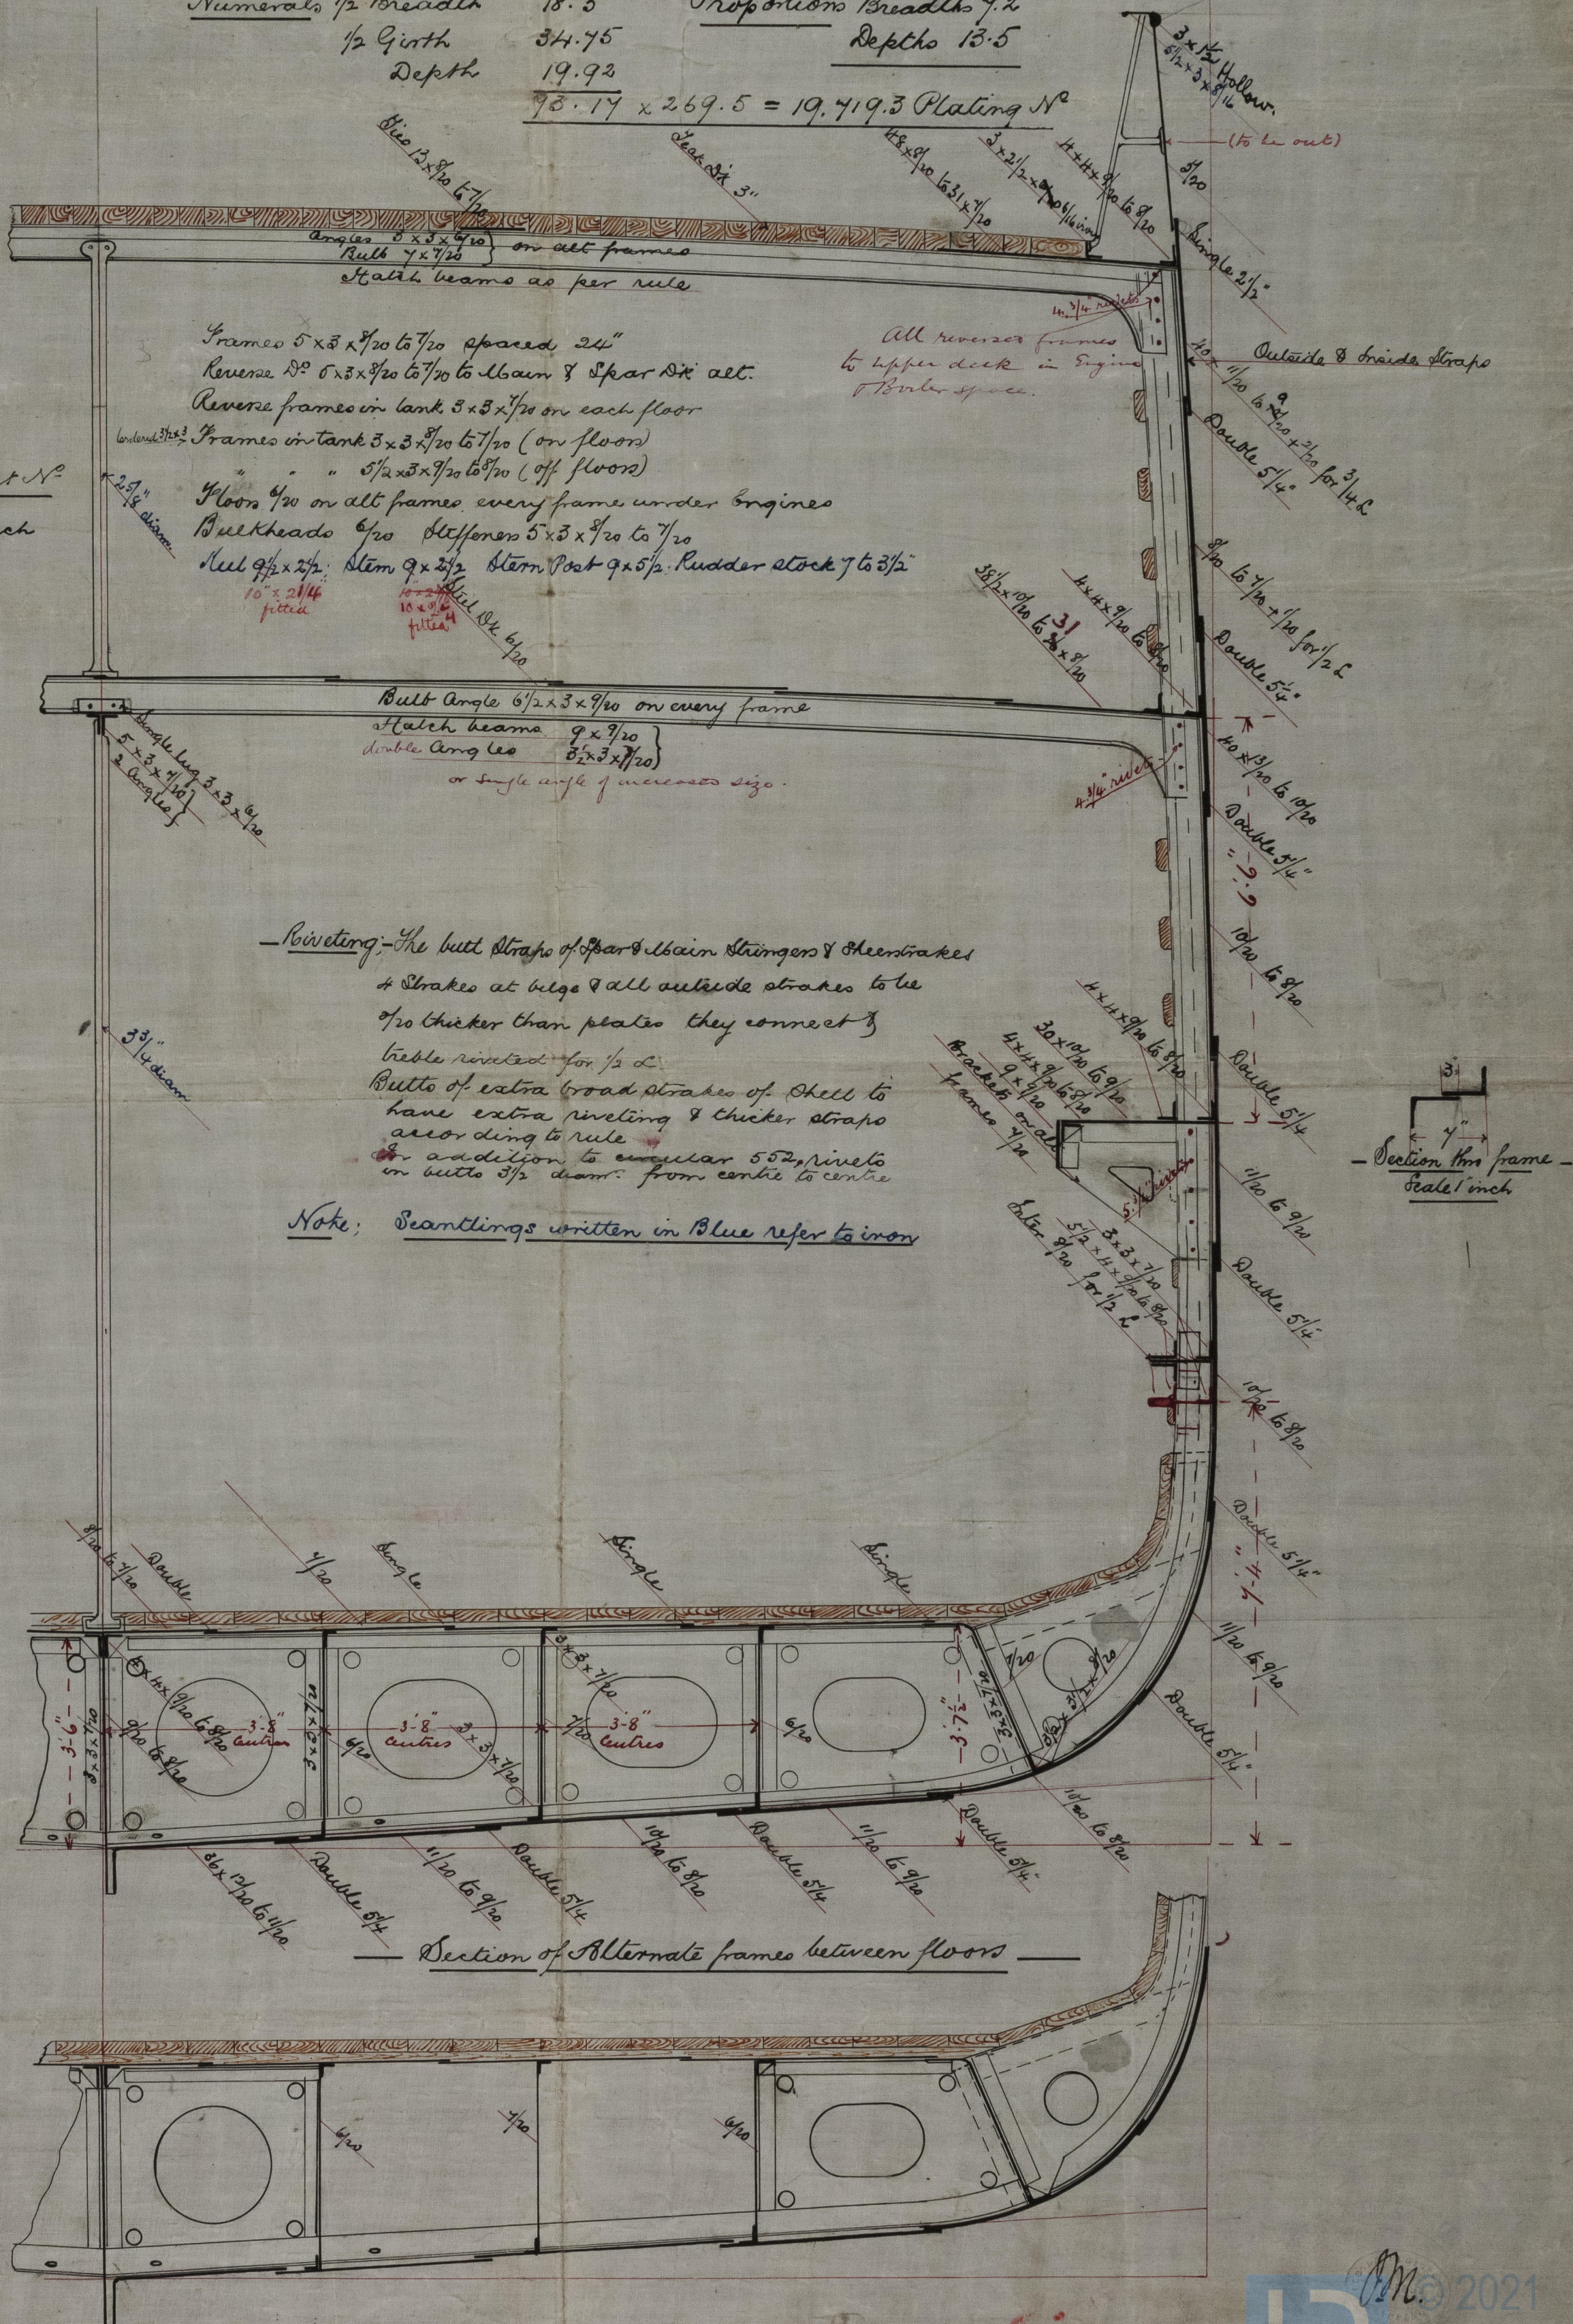

Equipment

$$87.17 \times 269.5 = 23,492.3 \text{ Equipment N}^o$$

2 Bauer Anchors on stock 30 cwt each

1 " " " 25 1/2 "

1 Stream " " 9 1/2 "

1 Kedge " " 4 3/4 "

1 " " " 2 1/2 "

270 Fathom 1 1/4 " Stud Chain cable

45 " 1 1/6 " Stream "

90 " 11 " Towline "

90 " 9 " Hawser "

90 " 7 1/2 " Warp "

Riveting - The butt straps of spar & chain stingers & sheetrakes

& strakes at bulge & all outside strakes to be

3/4" thicker than plates they connect &

treble riveted for 1/2 L.

Butts of extra broad strakes of shell to

have extra riveting & thicker straps

according to rule

In addition to regular 552 rivets in butts 3/4" diam. from centre to centre

Note: Scantlings written in Blue refer to iron

Section of Alternate frames between floors

Section thru frame -
Scale 1 inch



187/188

L7110-112514



to be paid

to be paid

© 2021 Lloyd's Register Foundation

15.1.82

25.6.82

to be paid

to be paid

