

Lloyd's Register of British and Foreign Shipping.

Glasgow

(Report on Vessel No. *8866* Port *Glasgow*)

S.S. "Dunmore."

No. *784A*

SHIP FORGINGS OR CASTINGS.

I have to report that the undermentioned Iron or Steel Forgings or Castings, manufactured by

James K S Bagnall Sons of *Wylton*

for the Vessel No. *114*, being built by *James & Wm Knight Co.*


of *Ayr* have been inspected by me as set forth below, and found to be, so far as can be seen, *sound.*

Wm J Cameron
Sunderland

Lloyd's
No. *784A*
86.C.

	STERN FRAME.	RUDDER FRAME.	STEM.
Material* - - - -	<i>Scrap iron</i>	<i>Scrap iron</i>	<i>Scrap iron</i>
made - - - -	<i>Fayed</i>	<i>Fayed</i>	<i>Fayed</i>
Dimensions - - - -	<i>8' x 5'</i>	<i>5 3/4'</i>	<i>8" x 2 1/2"</i>
Process on Inspection -	<i>Fayed Limited</i>	<i>Fayed Limited</i>	<i>Fayed</i>
When Inspected	<i>July 21-26-27 Feb 6-8-16-24 March 2/88</i>	<i>May 5-12-18 June 5-14-29 July 16-20-24/88</i>	<i>July 27 Feb 6/88</i>

ETCHES OF FRAMES SHEWING POSITION AND DESCRIPTION OF WELDS OF FORGINGS, OR PARTICULARS OF TESTS APPLIED TO CASTINGS.

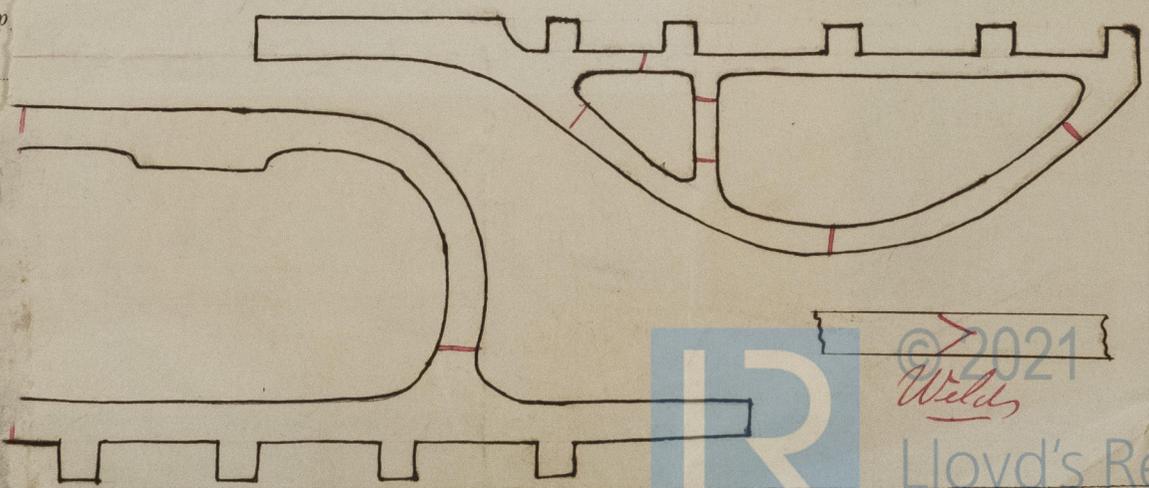

* If of Iron, state whether scrap or puddled iron.