


No. 335. S.

Sketch showing strengthenings in way of Engine & Boiler space.

Scale $\frac{1}{4}'' = 1 \text{ foot}$


24.8.88.

~~Iteration~~

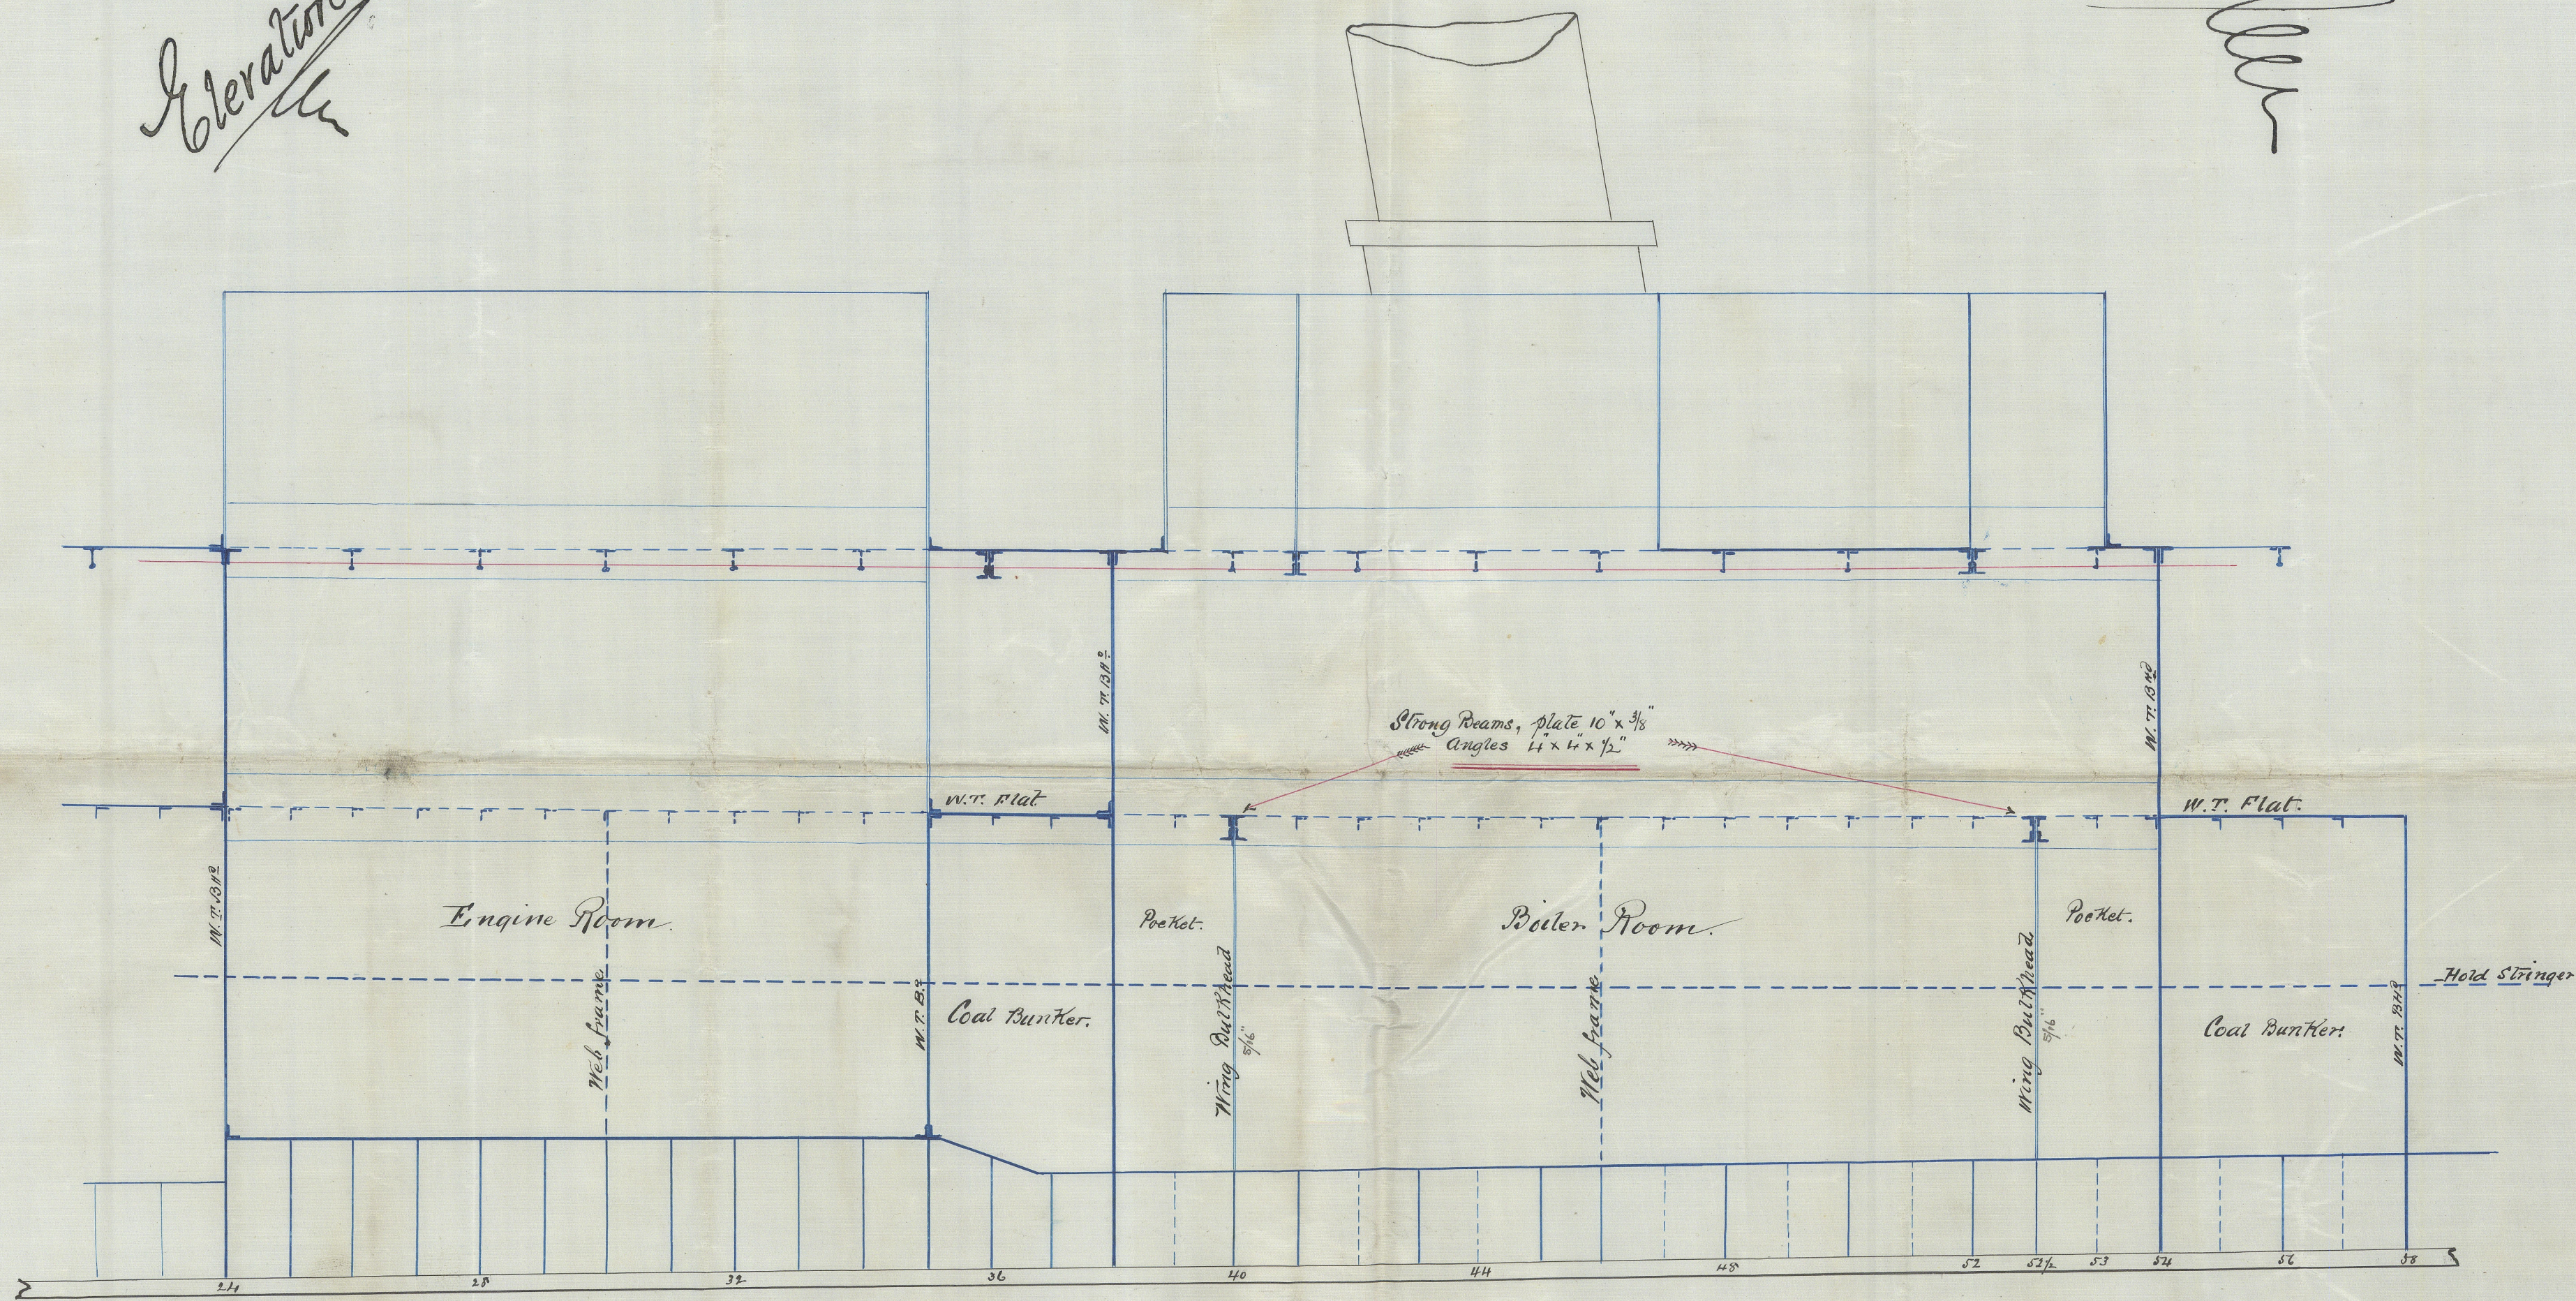




Grain Dectr.

Pran

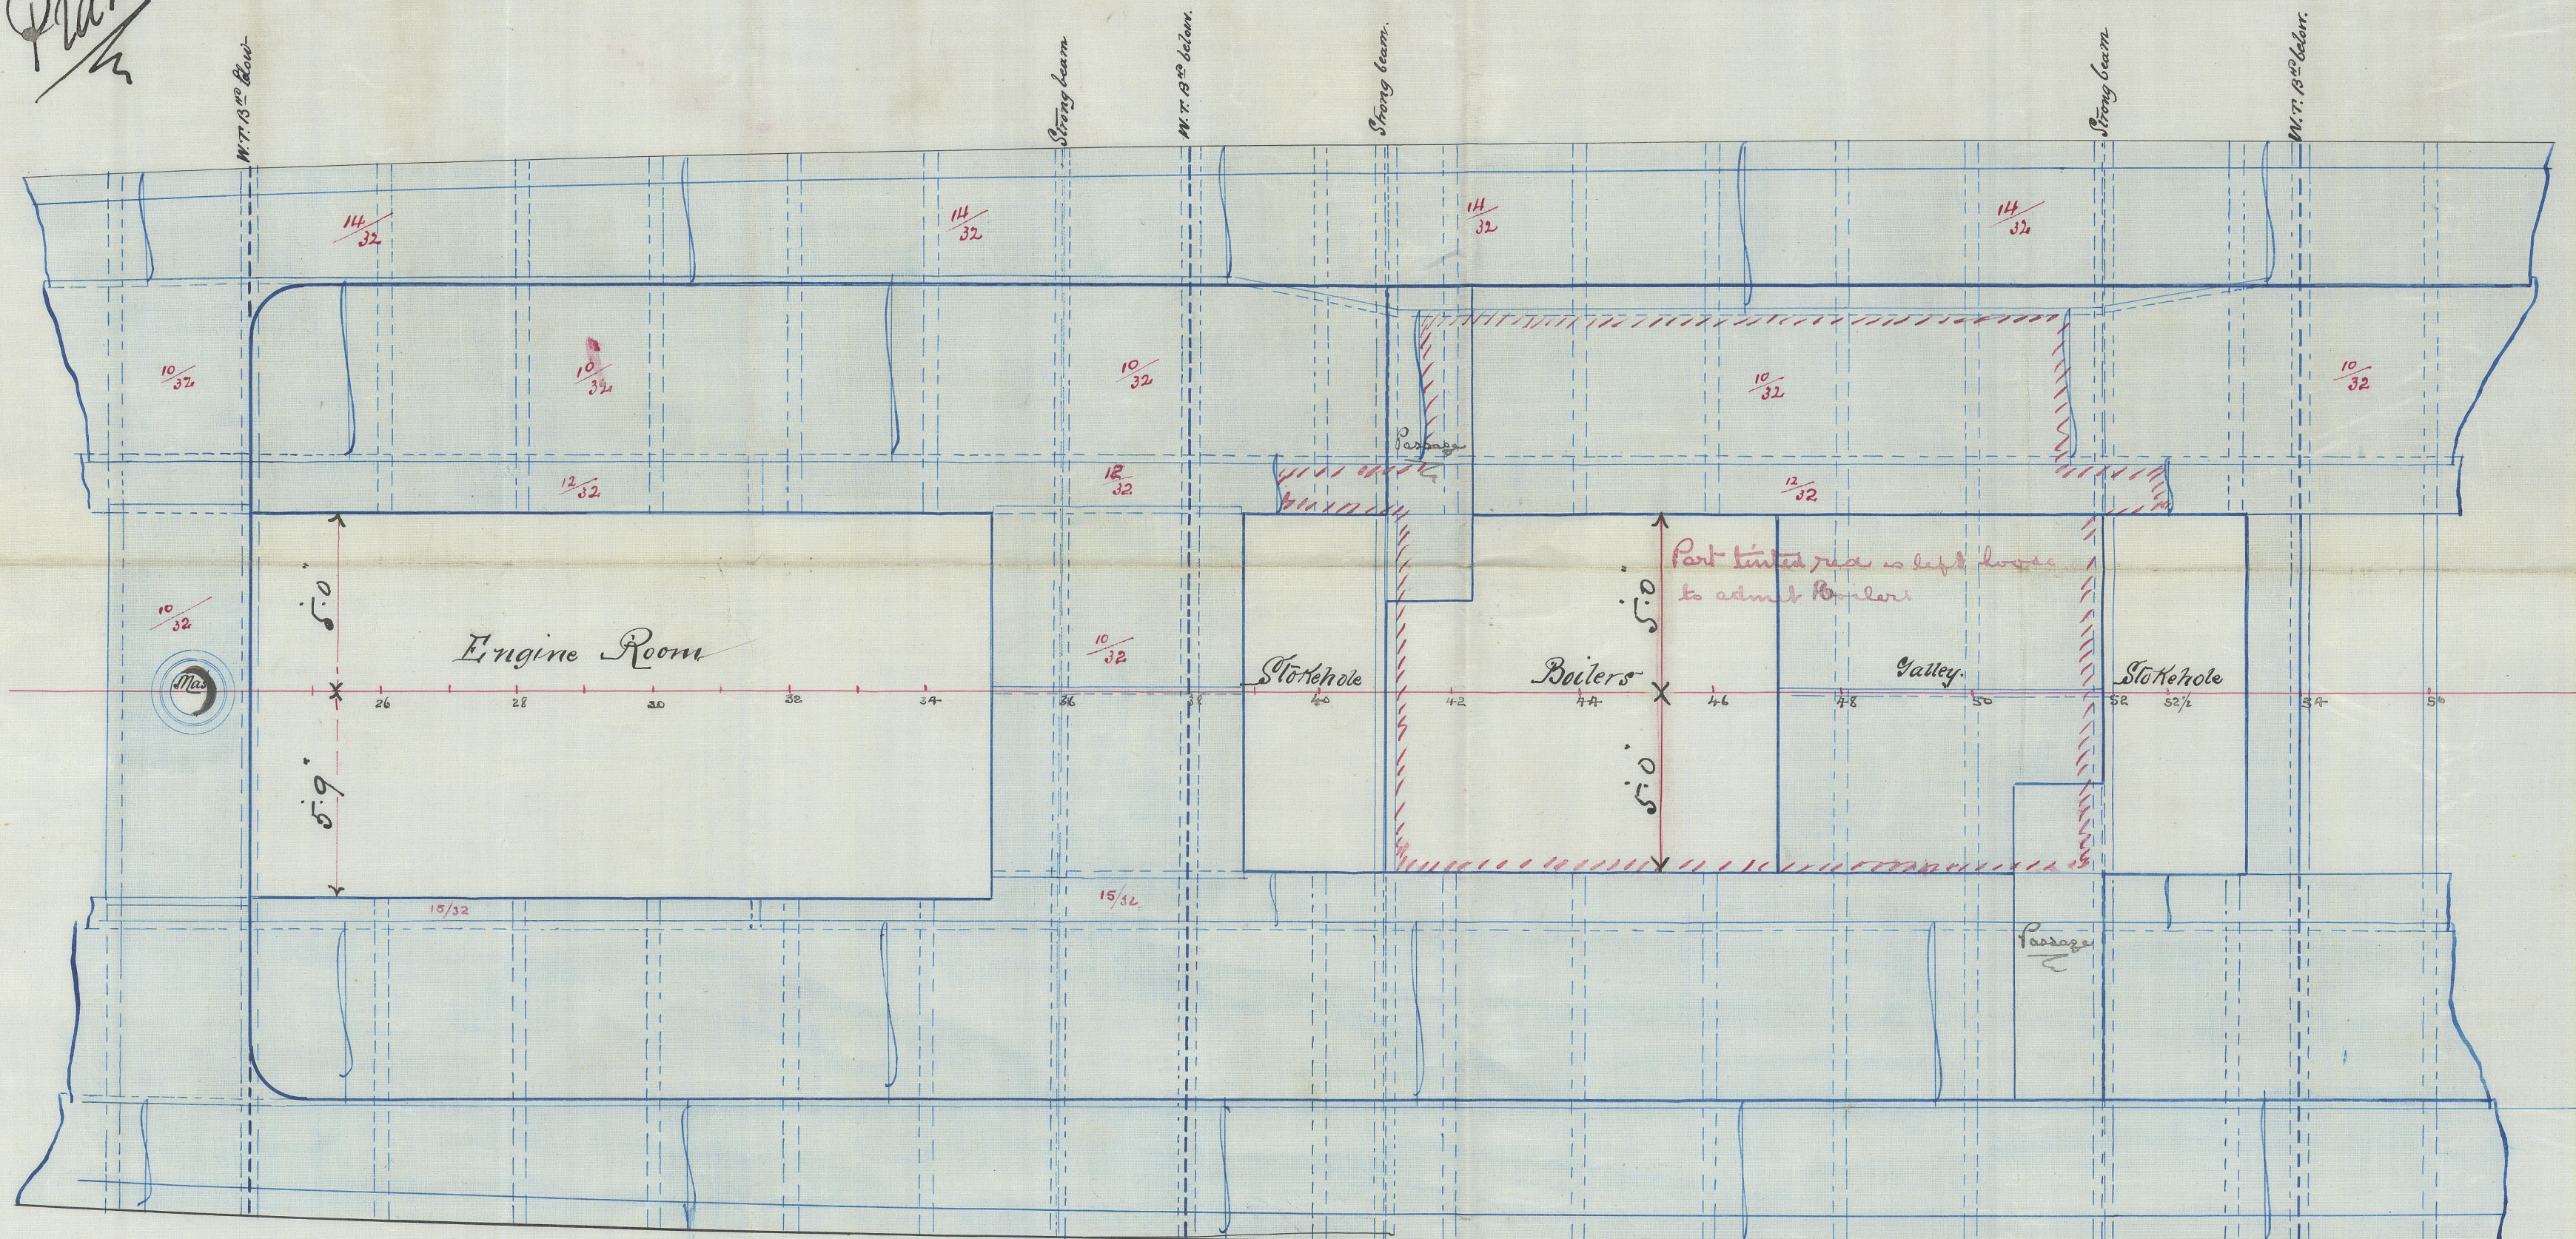

Lower Deck.

Plan

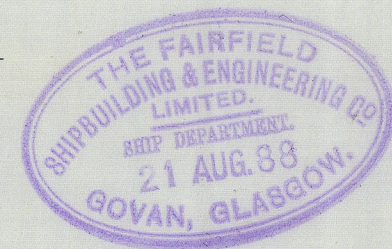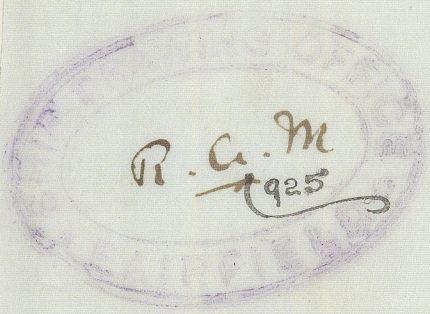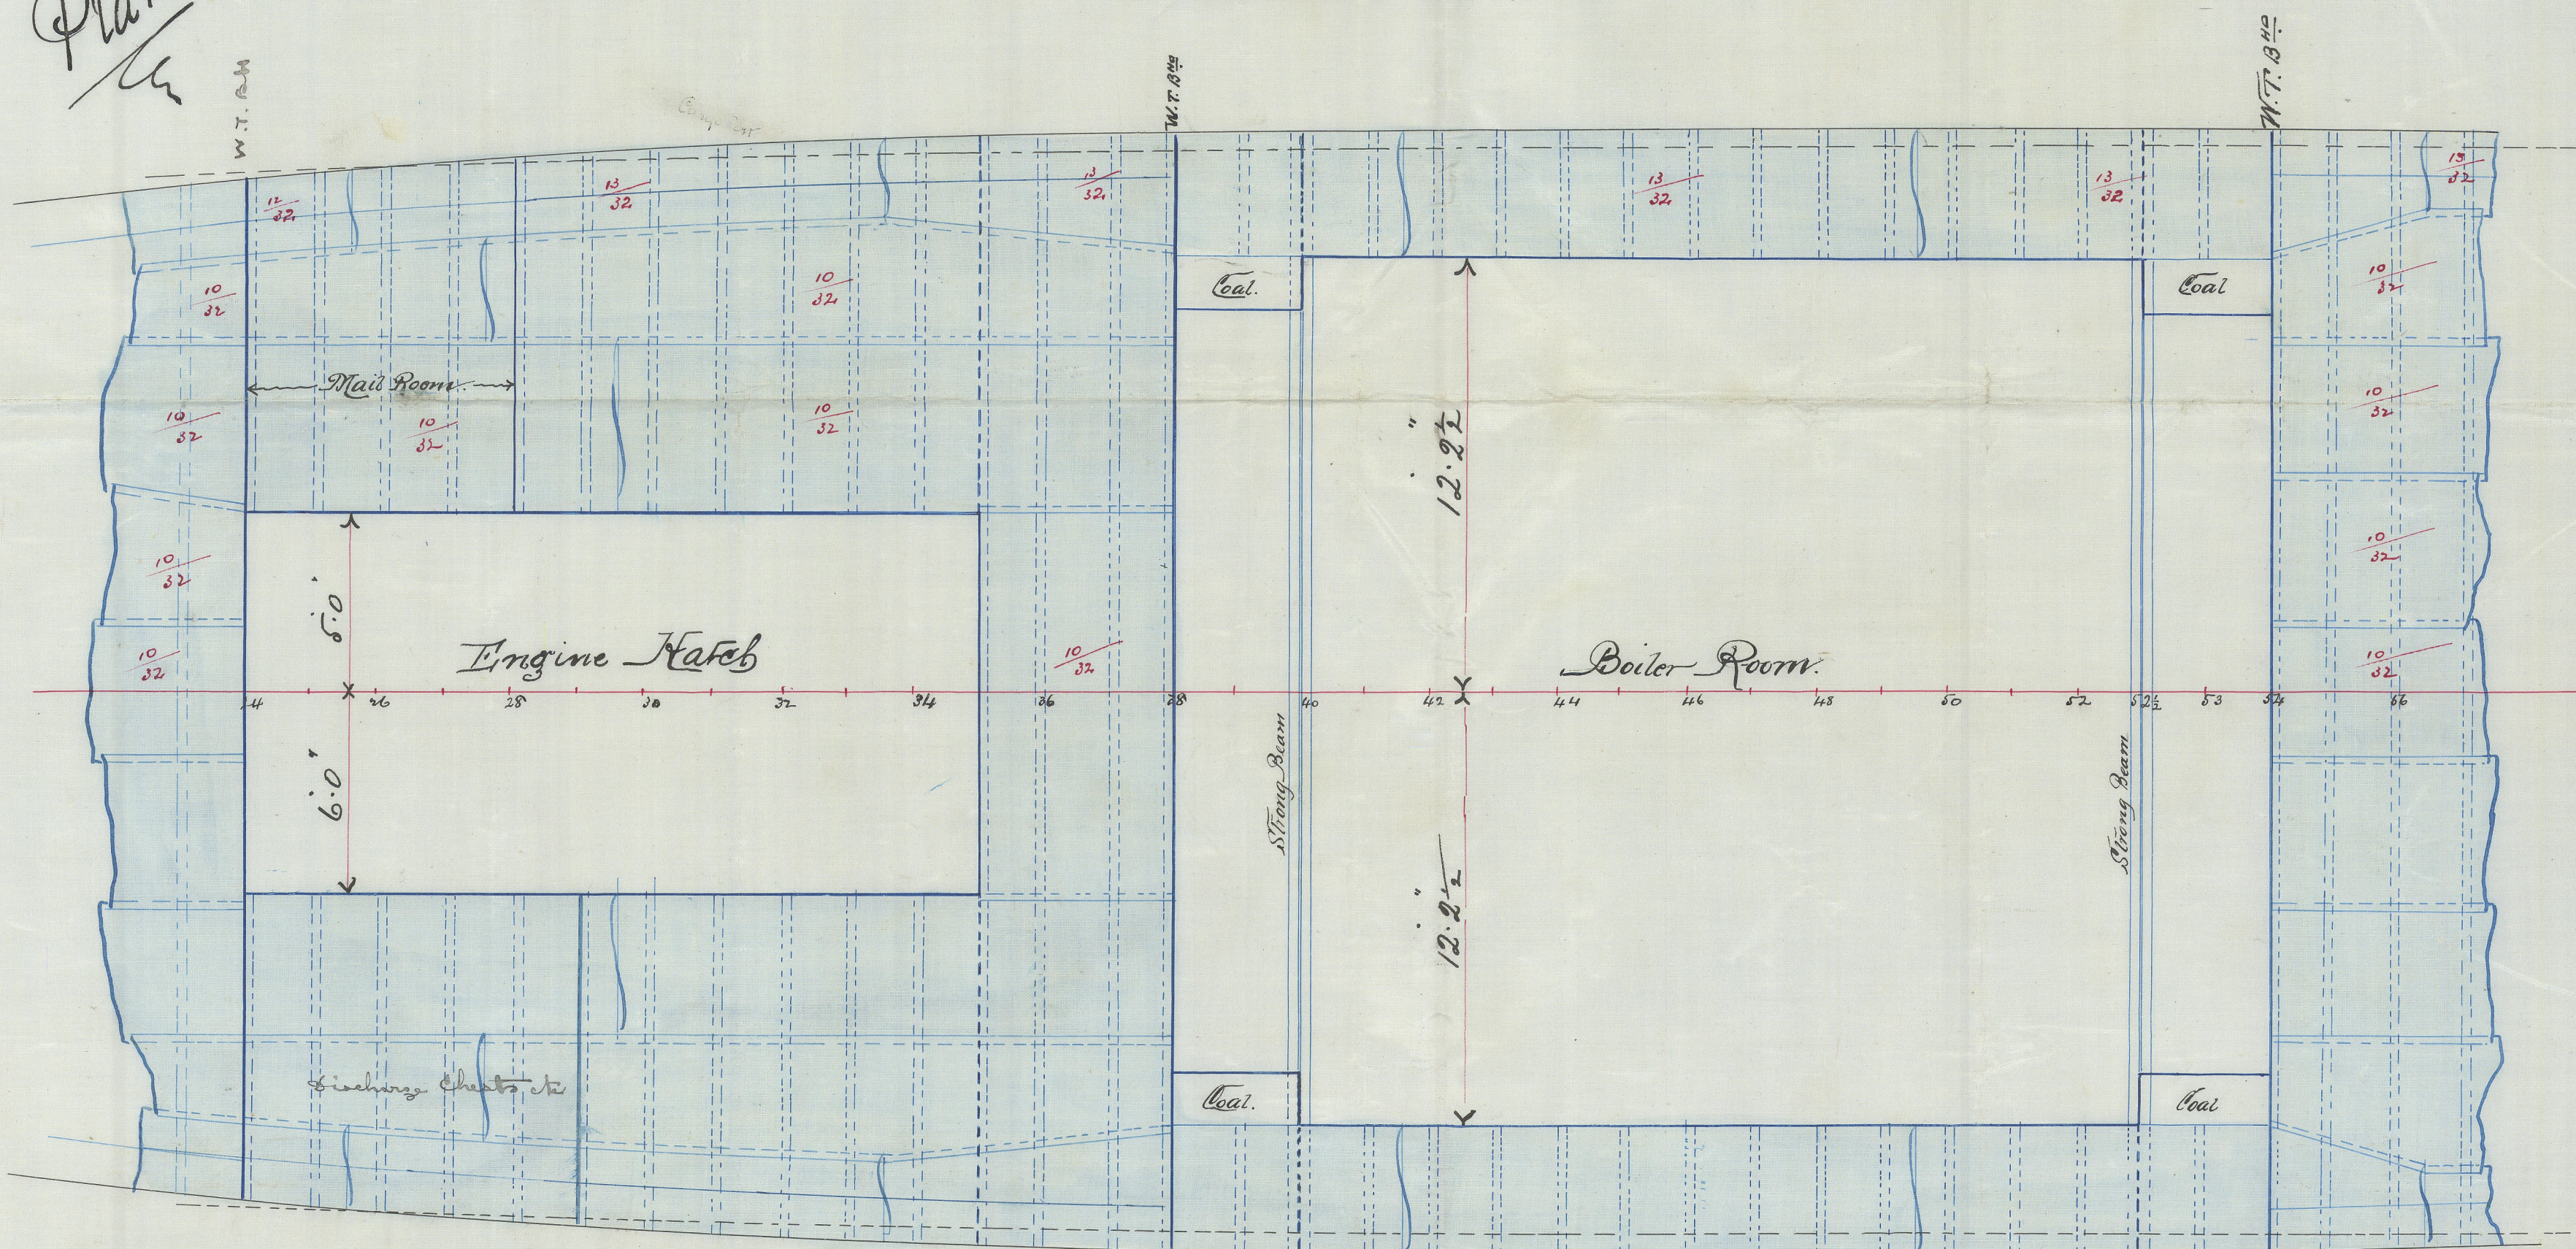

J. V. L.
23/8/88



© 2021

Lloyd's Register
Foundation