

S. S. "Stanley" Glasgow Report No. 8891


No. 335.

Midship Section

Steel Screw Steamer 200'-0" x 32'-0" ext x 20'-3" ml

Scale 1/2 inch to one foot.

See Ltr to Gls
28/7/88

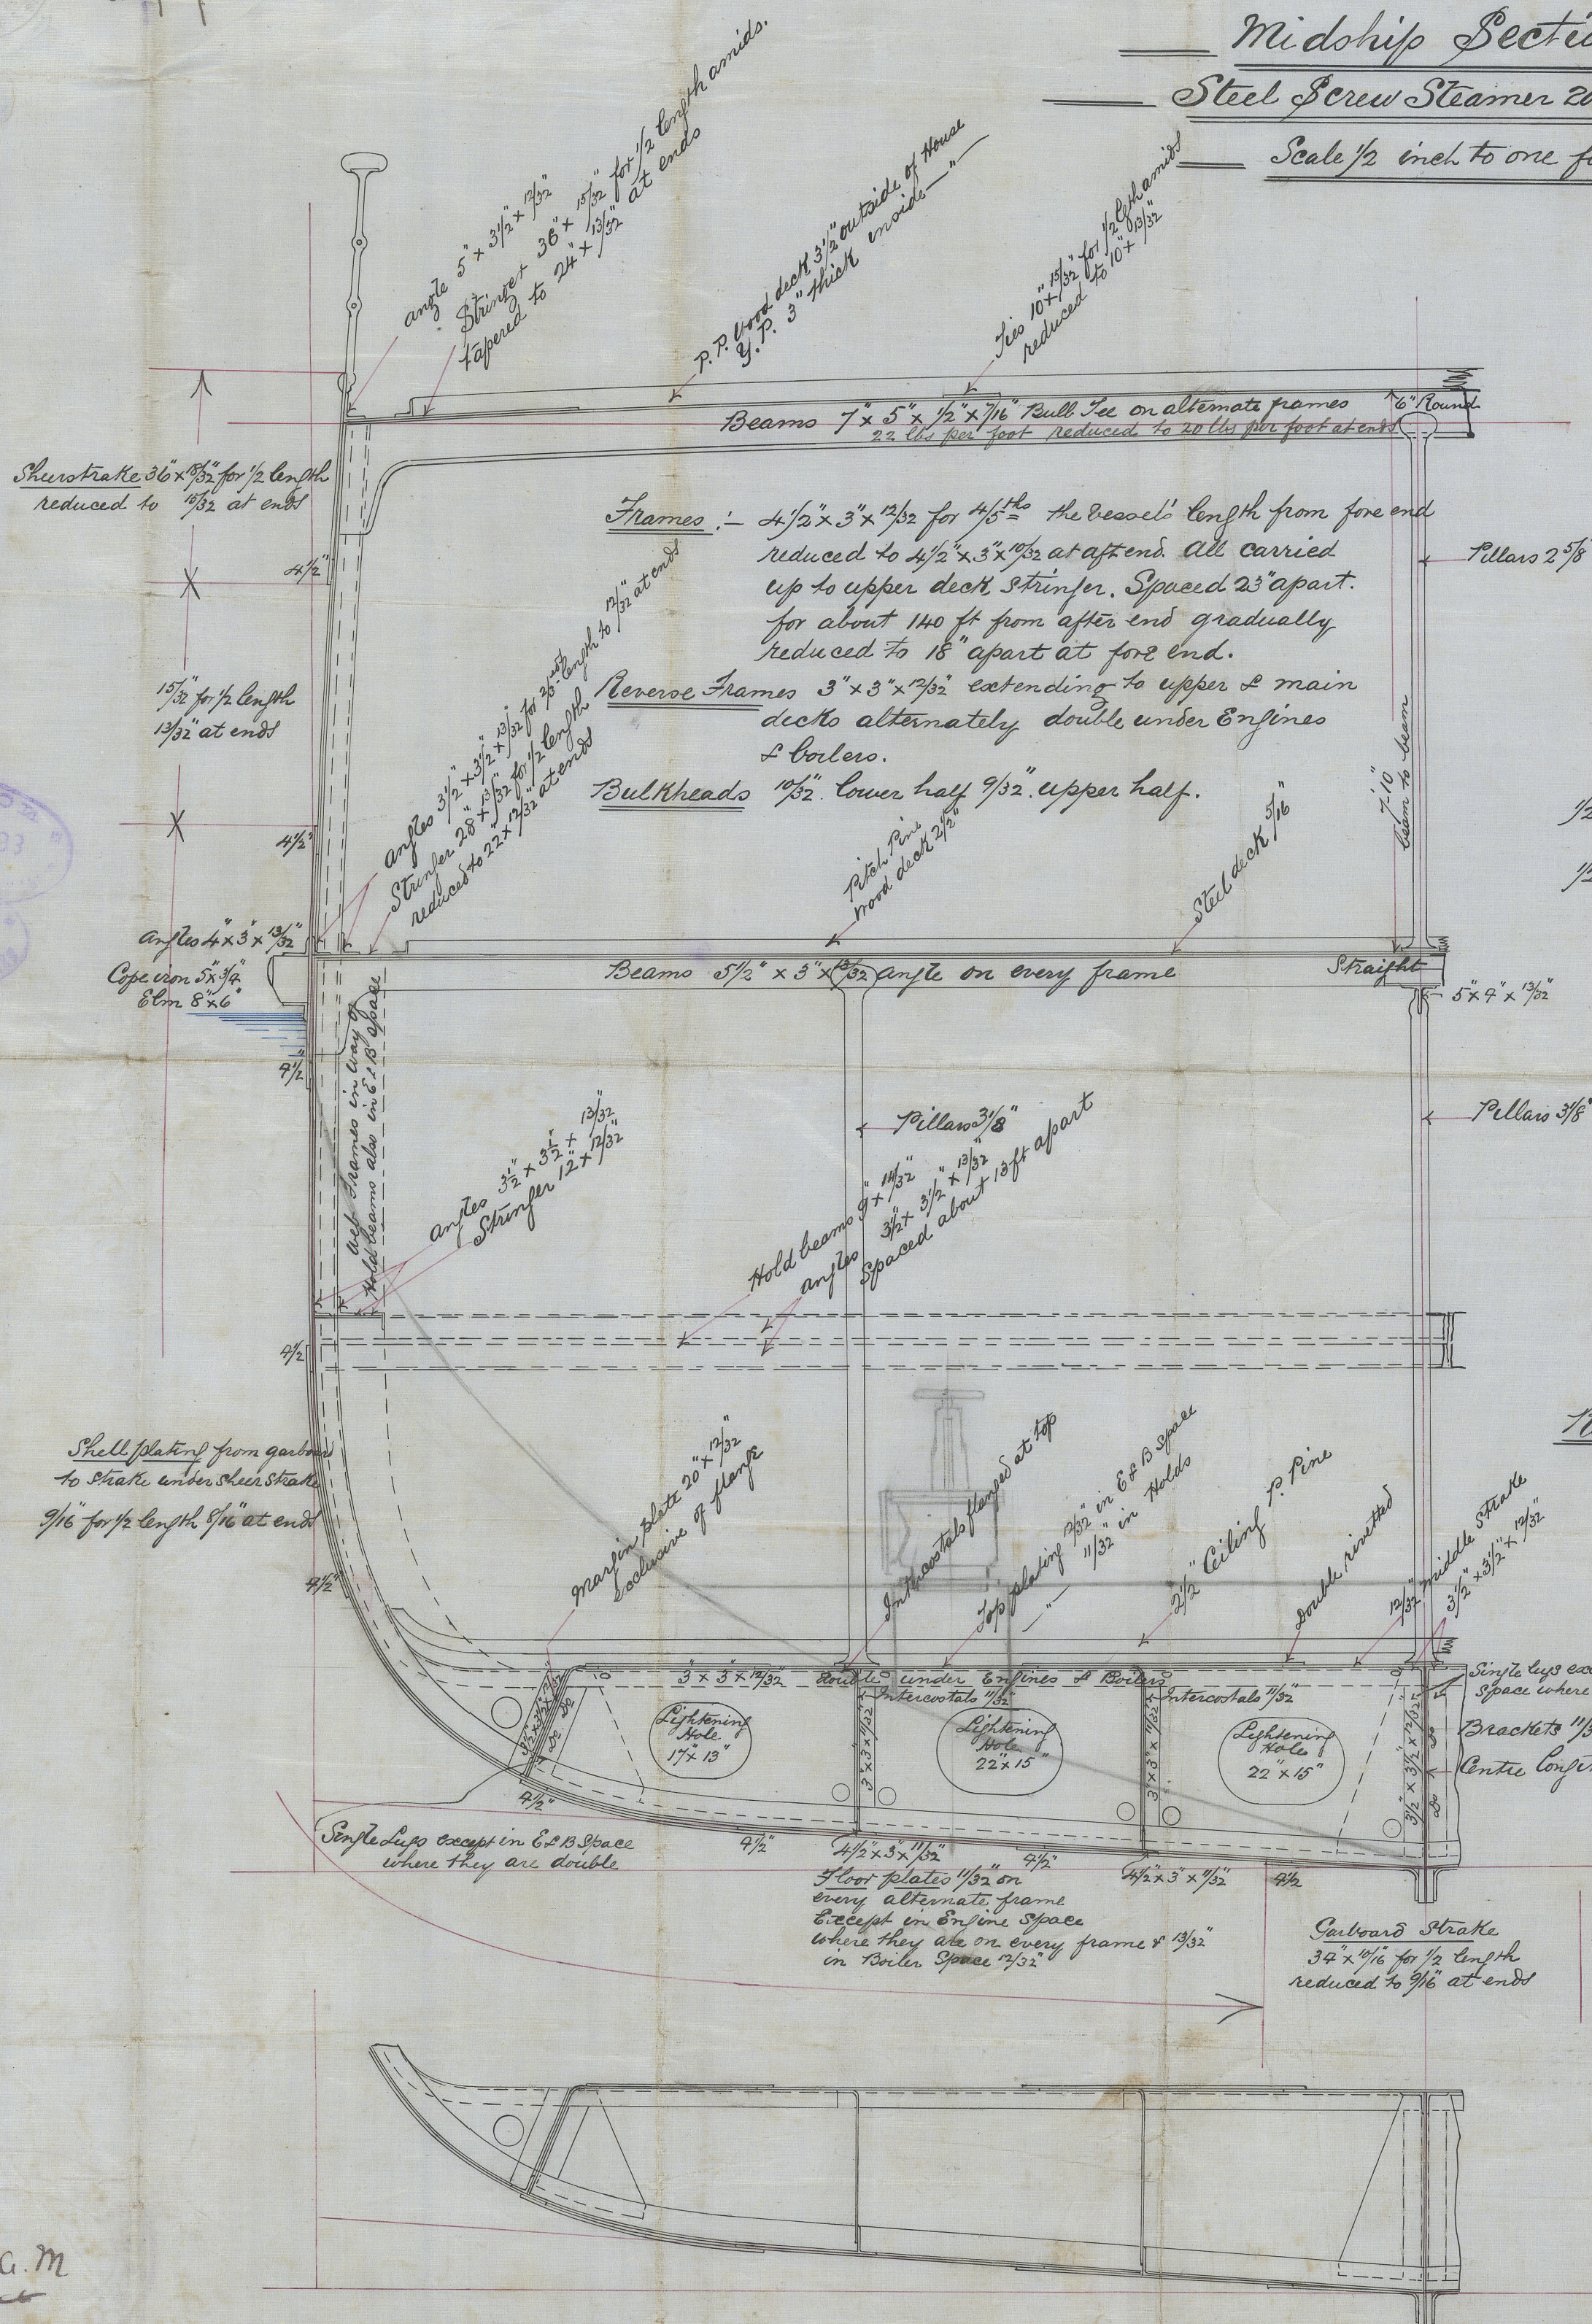

Equipment No. 13892.19

2 Boilers 18 cwt. ea. stock.
1 " 15 1/2 " " "
1 Steam 6 1/2 " " "
1 Kedge 3 1/2 " " "
1 " 1 1/2 " " "

[240 fathoms. 1 1/2" Stud Link Cable] 20 fathoms 1/2" Stream Chains
[90 fathoms 9/16" Hemp] 90 fathoms 7/8" & 90 fathoms 5/8" hawsers & warps

Class 100 A at Lloyd's

1/2 Breadth ----- 15.9
Depth ----- 20.75
1/2 Tirth ----- 33.16

Small Numeral 69.81

199

628.29

698.1

Large Numeral 138.92.19

Proportions



199 = 9.59 Depth
20.75
199 = 6.25 Breadth
31.8

Riveting - The landing edges of outside plating to be double rivetted throughout. The buttjoints of deck stringer plates sheerstrake and three strakes of plating round the bilges are to be three thirty seconds of an inch thicker than the plates they connect for half the vessel's length amidships and treble rivetted.

708/R.C.M.

28/7/88

W.S.

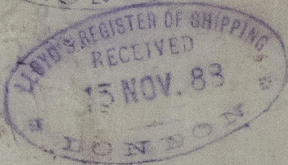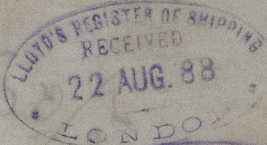

Handwritten: "Journal"

Handwritten: "No. 333"









Handwritten: "Reduced"

4610-117574



© 2021

Lloyd's Register Foundation