

See Ltr to Gls
24/6/88

RECEIVED
33 JUL 88
LONDON


S. S. "Stanley" Glasgow Report No. 8891.

Steel Screw Steamer. N 335

Profile

Scale 1/8" = one foot

See separate
sketch

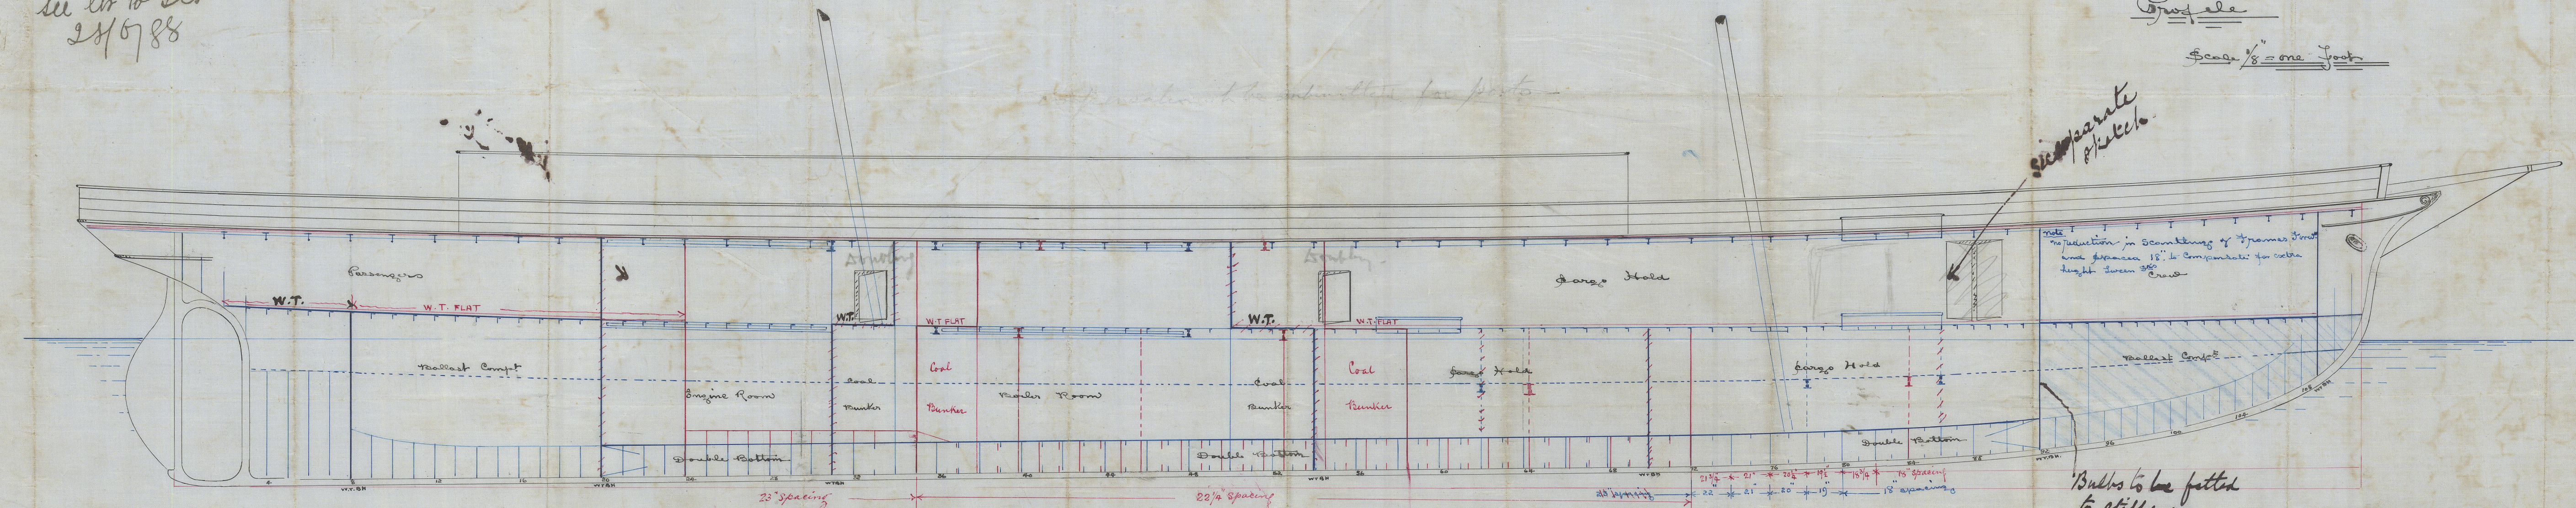


Note: Reduction in scantlings of frames fore and aft, and spaces 18" to compensate for extra height between 360 and 365

Bulbs to be fitted to stiffeners.

R.A.M.
25/6/88



W.B.

GLS211-0298

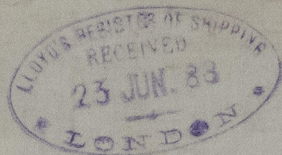

palmar & Co


10

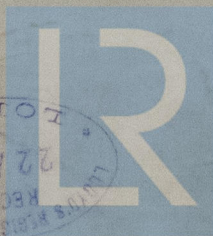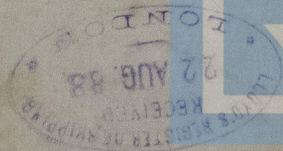

© 2021

Lloyd's Register
Foundation

LLOYD'S REGISTER OF SHIPPING
RECEIVED
16 AUG 88
LONDON

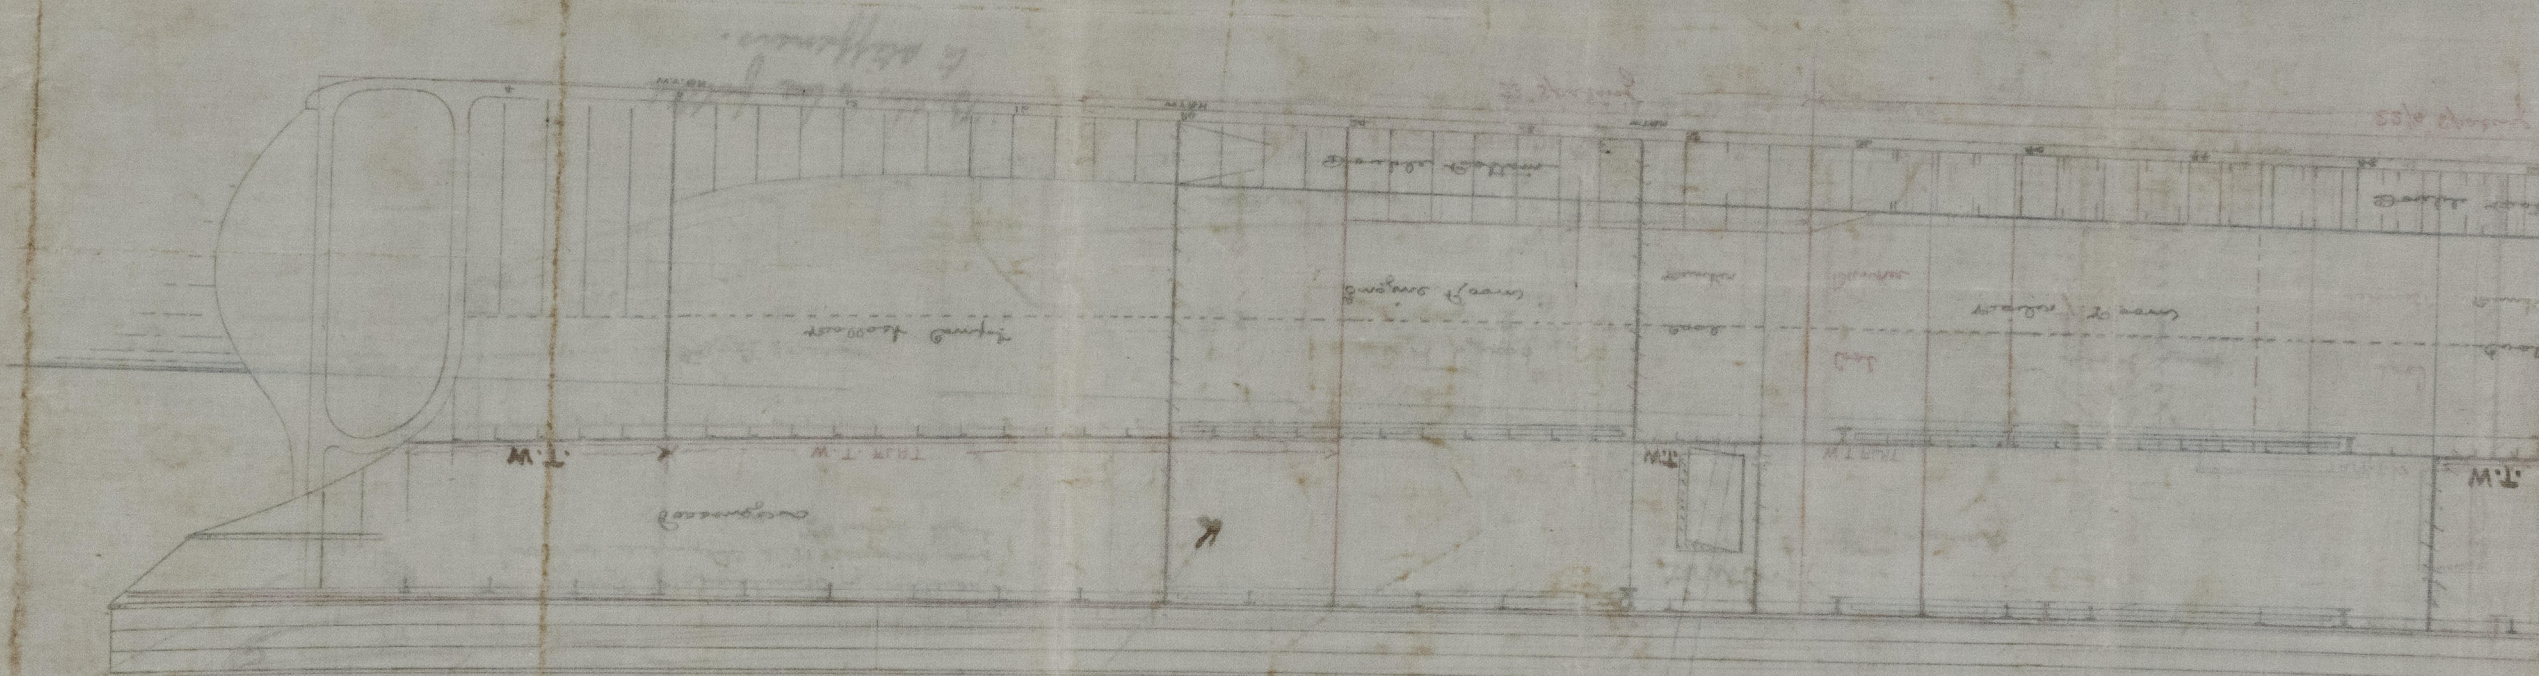

28/10/88
J. H. M. M.



© 2021
Lloyd's Register
Foundation