

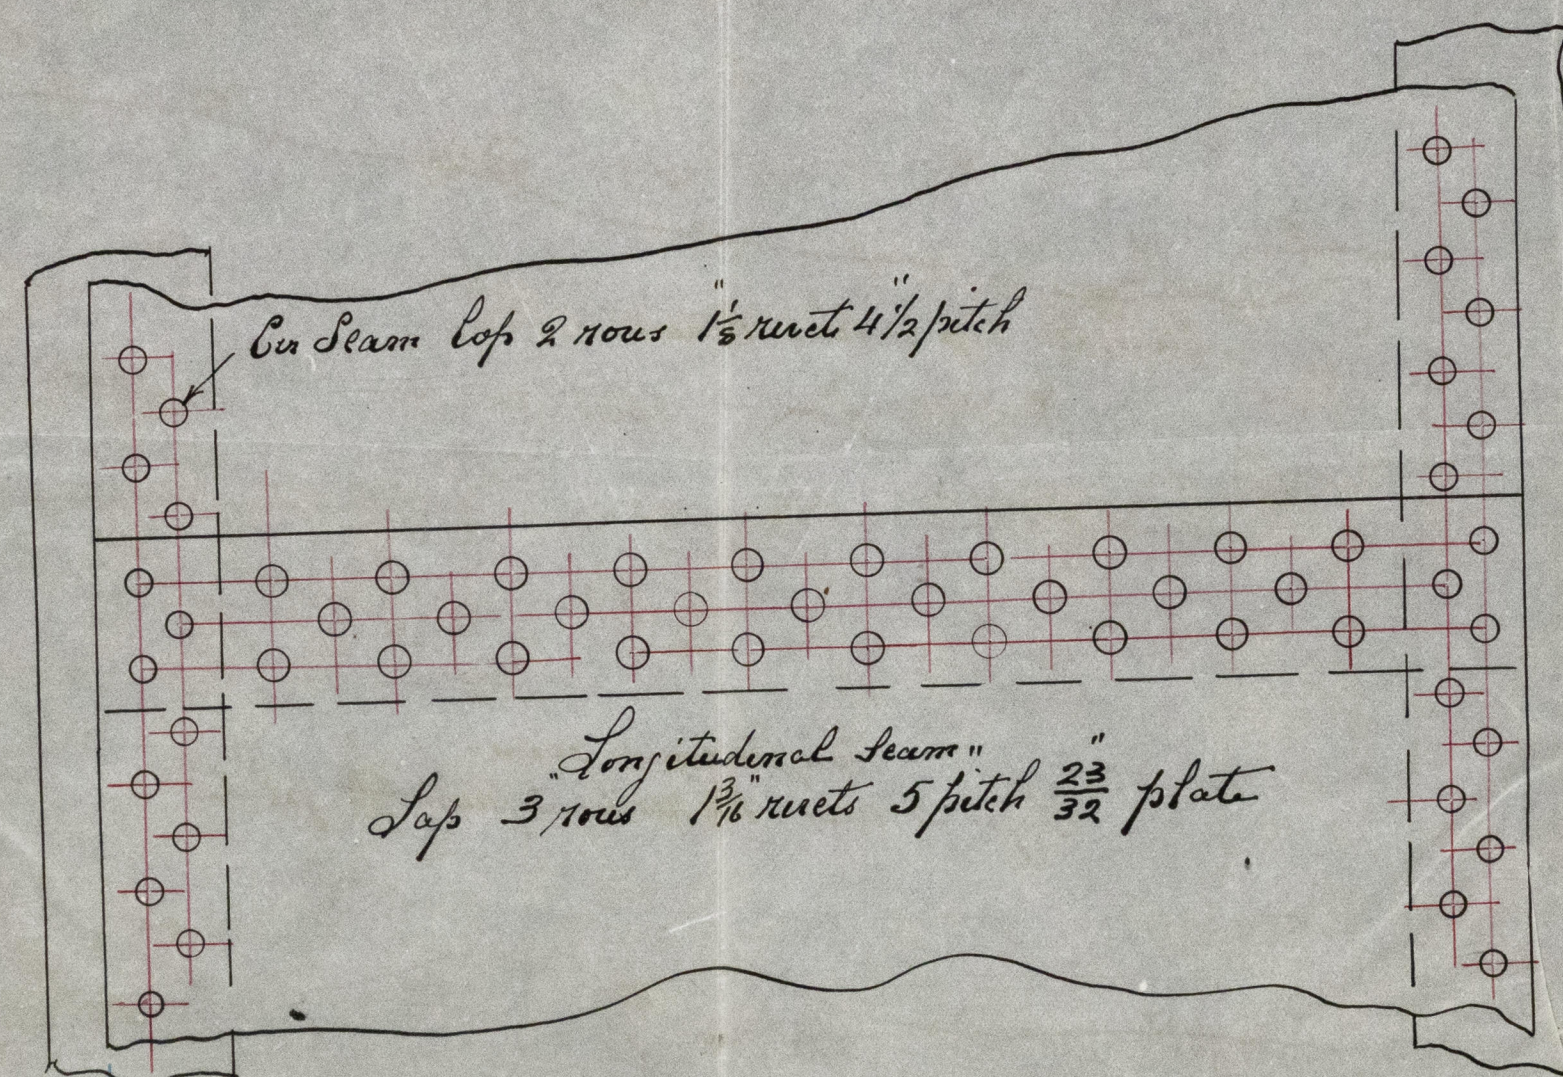
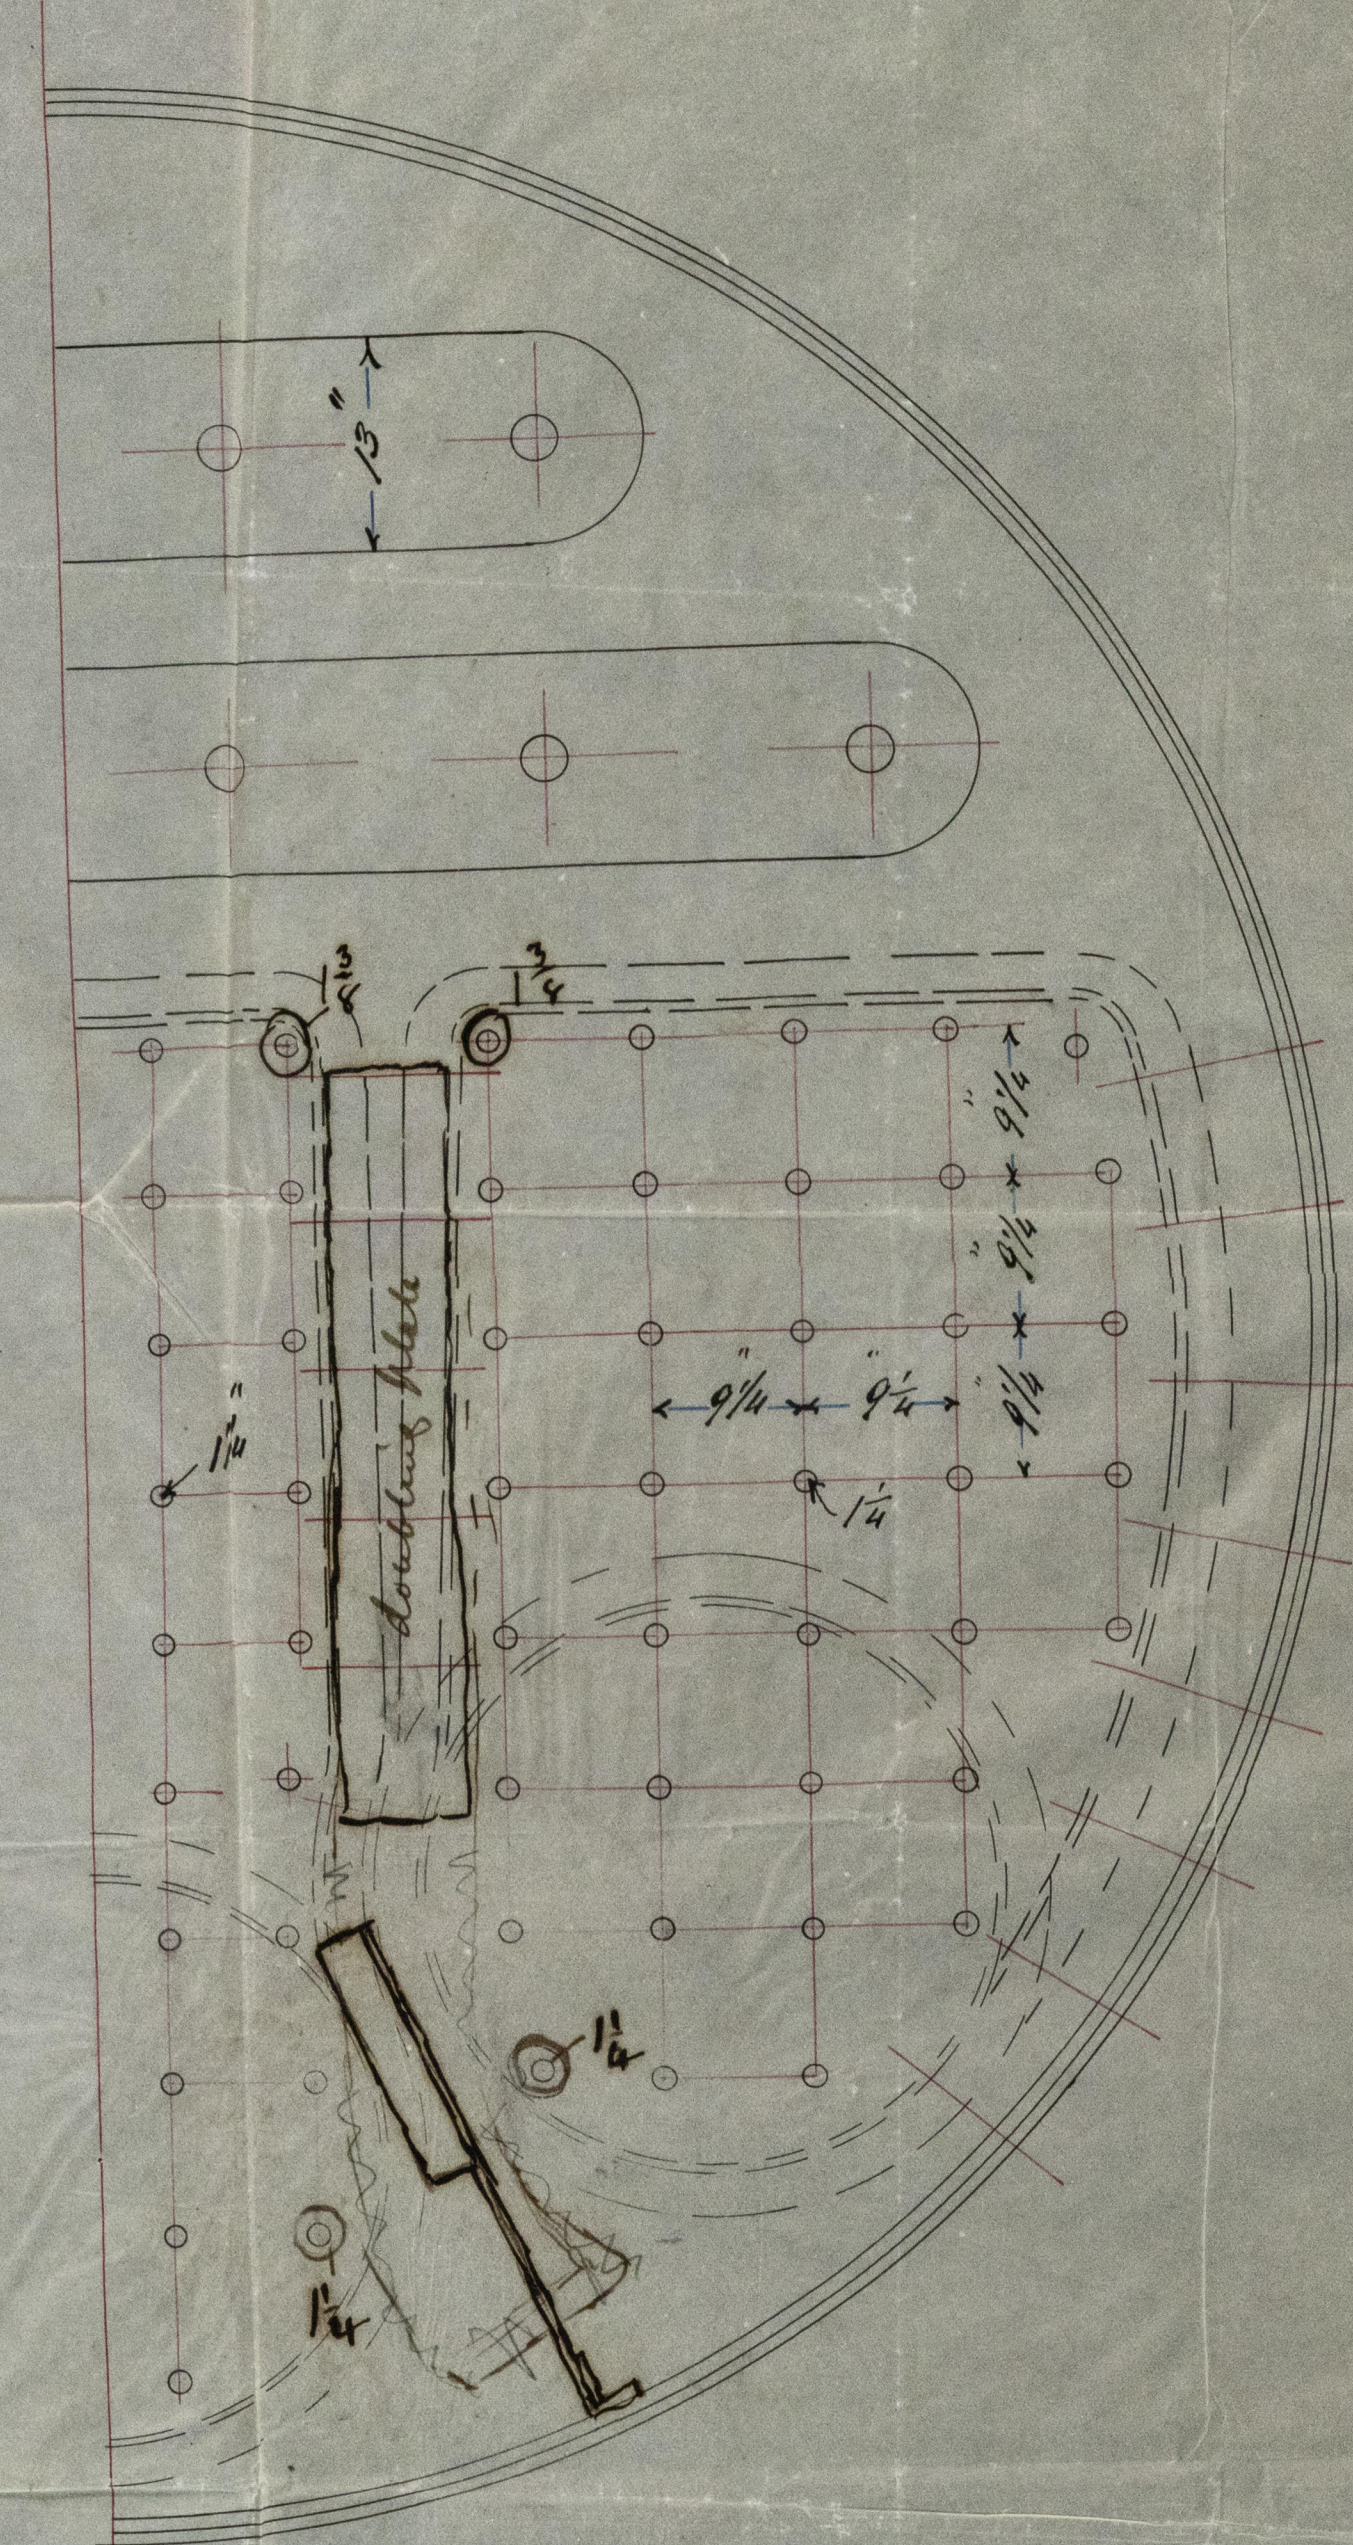


Ltr. 5/6/88

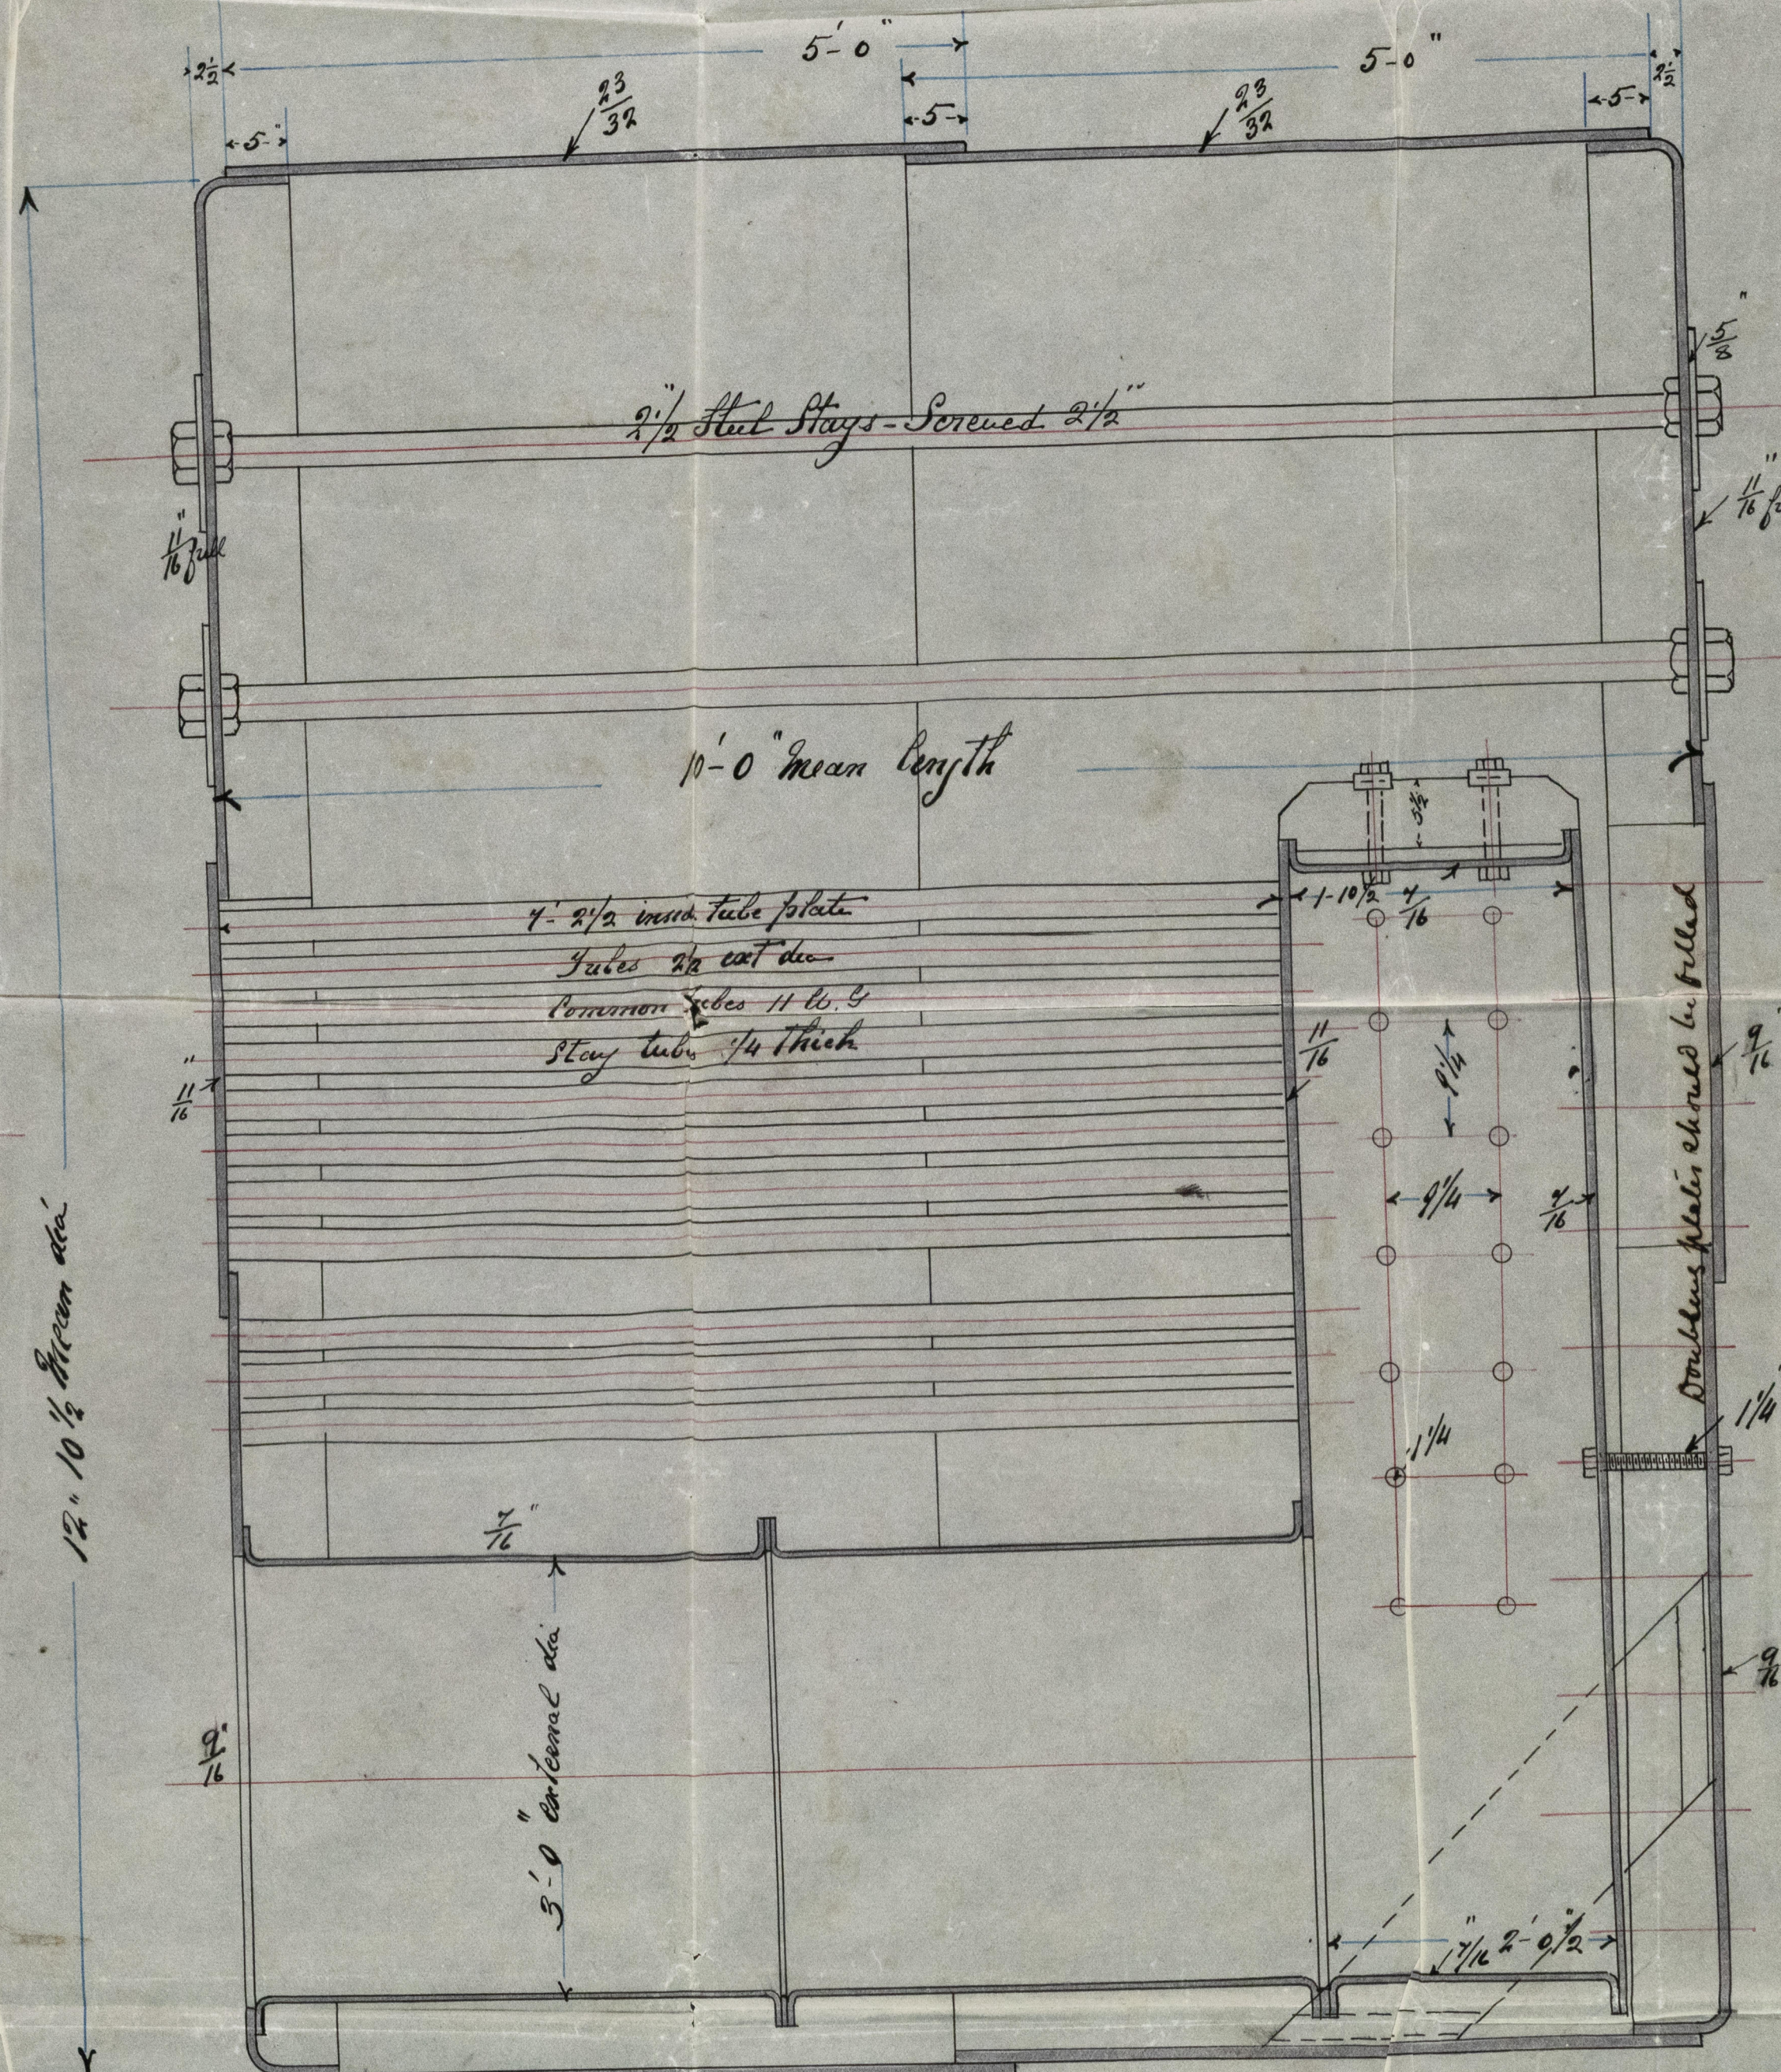

S. S. "Abydos"  
Glasgow Report No. 9024.

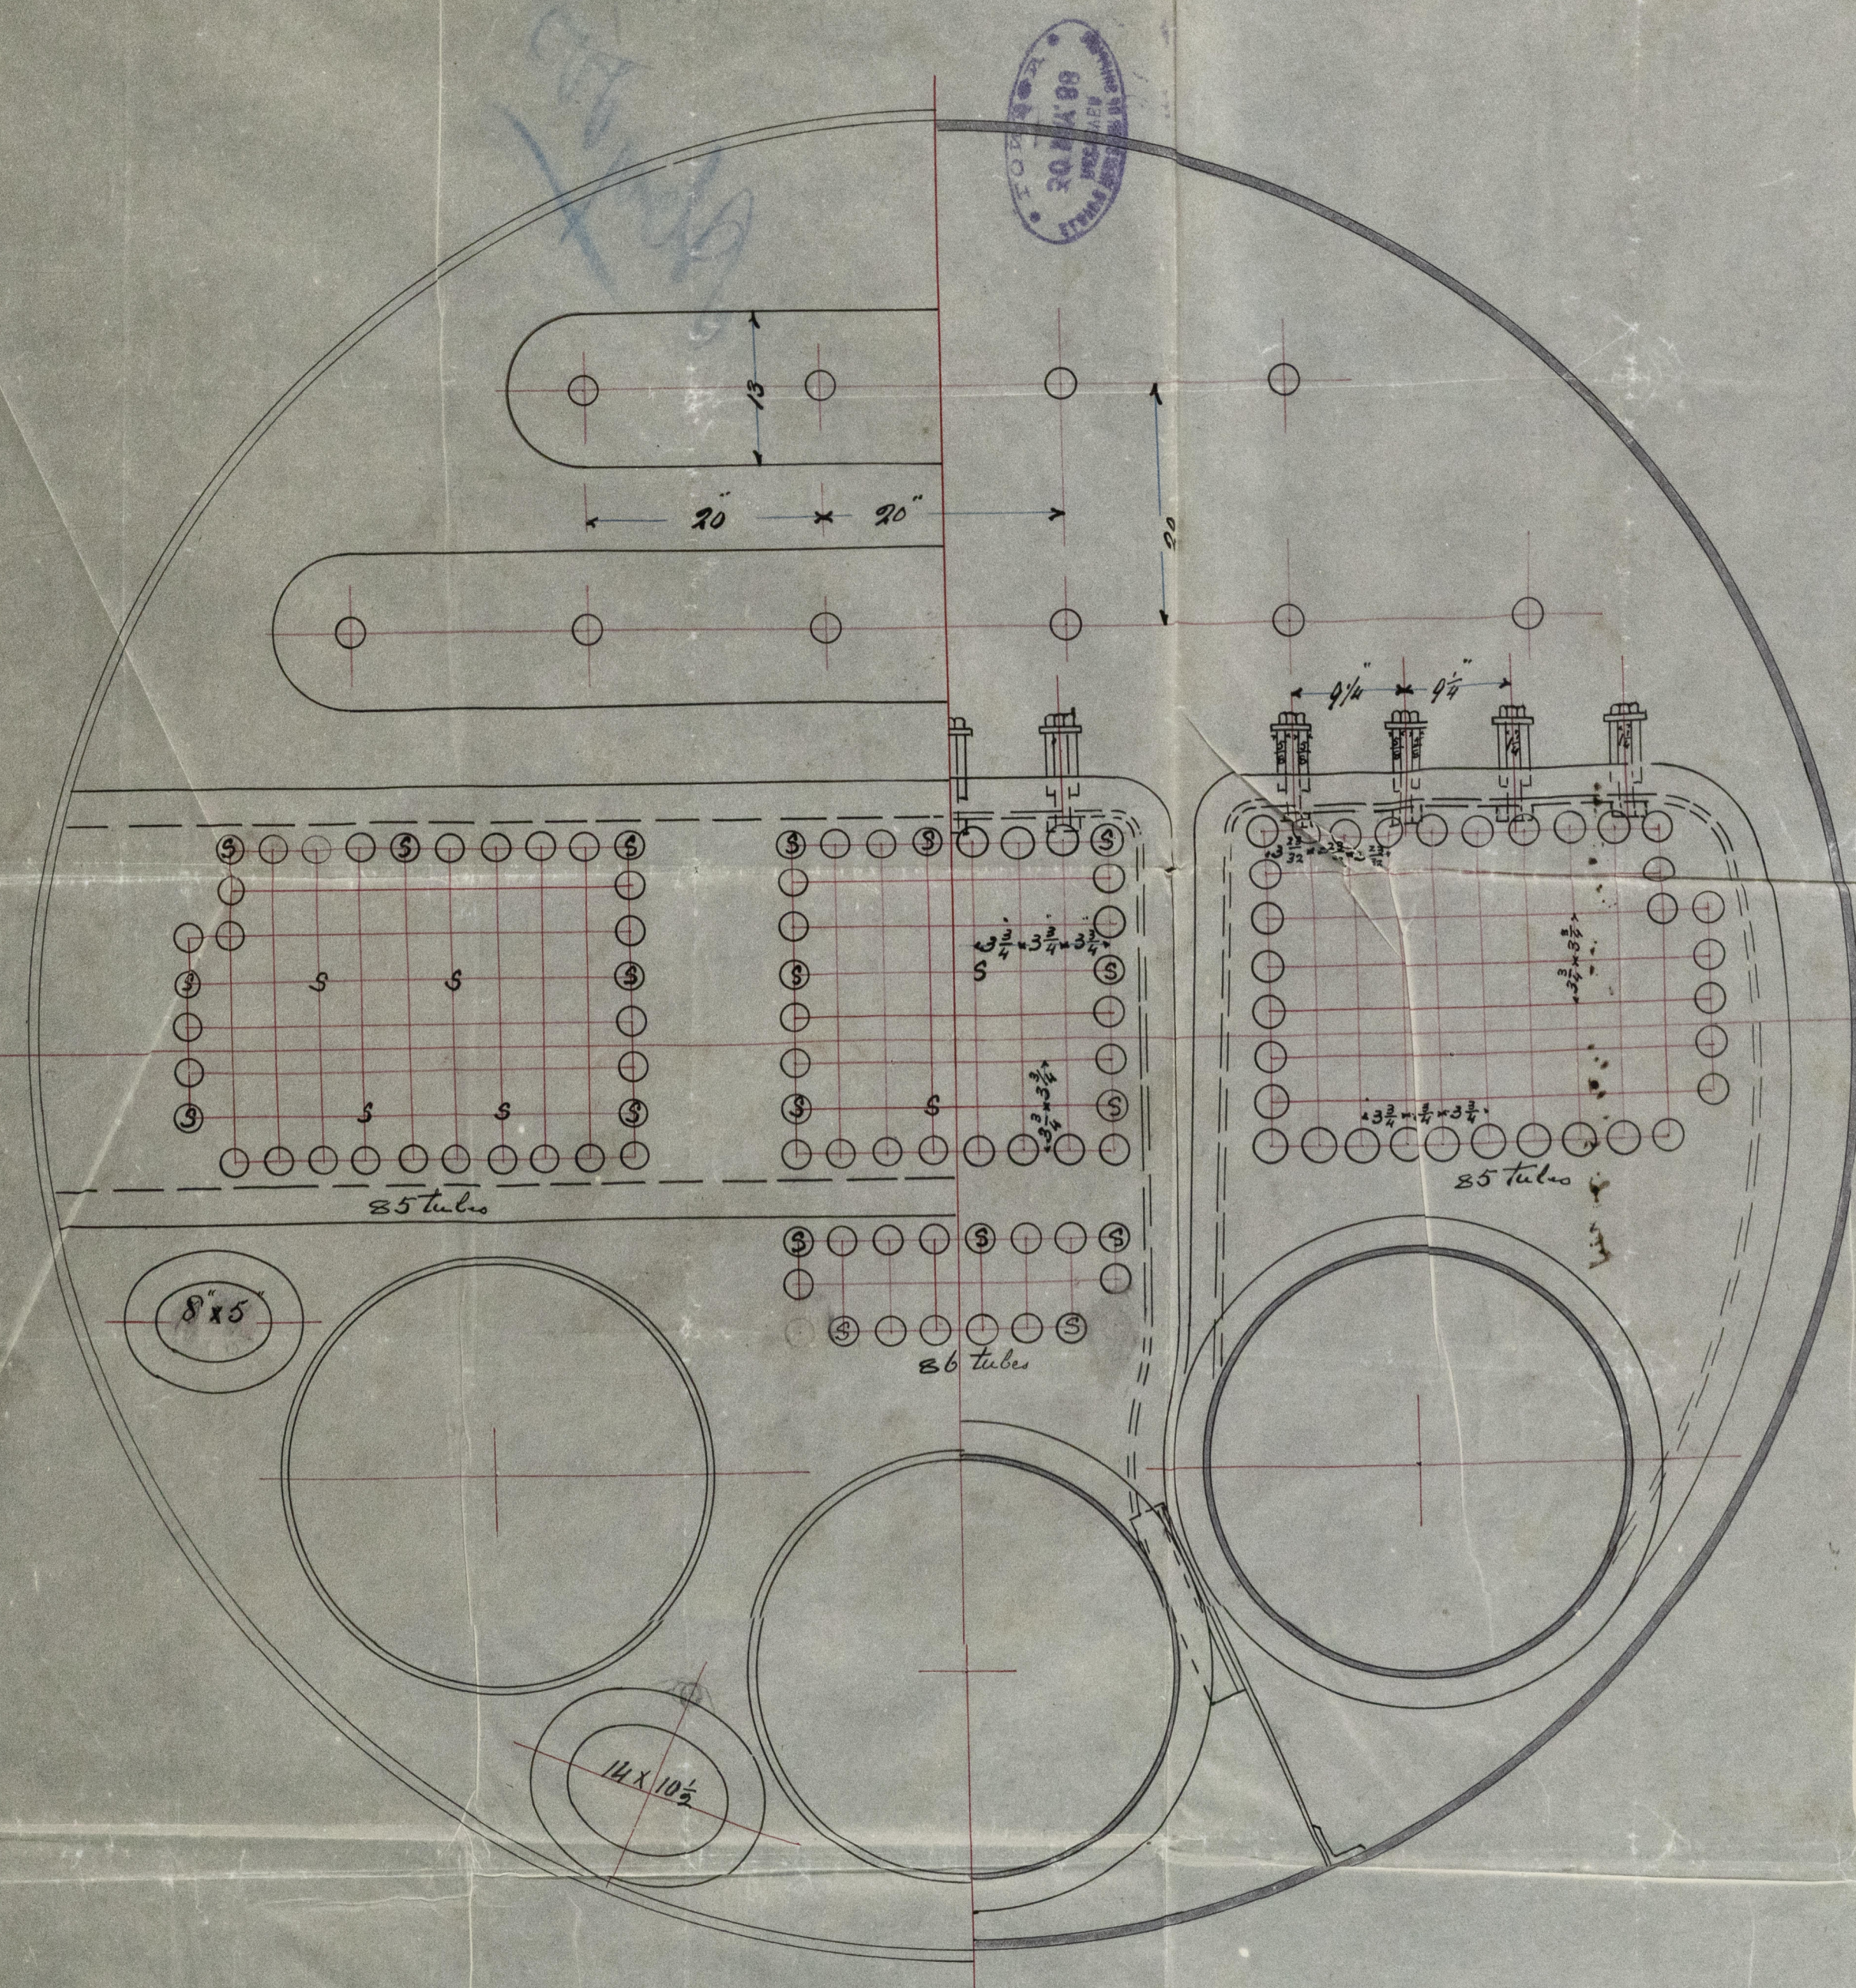


Steam Space Flaps  $2\frac{1}{2}$  dia  $2\frac{1}{2}$  Secured Steel  
 8 C Flaps  $1\frac{1}{4}$  Secured Steel nutted on both ends  
 All holes drilled Shell drilled in place

J. J. G. W.  
29.5.88.

Boilers No. 290 S.S. "Hydra"  
Working Pressure 50 lbs  
Size 1-1/4' Dia. No. 3490 21<sup>st</sup> / May / 88





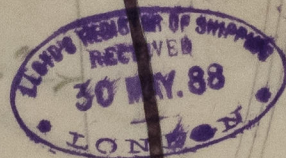

*Handwritten signature in blue ink, possibly "H. J. ...".*



© 2021  
GLS213-0037

Lloyd's Register  
Foundation