


S. S. "Strathclyde" Glasgow Report No. 9048.

PLAN OF TOP PLATING OF INNER BOTTOM IN ENGINE AND BOILER SPACE  
S, S, N<sup>o</sup> 315

20.8.88.  
5.9.88  
FRI 18 JUN 89

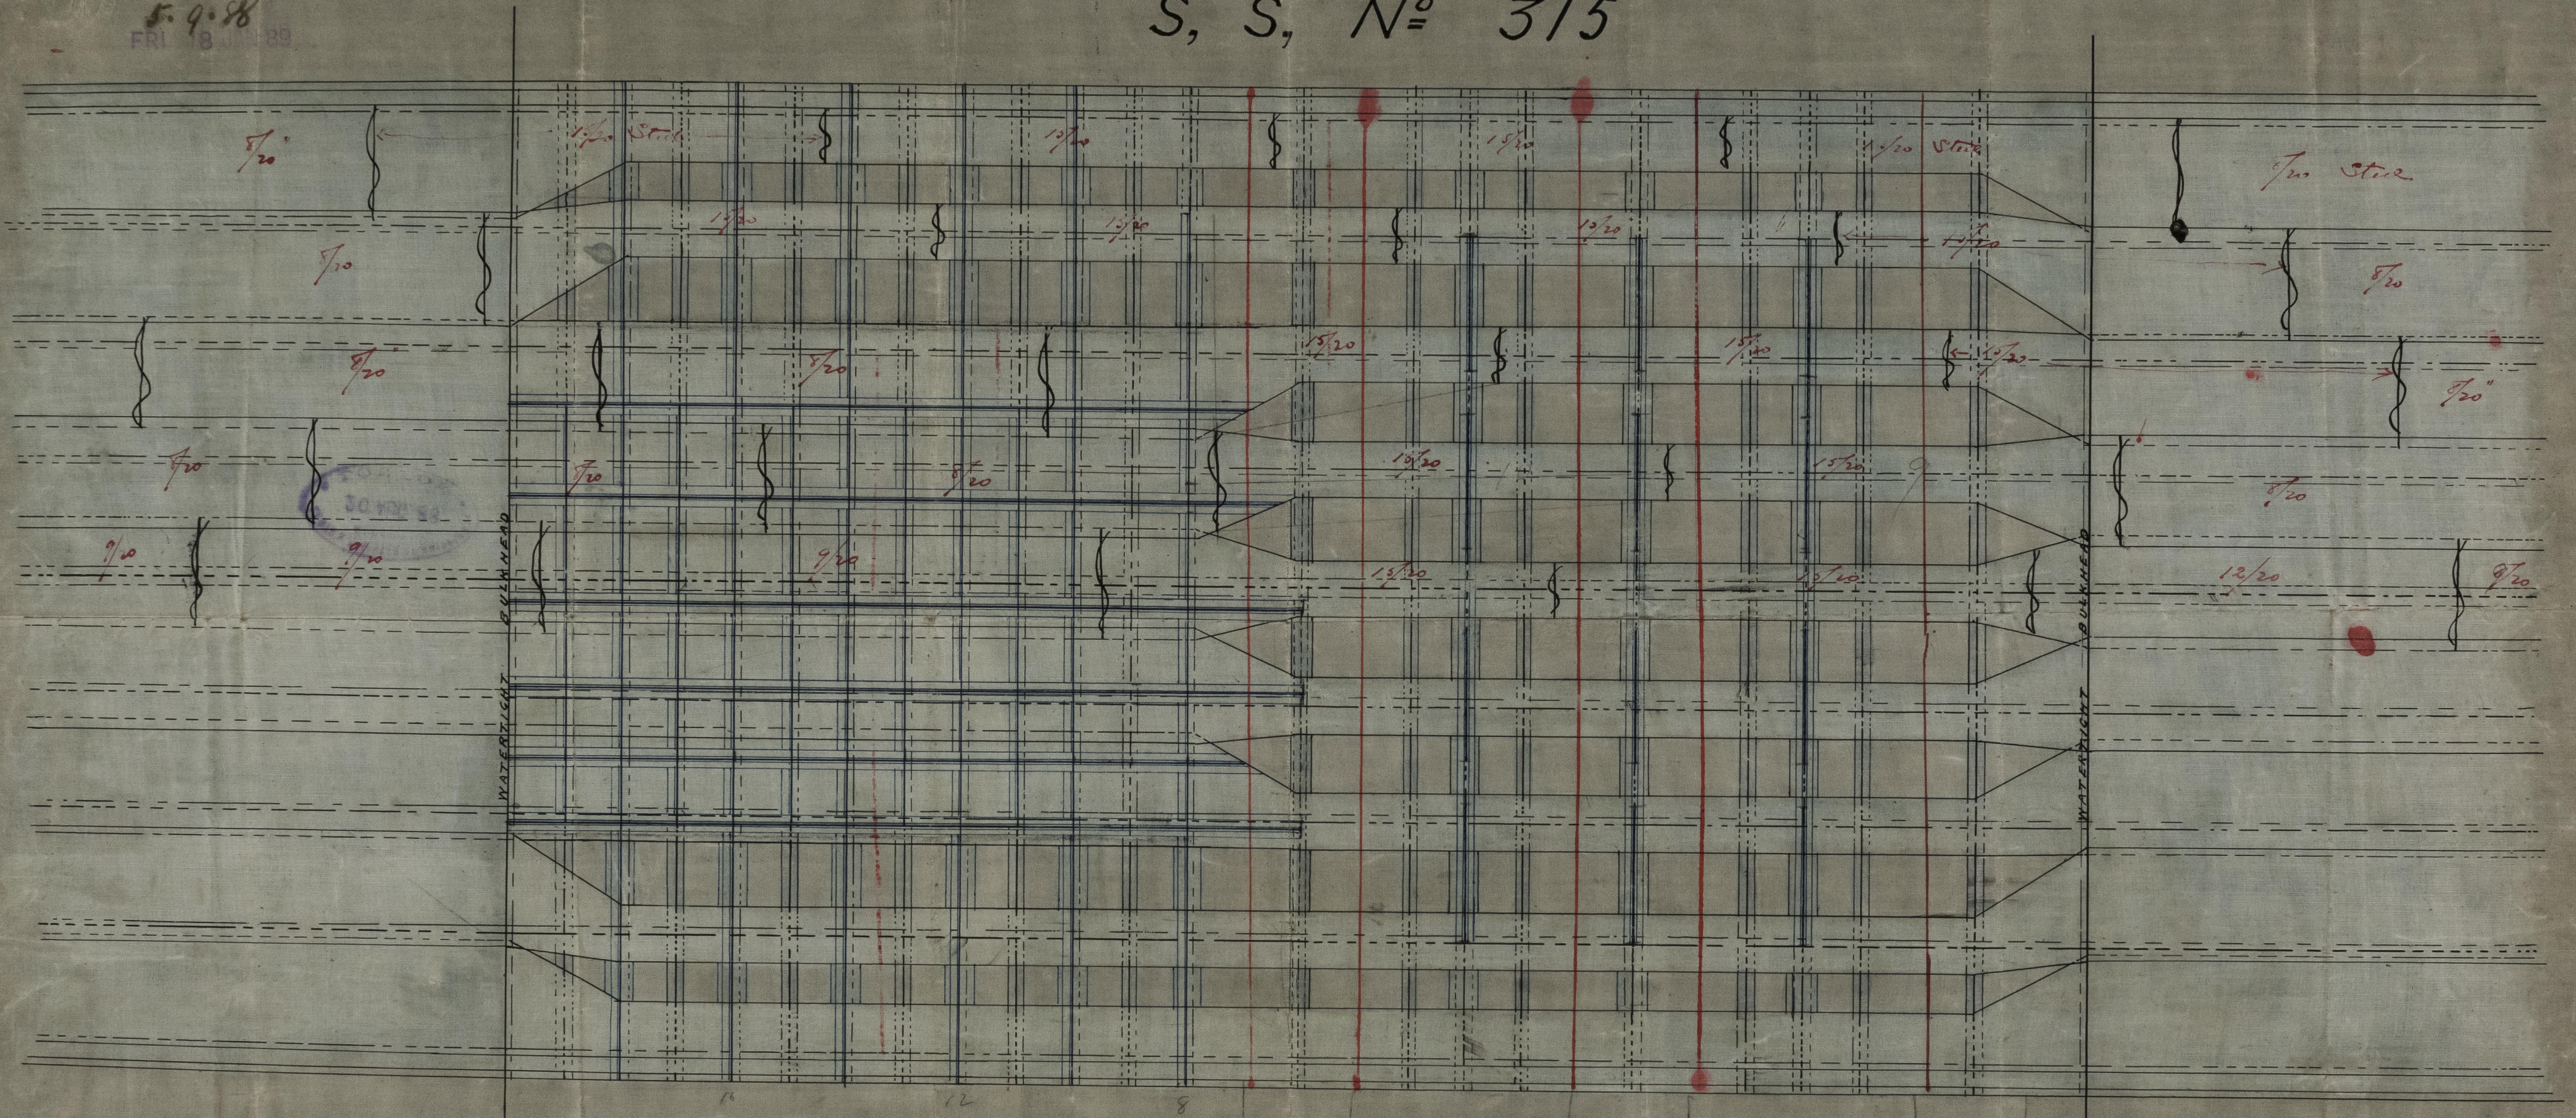

SCALE  $\frac{1}{4}$  INCH TO A FOOT

18M  
5/9/88

Alex<sup>r</sup> Stephen & Sons.  
SHIPBUILDERS & ENGINEERS.  
GLASGOW

DRAWING NO. 4606  
16/8/88

J. S. L. 18/8/88



Lloyd's Register  
Foundation  
GLS213-0090



The image displays a book cover or endpaper with a complex, repeating geometric pattern. The pattern consists of horizontal bands of alternating blue and tan colors, with small blue dots placed at regular intervals within the blue bands. This patterned section is bordered on the right by a plain, light blue textured surface. The overall appearance is that of a vintage or antique book binding.

1870  
1871  
25