


S. S. "Strathclyde" Glasgow Report N^o. 9048.

Leebr. to
Glo. 28/6/88
17/9/88
FRI 18 JAN 89

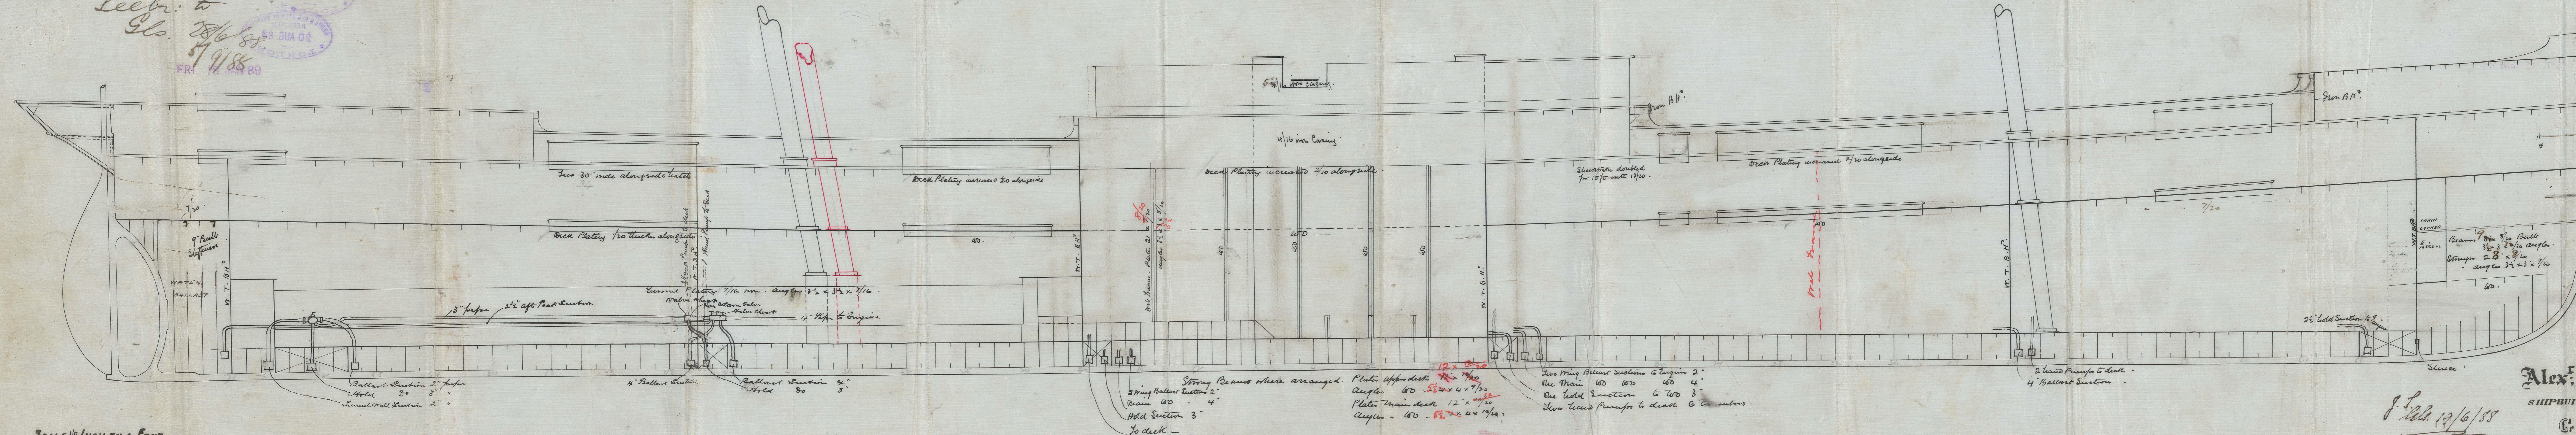

SCALE $\frac{1}{8}$ INCH TO A FOOT

Alex^r, Stephen & Sons.

SHIPBUILDERS & ENGINEERS.

GLASGOW

DRAWING NO. 4


GLS213-0099 18/6

18

1890/5
LLOYD'S REGISTER OF SHIPPING
RECEIVED
20 JUN. 88
LONDON

LLOYD'S REGISTER OF SHIPPING
RECEIVED
20 AUG. 88
LONDON

LLOYD'S REGISTER OF SHIPPING
RECEIVED
30 AUG. 88
LONDON

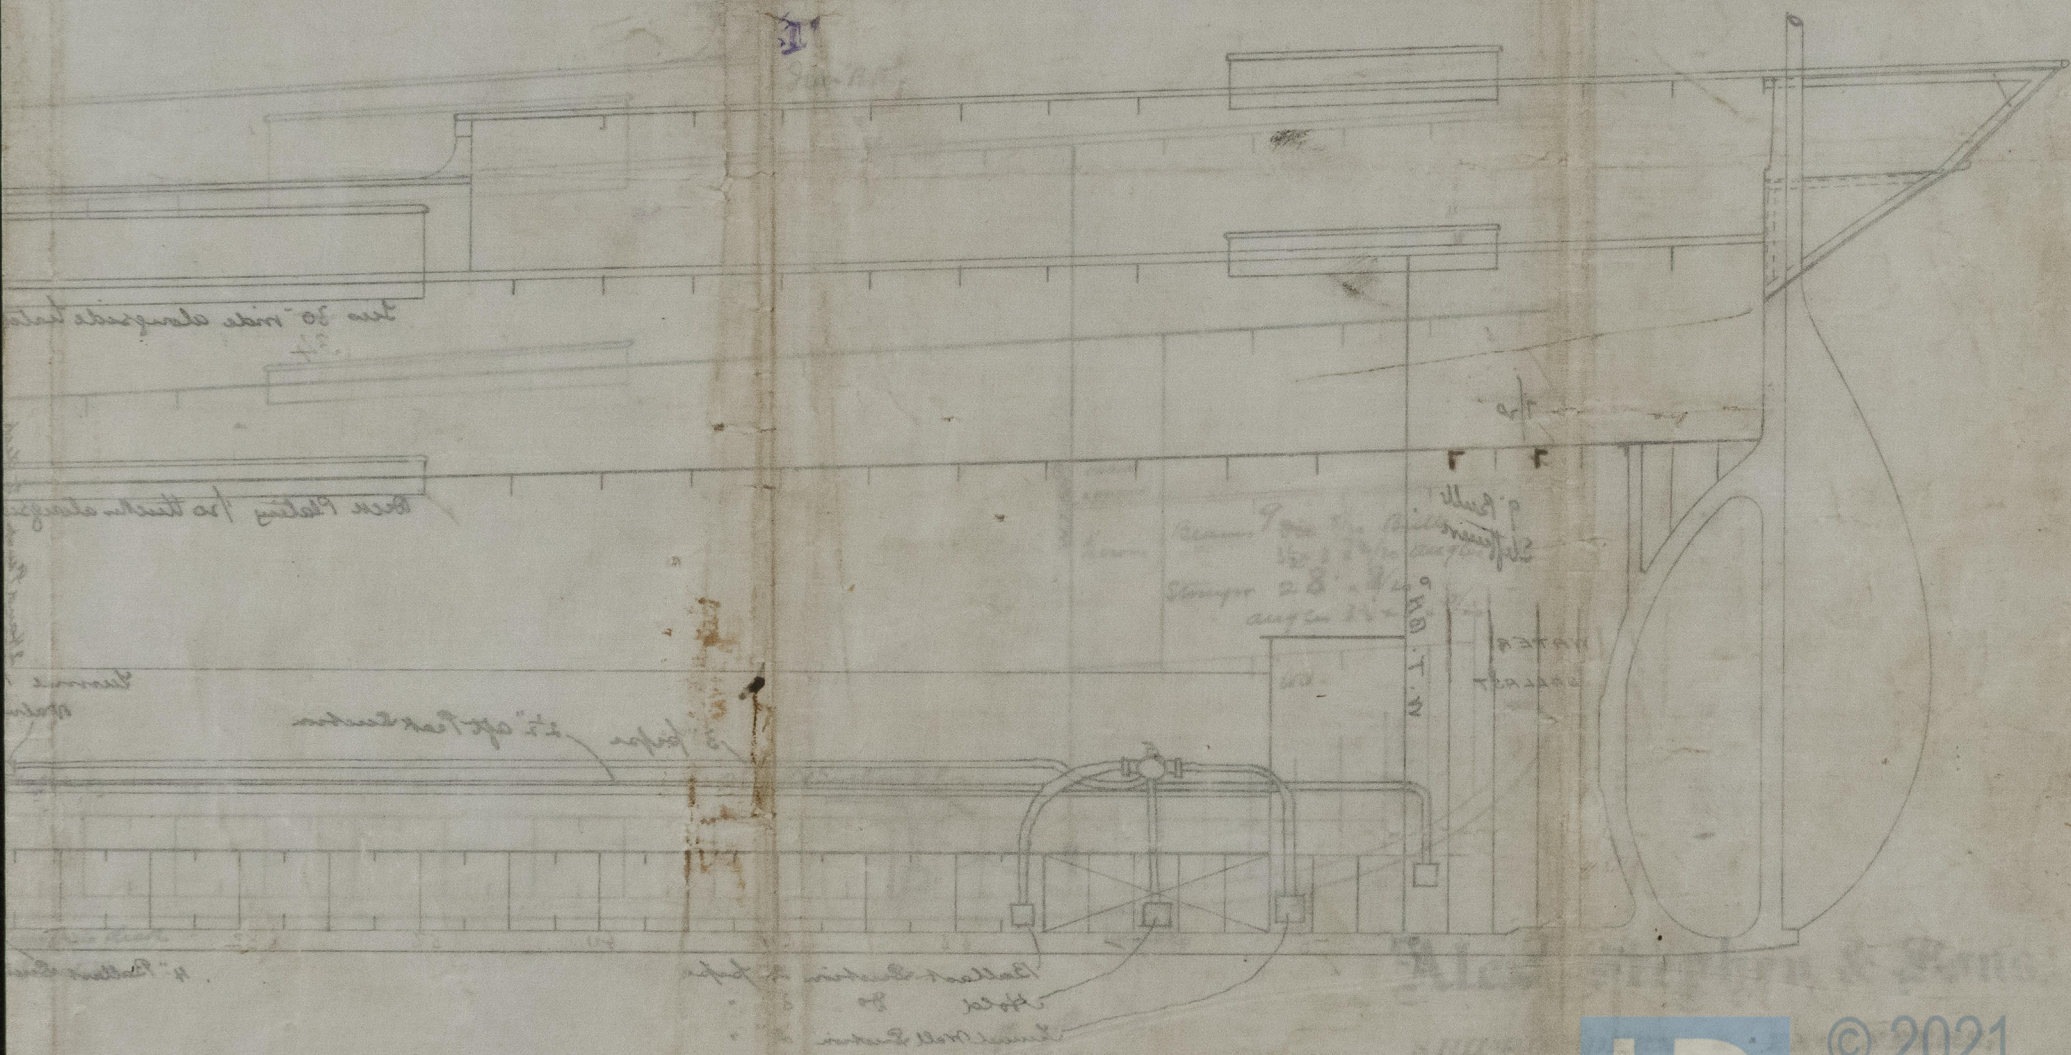

© 2021

Lloyd's Register
Foundation

GLS213-0099