


3-2514-0100

S. C. "Strathclyde" Glasgow Report No. 9048.

STEEL MASTS OF SCREW STEAMER

No 315

MON 1-OCT 88

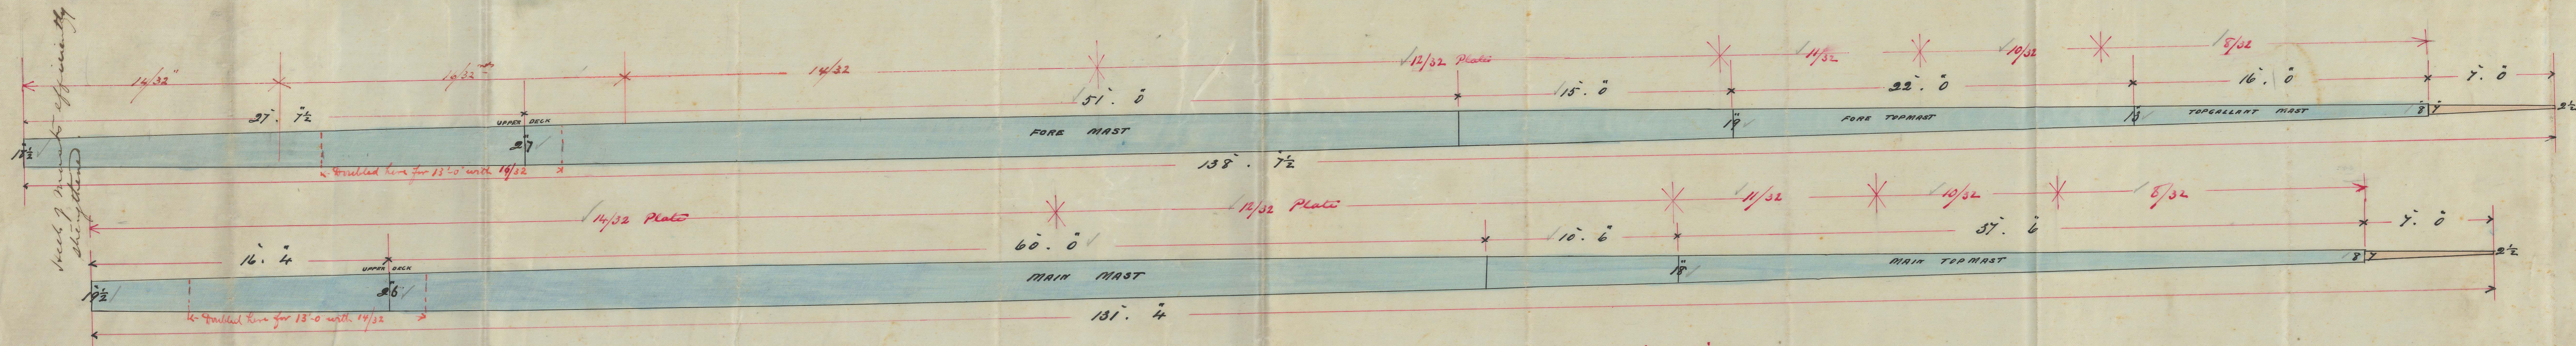

such 9 masts efficiently strengthened

Alex. Stephen & Sons,  
SHIPBUILDERS & ENGINEERS,  
GLASGOW

DRAWING No 4654

18/9/88

J. L. 26/9/88

Note - To have 2 Plates in the Round. The Landing edges Single Riveted  
all the Butts Strops to be thicker than the Plates they Connect and Double Riveted



