



9216 Glasgow

MIDSHIP SECTION

See Cr. to Gls.

OF

S.S. SOFIA formerly "AGNES FROM" & to be "DUNBRITTON."


MON 29 APR 89

SCALE 1/2 IN = 1 FOOT.

Glasgow Report
No. 9216.

Dimensions

Half Girth = 27.5 Depth to Length = 10.5
Half Breadth = 12.9 Breadth to Length = 7.9
Depth = 12.9
1st Numeral = 58.02
Length = 189.1
2^d Numeral = 109.58

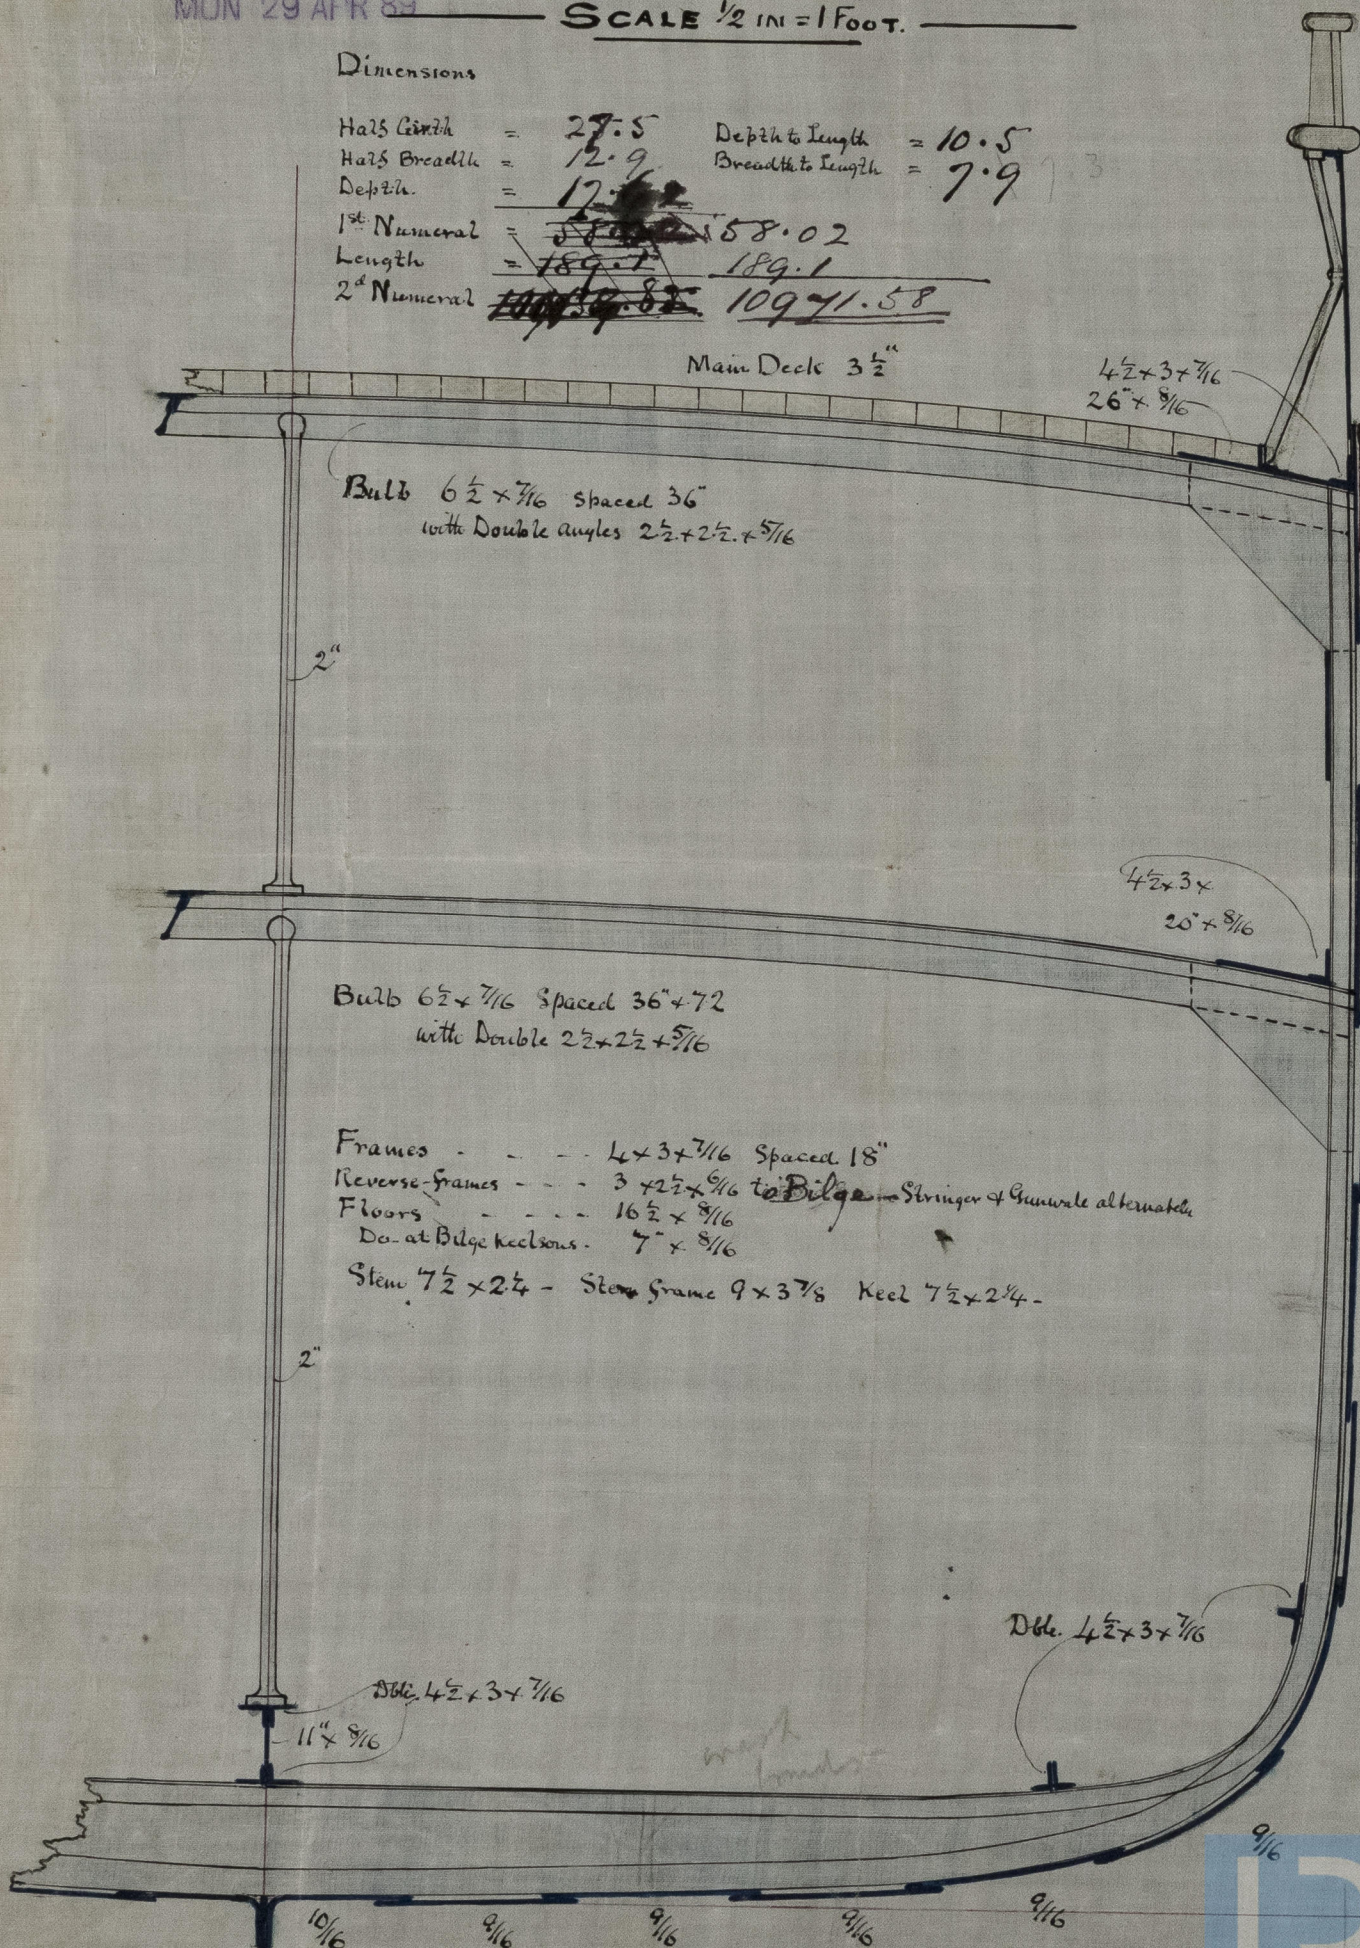


Doubled with 8 for half length
9/16



© 2021

Lloyd's Register
Foundation

GLS214-0060


 LLOYD'S POST OFFICE
 RECEIVED
 17 APR. 89
 LONDON

9216 yb

2.01
9.7

GLS 214-0060

