
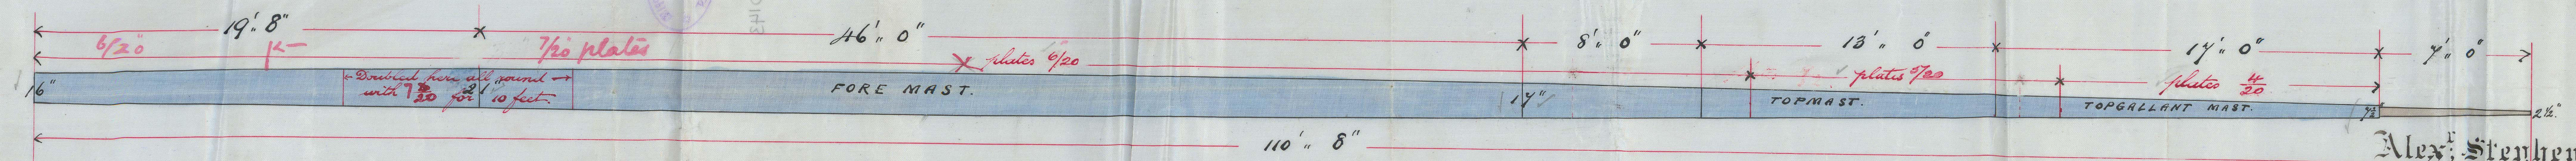


FRI 14 DEC 83

STEEL MASTS N° 320.

Steel of masts to be efficiently strengthened.

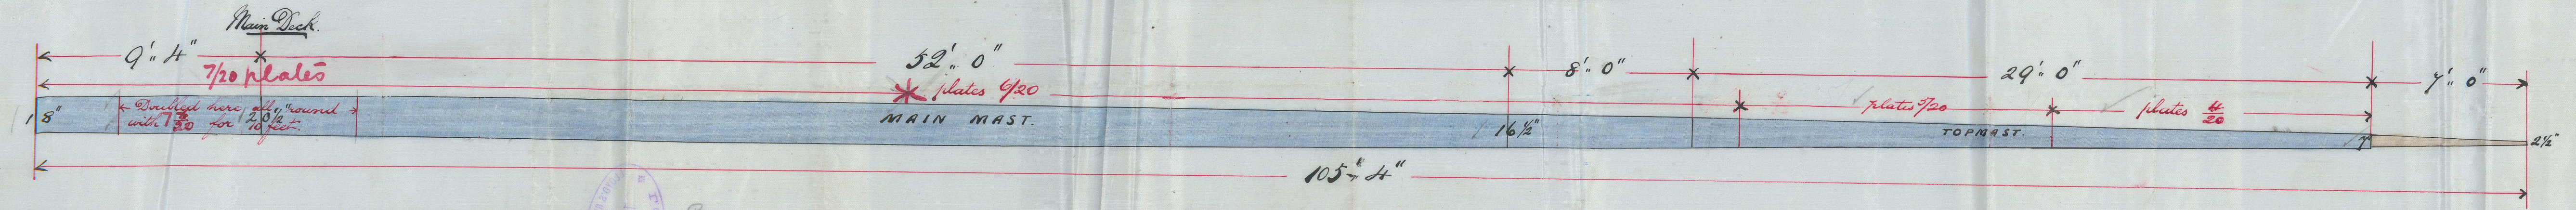

SCALE 1/4 INCH TO A FOOT

J.T.H.
14/12/88

✓ To have 2 plates in the round, the landings single riveted
 ✓ All the Butt Straps to be 20" thicker than the plates they connect and triple riveted.

Alex. Stephen & Sons,
 SHIPBUILDERS & ENGINEERS.

GLASGOW

J.T.H. 13/12/88 DRAWING N° 4449 6/12/88
 W.H.B.




© 2021

Lloyd's Register
 Foundation

Weld of masts to be efficiently strengthened.


FRI 14 DEC 88

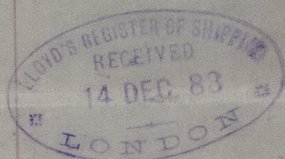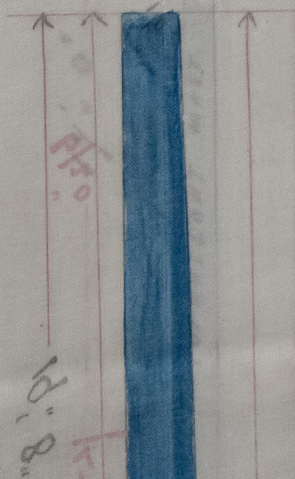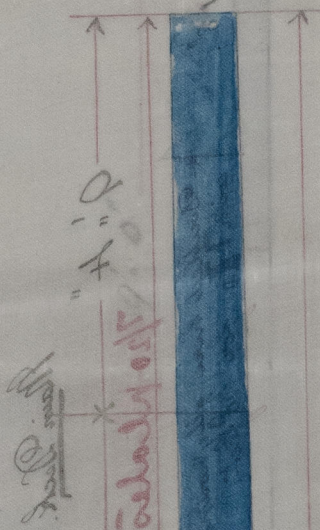

GLS215-0143

MASTS No 320

$28' 0''$
 $2' 0''$

$4' 0''$