


S. S. 'Mangara' Glasgow Report No

MON 23 SEP 88
SAT 20 OCT 88
THU 20 SEP 88

RECEIVED
115 SEP 88
LONDON

GLS215-0148

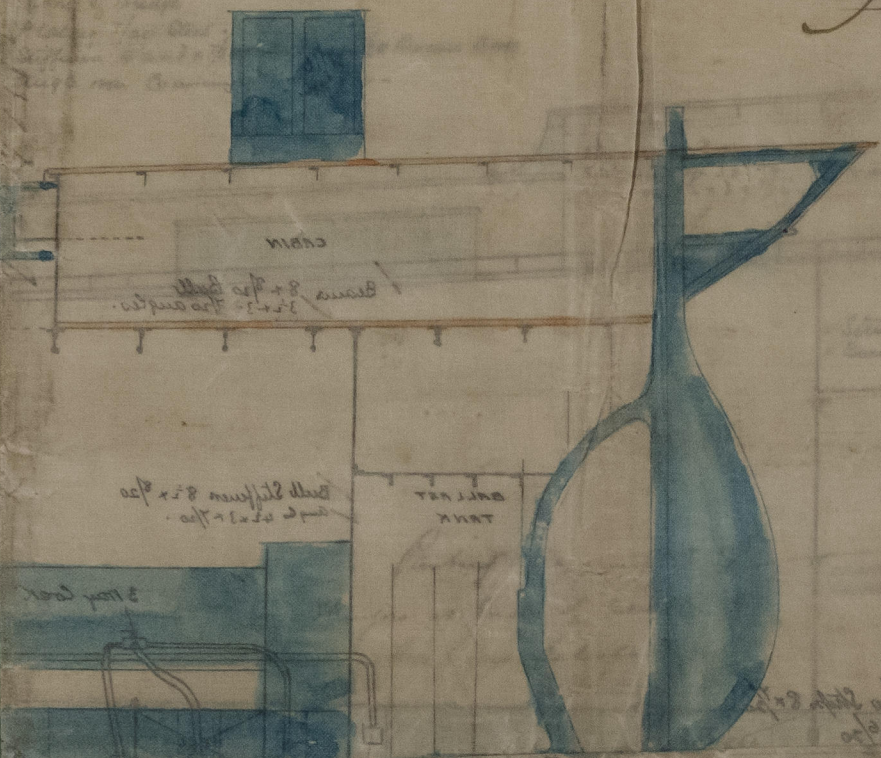






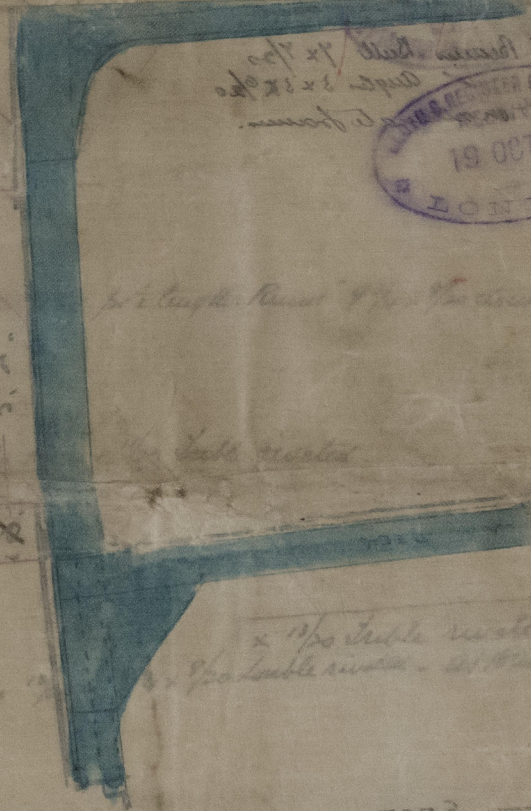

RECEIVED
19 OCT 88
LONDON

SECTION IN WAY OF FORECASTLE



© 2021

Lloyd's Register
Foundation