


[Faint handwritten notes and a circular library stamp are visible at the top of the page.]


Scale $\frac{1}{8}$ Inch = 1 Foot

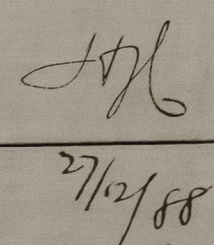

GLS215-0174

S. S. "Aiska" Glasgow Report N^o 9438.—
S. S. "Juba" — do — " 9561.—


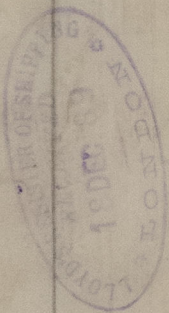




© 2021

Lloyd's Register
Foundation