

FRI 16 FEB 89


MIDSHIP SECTION
SCREW STEAMERS No 13 & 14
TO CLASS 100 A 1 STEEL
SCALE 1/2 INCH = 1 FOOT

Depth 13-0
1/2 Breadth 14-5
1/2 Girth 22-4 1/2
1st Number 49-94 + 188.6 = 9418.6
add 1/2 1177
10595

Proportions
Depth to Length 14.5
Breadth to 6.5

EQUIPMENT
2 Bower Anchors 12 cwt Ex Stock } Collective No 34 1/2 cwt
1 " " 10 " " " }
1 Stream " " 4 " " "
1 Kedge " " 2 " " "
1 " " 1 " " "
195 Fathoms 1 1/16 Stud Chain Cable
60 " " 1/16 Stream Chain or 3" Steel Wire
75 " " 8 1/2 Towline
90 " " 6 1/2 Hawser

1. Butt straps of Main Stringer Sheers & strake
and two strakes of Plating at bilges
2/10" thicker & riveted with 1/2" L
2. All other shell & stringer Butts double
riveted with Straps 2/10" thicker
3. Butts of sides of Shade Deck double riveted
4. Centre Keelson Vertical Butts double riveted
with double 1/10" straps
5. Rider Plate Butts double riveted with
single 1/10" straps
6. Noze - Rivets in Butts of Outside
Plating & Deck Stringer plates spaced
not more than 3 1/2 dia apart
7. Centre to Centre

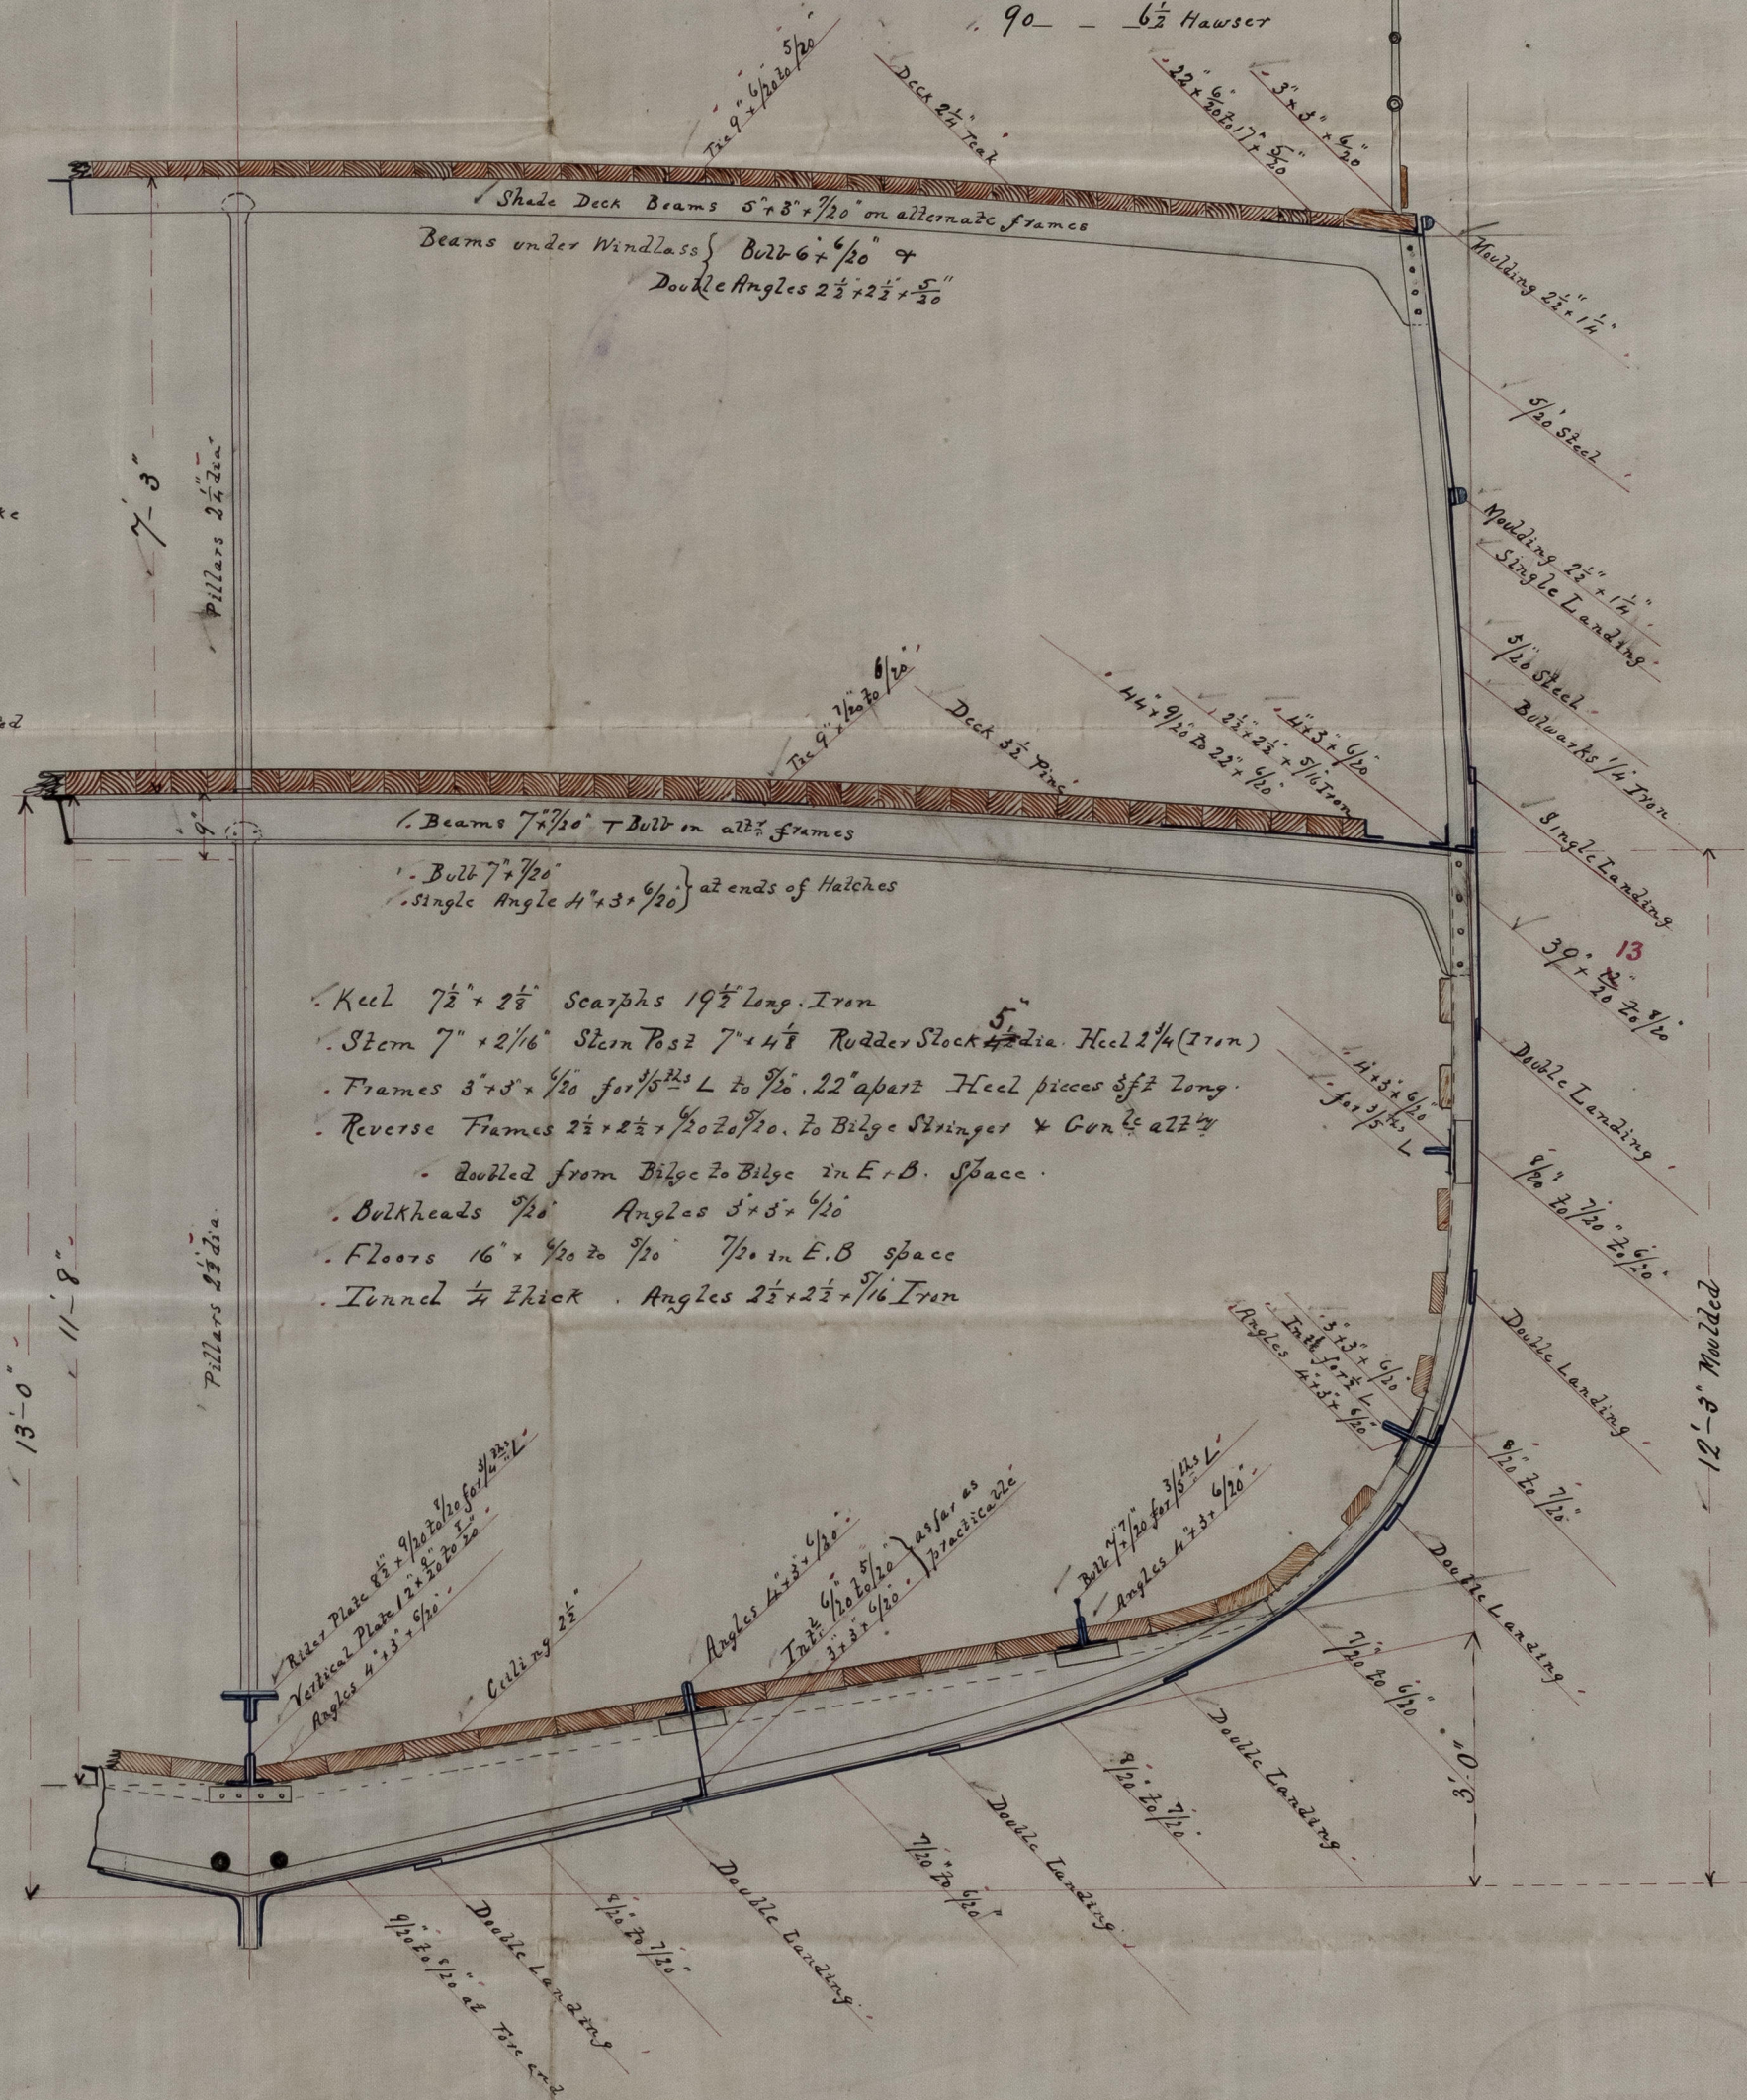

157/89

J. L. 12/2/89



Lloyd's Register
Foundation

GLS215-0175