

# Lloyd's Register of British and Foreign Shipping.

(Report on Vessel No. 9438 Port Glasgow)

S.S. "Aska."

No. 2076

## SHIP FORGINGS OR CASTINGS.

I have to report that the undermentioned ~~Iron or Steel~~ Forgings or Castings, manufactured by

The Irvine Forge Co of Irvine.

for the Vessel No. 13, being built by The Ailsa S.B. Co

of Groon have been inspected by me as set forth below, and found to be, so far as can be seen, sound and efficient.

Mark on Forgings.

Lloyd's

No. 2076

G.N


George Newcomb

Glasgow

28/5/89

	STERN FRAME.	RUDDER FRAME.	STEM & Keel
Material*	<u>Scrap iron</u>	/	<u>Scrap iron</u>
How made	<u>Forged,</u>		<u>Forged</u>
Dimensions	<u>7 x 4 1/8</u>		<u>Stem 7 x 2 1/8 Keel 7 1/2 x 2 1/8</u>
Progress on Inspection	<u>Forging &amp; smithing</u>		<u>Forging</u>
Dates when Inspected	<u>25/4/89. 10.15.21/5/89</u>		<u>31/1/89. 7.14/2/89.</u>

SKETCHES OF FRAMES SHEWING POSITION AND DESCRIPTION OF WELDS OF FORGINGS, OR PARTICULARS OF TESTS APPLIED TO CASTINGS.

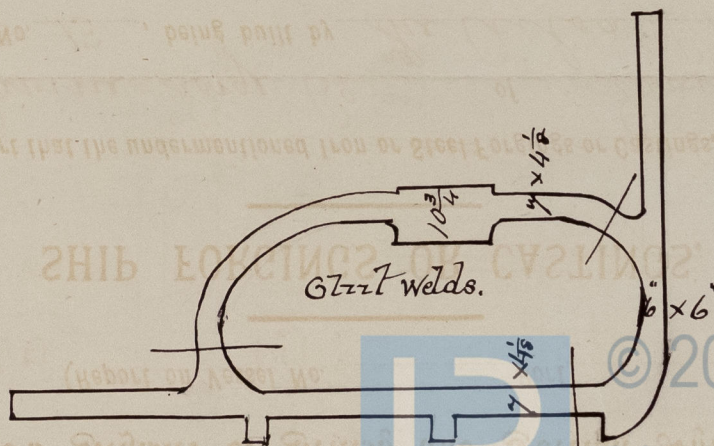

\* If of Iron, state whether scrap or puddled Iron.