

Steel

# S. S. N<sup>o</sup> 140


YMD: 11 OCT 88

MON 26 NOV 88


**DIMENSIONS 350' x 40' x 28' FLOORS**

**CLASS 100 A SPAR DECK.**

SCALE  $\frac{1}{2}$  INCH = 1 FT.

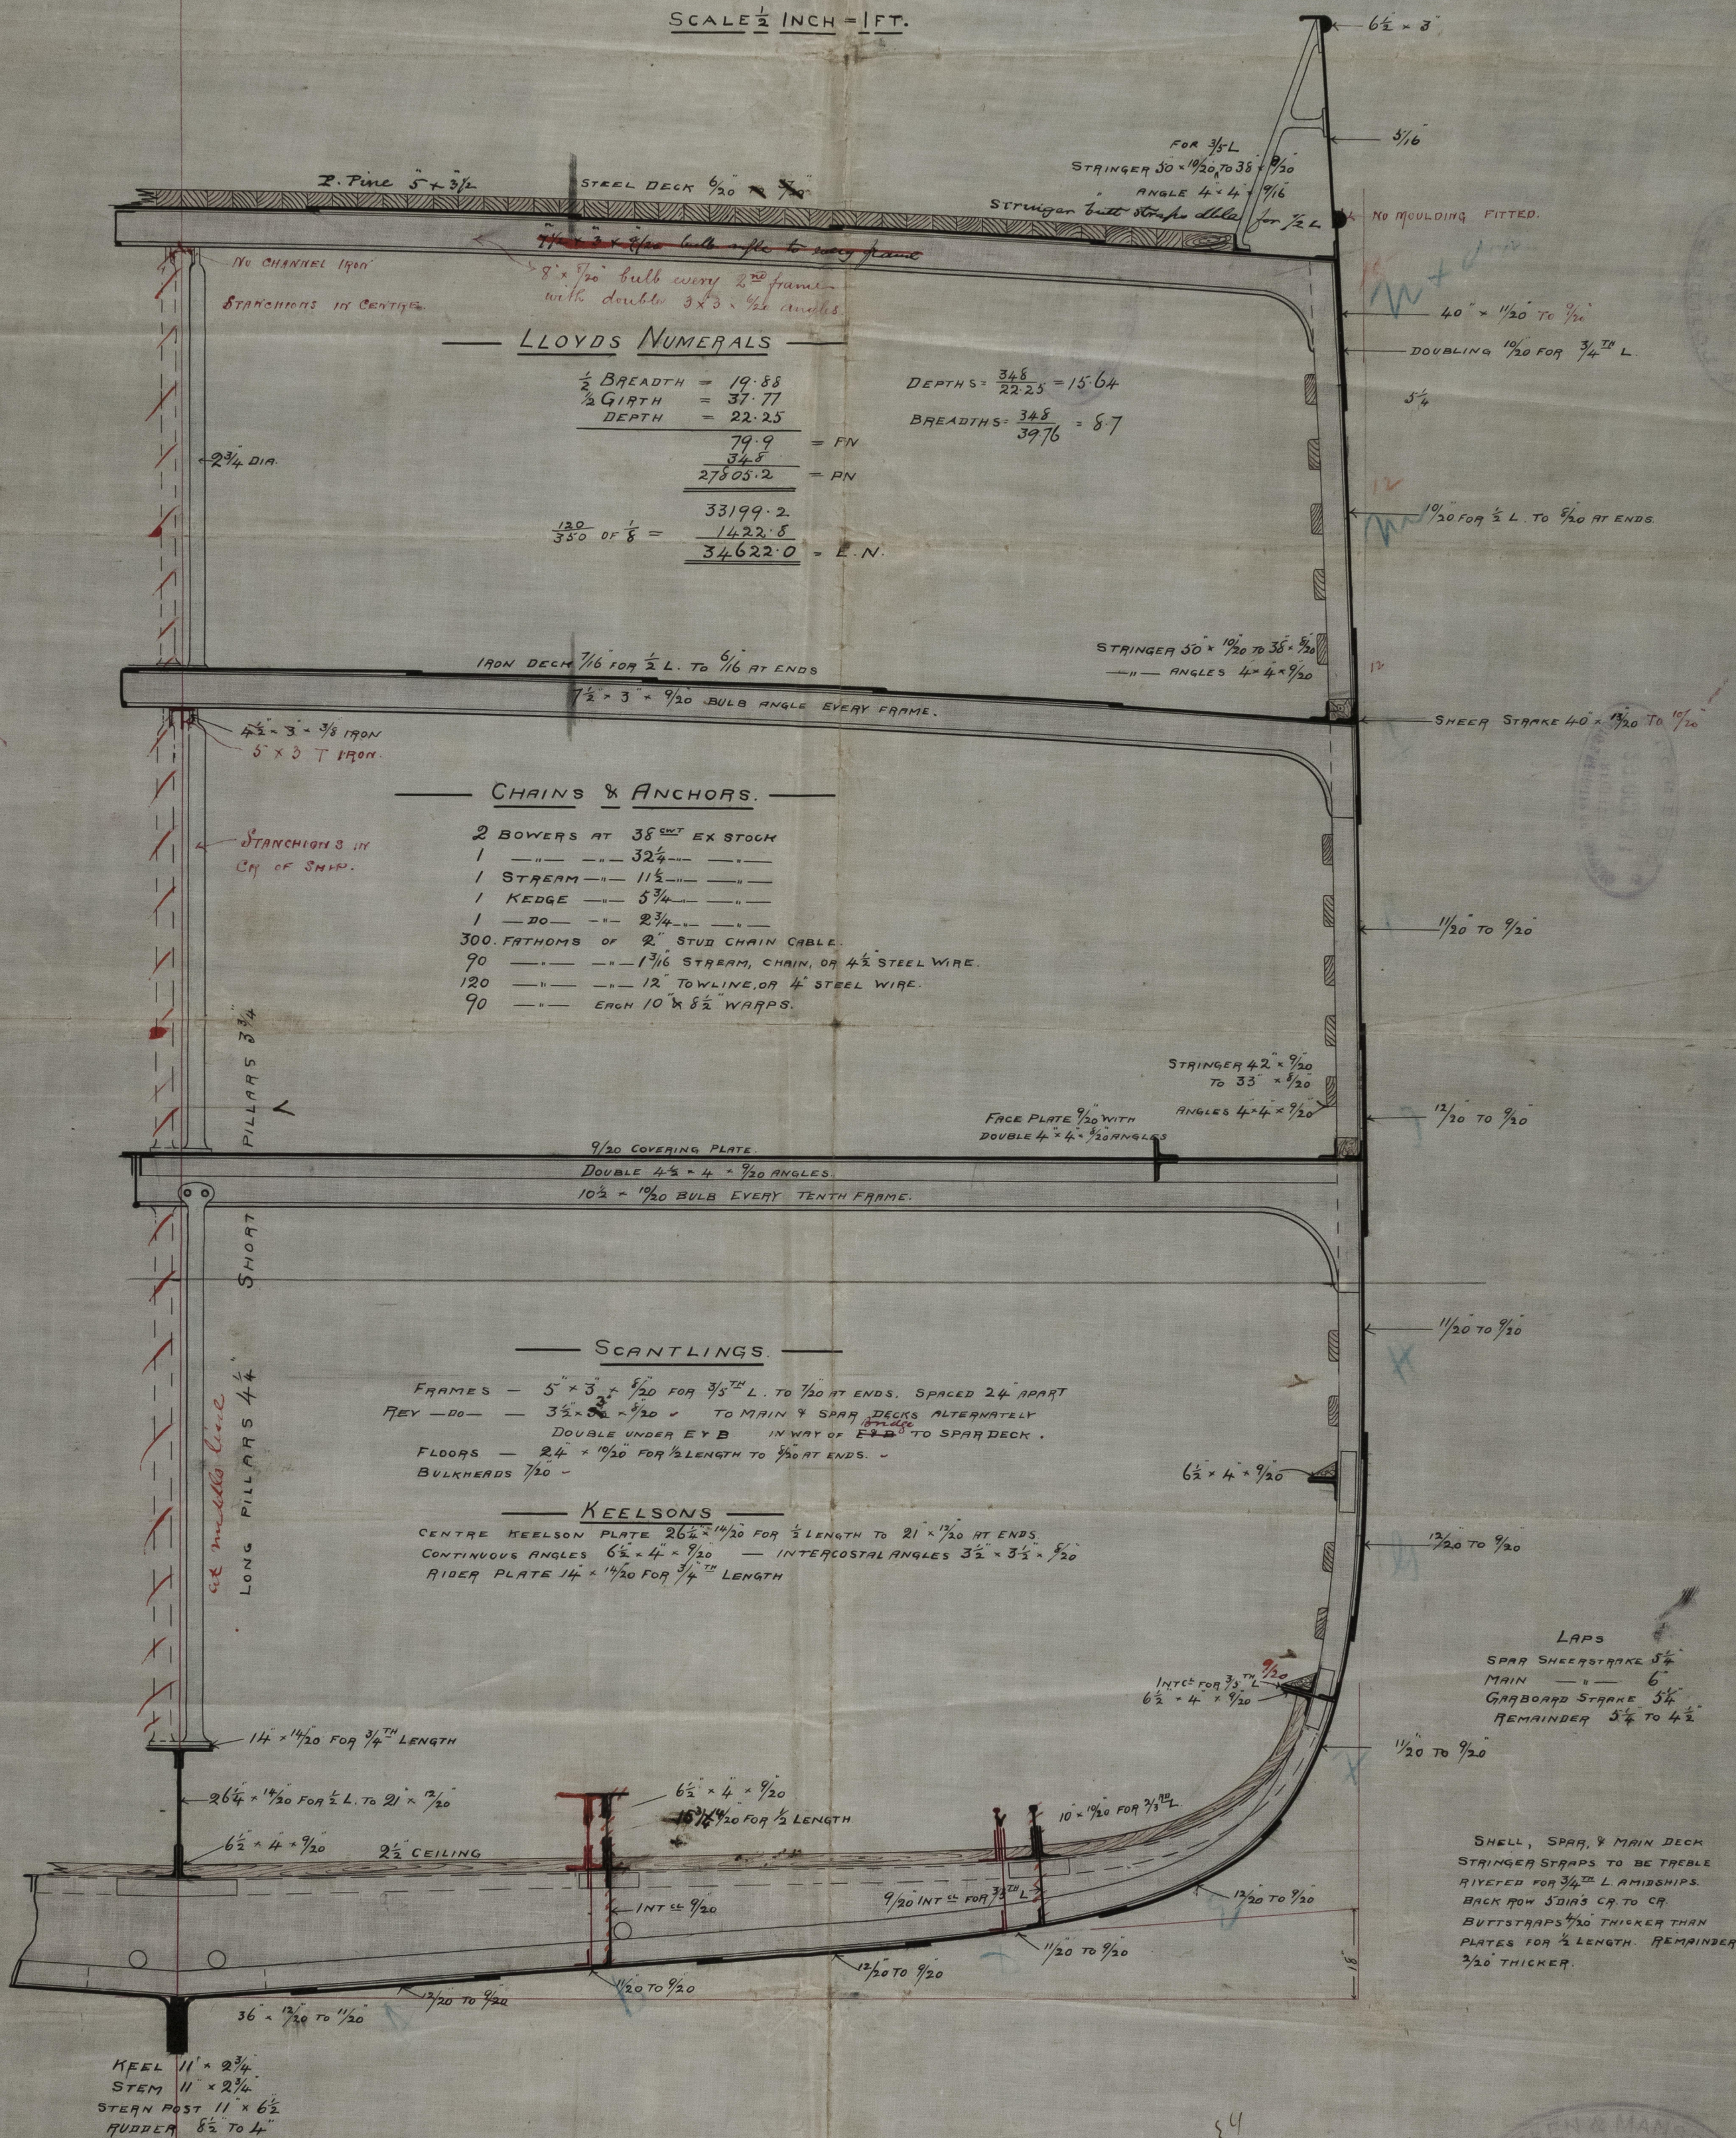


STL 1800  
9/10/88

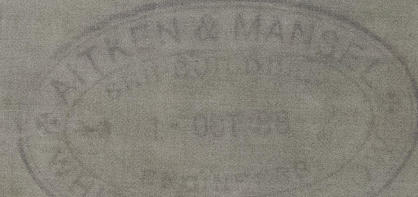






S. S. "Meira" Glasgow Report No. 9518.

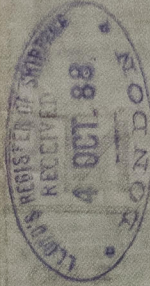

40  
DIMENSIONS  

NOV 18 1888

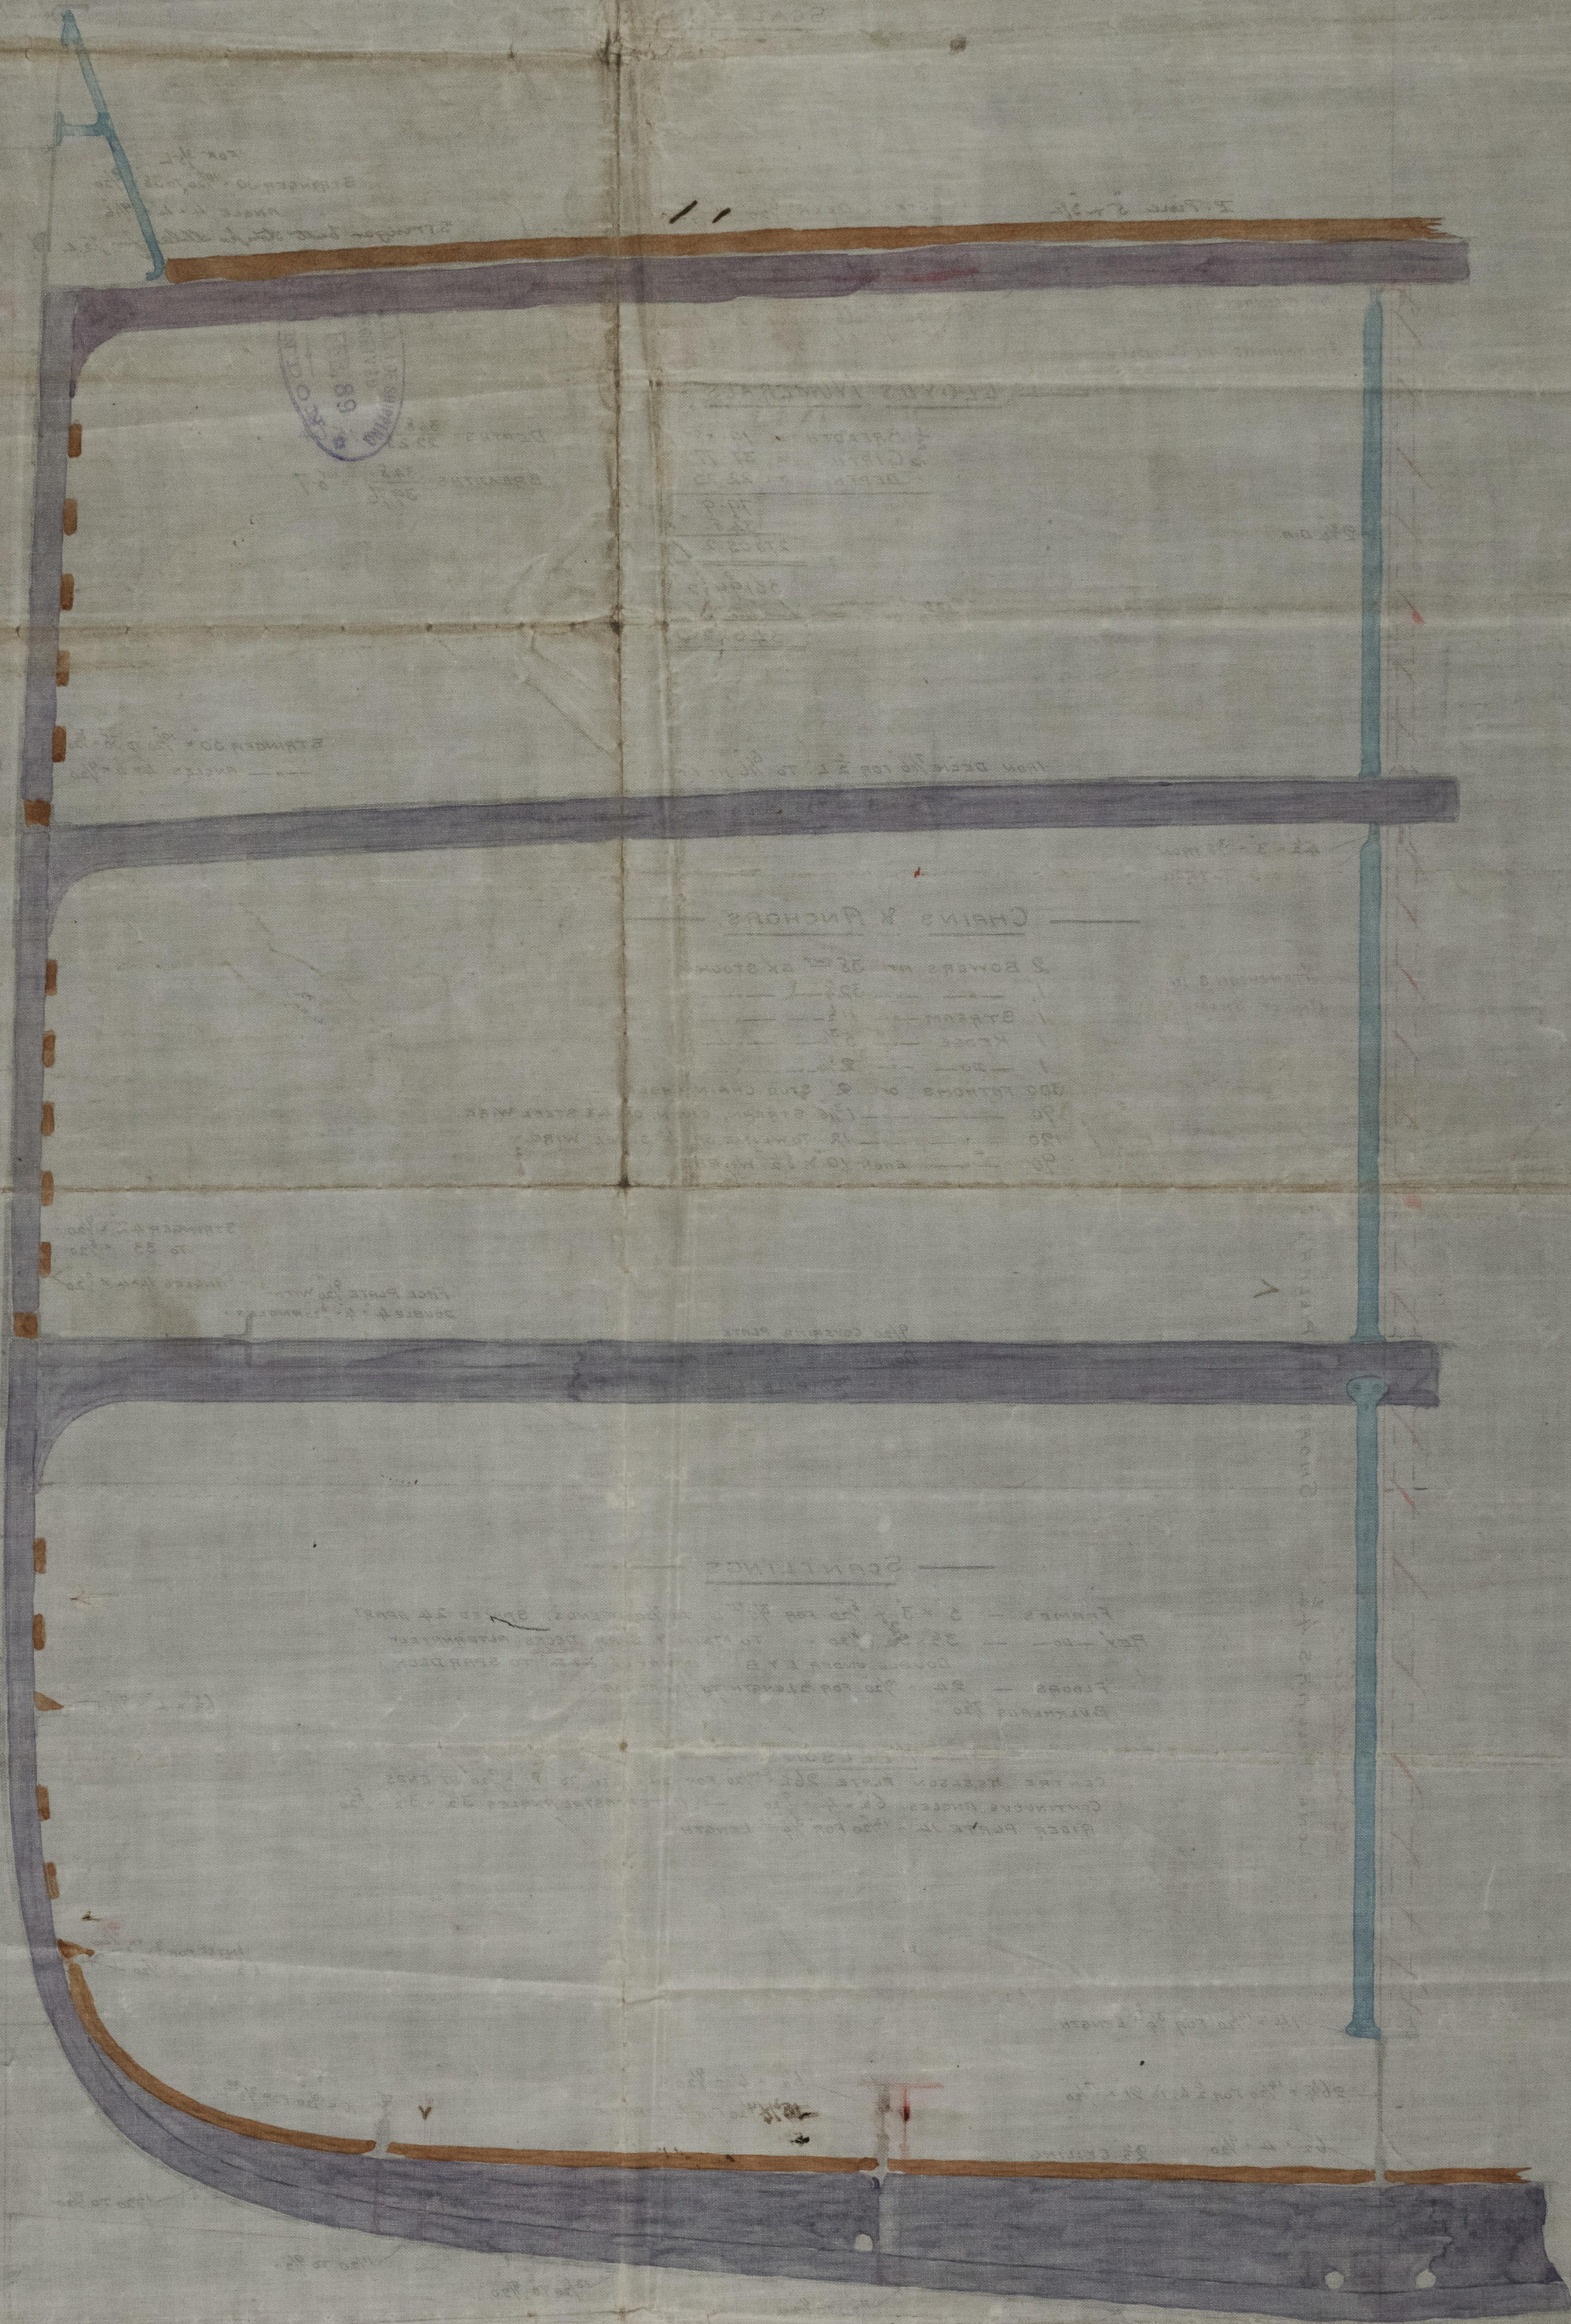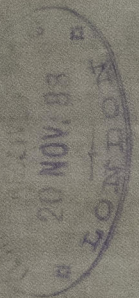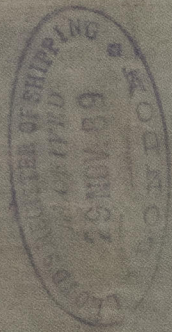

© 2021

Lloyd's Register  
Foundation