


WED 31 OCT 88

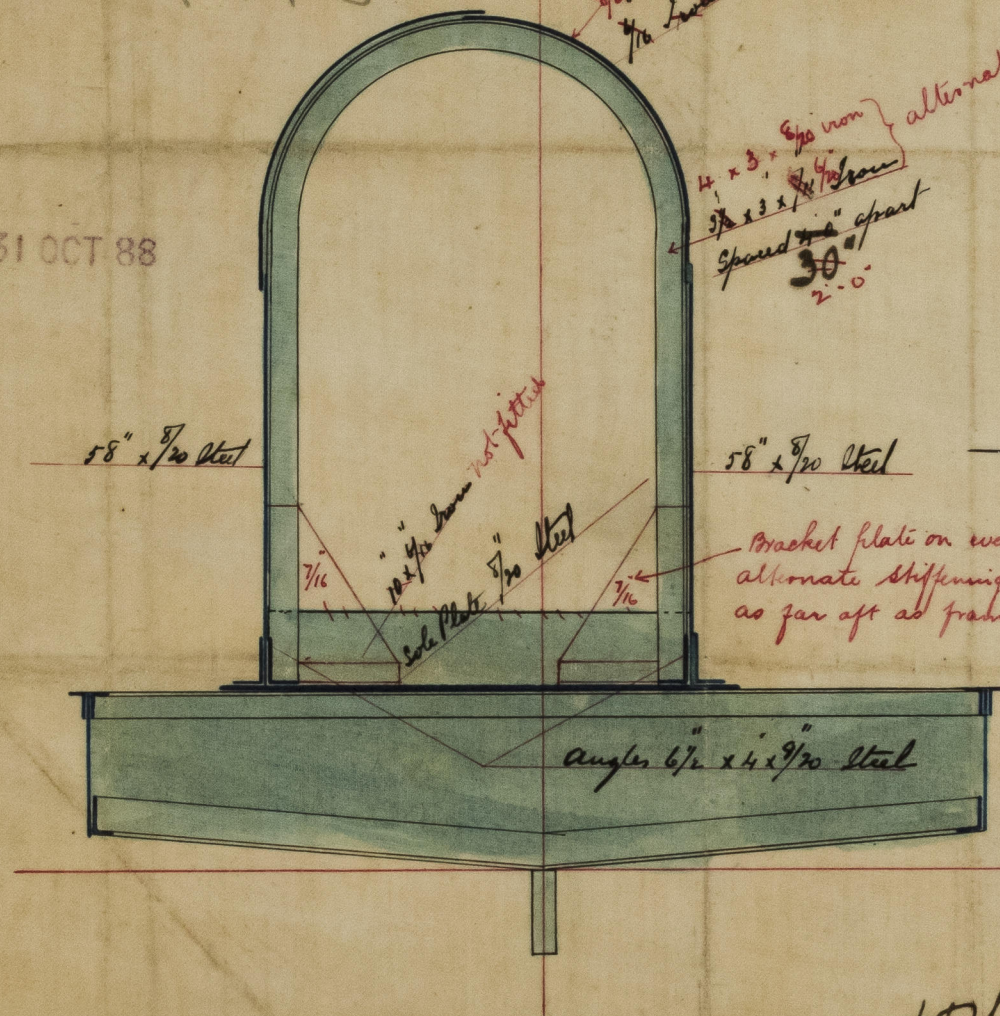

N<sup>o</sup> 140  
Section of Tunnel  
showing compensation at  
Sides & Bottom in view of  
Centre Keelson  
Scale 1/2" = 1 foot



J.H.  
31/10/88



Lloyd's Register  
Foundation



LLOYD'S REGISTER OF SHIPPING  
RECEIVED  
31 OCT. 83  
LONDON

WED 31 OCT 88

Scale  $\frac{1}{2}$  = Foot  
Section of Tunnel

28/10/88

© 2021

Lloyd's Register  
Foundation

45216-0082