

Lloyd's Register of British and Foreign Shipping.

(Report on Vessel No. 9518 Port Glasgow)
S.S. "Mira."

No. 1951 SHIP FORGINGS OR CASTINGS.

The words FORGINGS or CASTINGS, IRON or STEEL, should be struck out as may be required.

I have to report that the undermentioned Iron or Steel Forgings or Castings, manufactured by Messrs Beardmore & Co of Glasgow for the Vessel No. 140, being built by Messrs Bigham & Mansel of Glasgow have been inspected by me as set forth below, and found to be, so far as can be seen, sound & efficient


Mark on Forgings.

Lloyd's
No. 1951
WH

William Hamilton
Glasgow
30/8/89

	STERN FRAME.	RUDDER FRAME.	STEM.
Material*	/	Scrap iron	/
How made		Forged	
Dimensions		8 1/2 dia	
Progress on Inspection .		Forging & smithing	
Dates when Inspected		20/8/89, 6.11/6/89, 5.9.10.22 25.31/7/89, 14.19.20.23.26.28.29/8/89	

SKETCHES OF FRAMES SHEWING POSITION AND DESCRIPTION OF WELDS OF FORGINGS, OR PARTICULARS OF TESTS APPLIED TO CASTINGS.

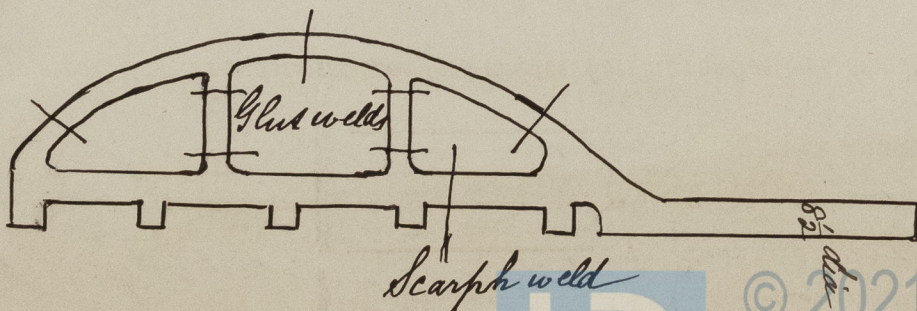

© 2021

Lloyd's Register
Foundation